BENCH MARK: "□" V – NOTCH IN CENTERLINE OF McCORMICK
40' N. OF NORTHWEST CORNER OF GOEBEL BROS. 4TH ADDITION.
ELEV. = 113.59 CITY DATUM

SCALE
PLAN 1" = 40'
PROFILE 1" = 40' HORZ.
1" = 5' VERT.

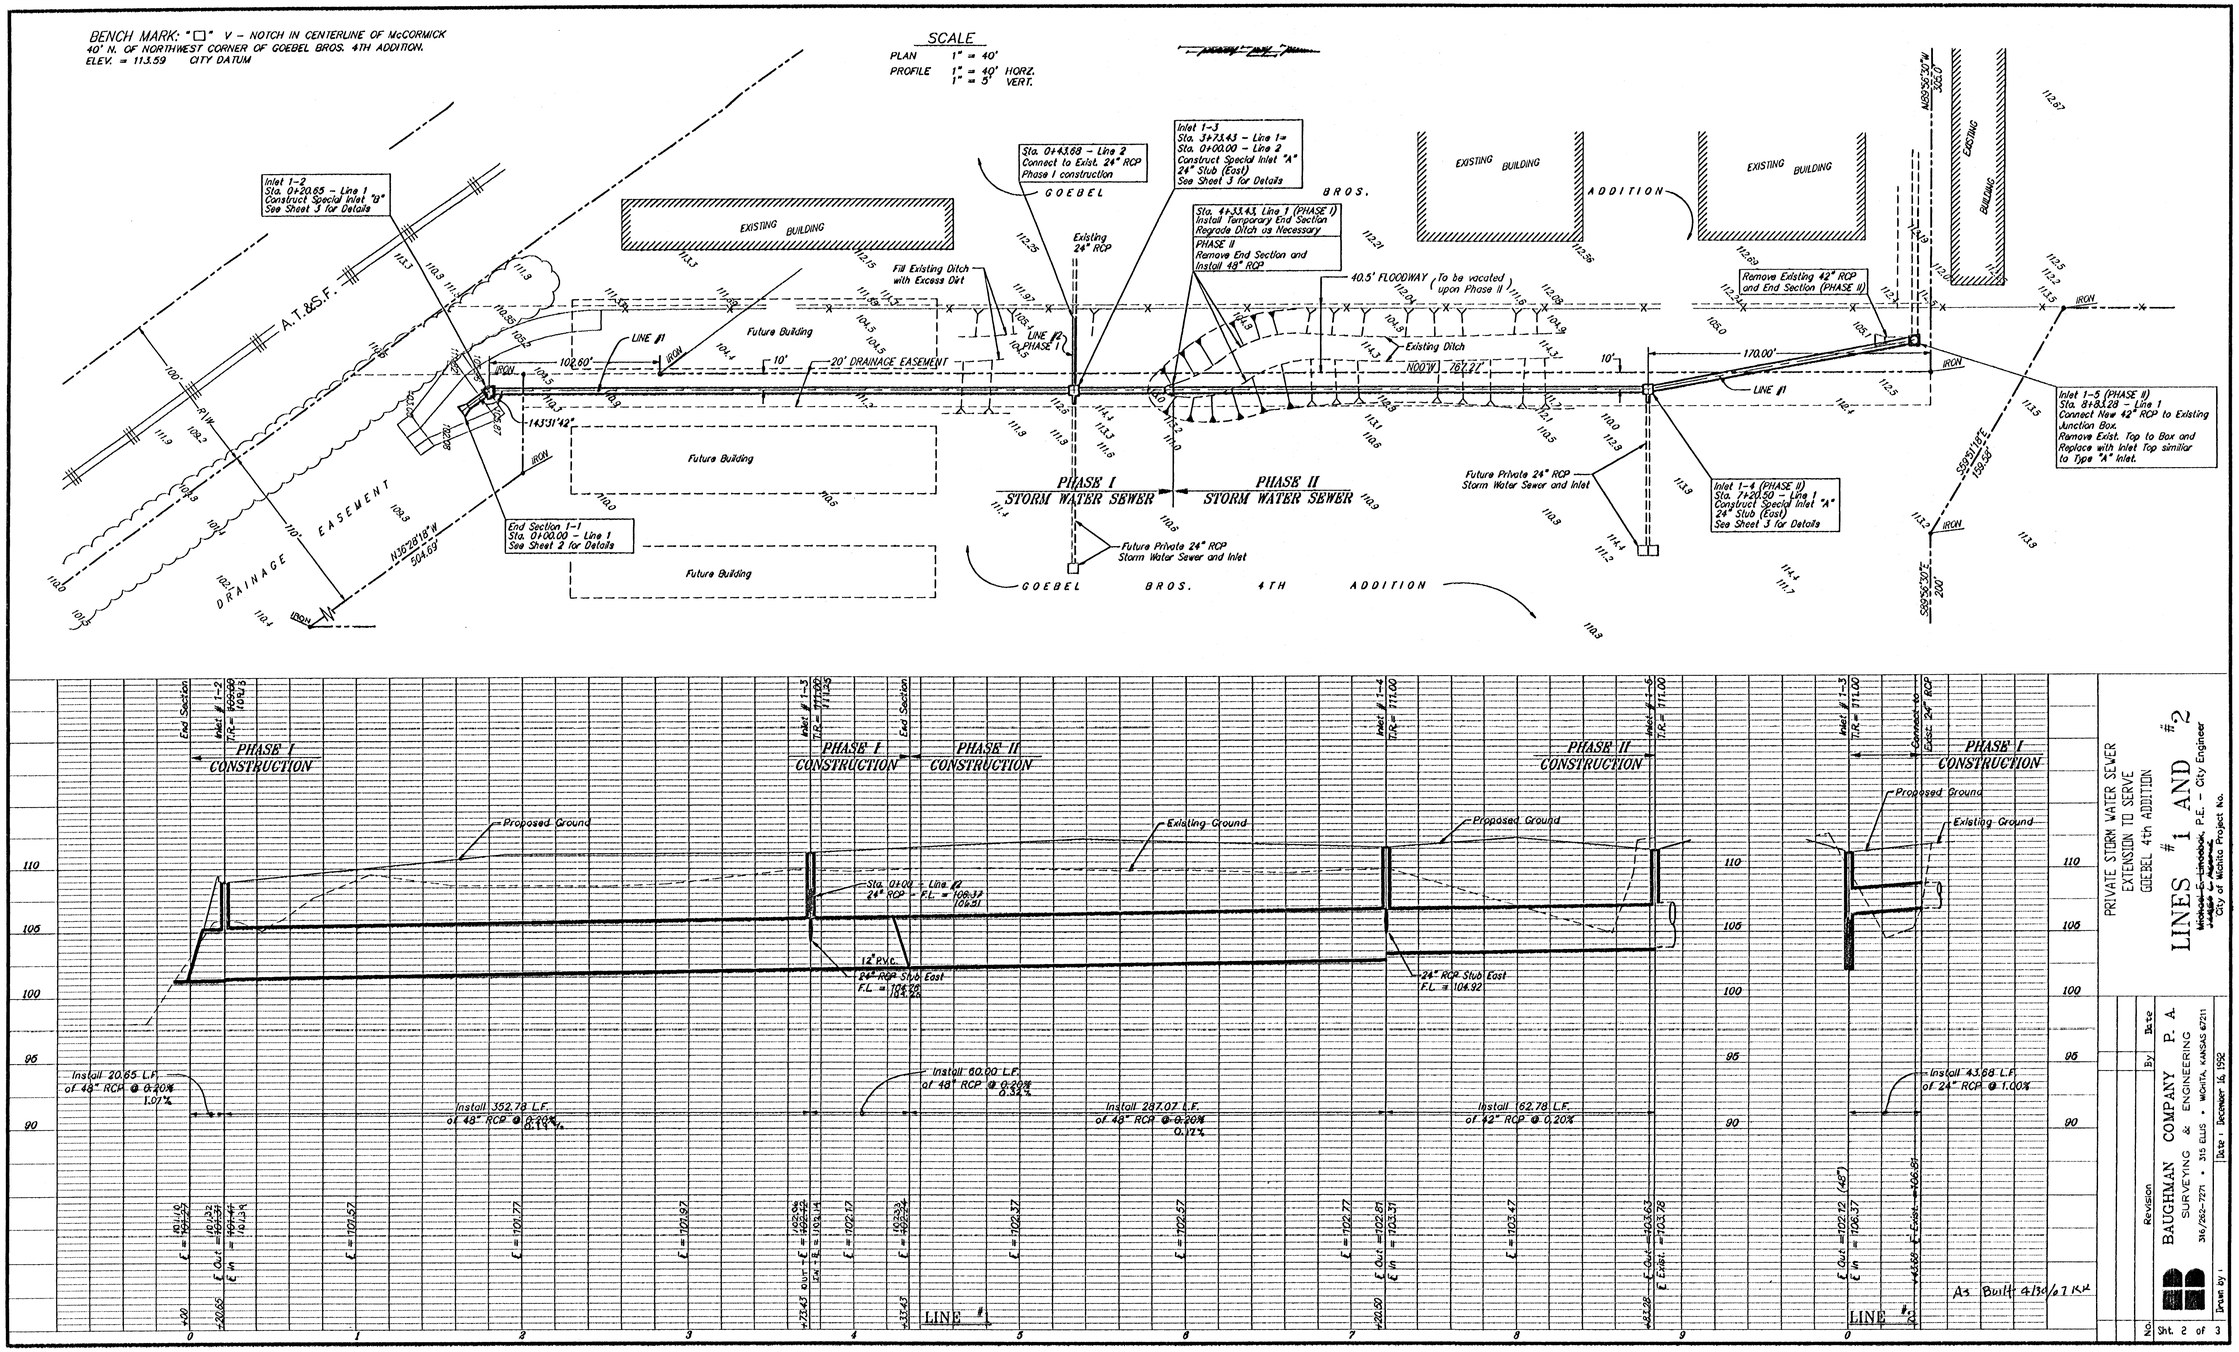

PRIVATE STORM WATER SEWER
EXTENSION TO SERVE
GOEBEL 4th ADDITION

LINES #1 AND #2

~~Michael E. Lindebak~~, P.E. – City Engineer
~~Jack C. Adams~~
City of Wichita Project No.

No.	Revision	By	Date

BAUGHMAN COMPANY P. A.
SURVEYING & ENGINEERING
316/262-7271 • 315 ELLIS • WICHITA, KANSAS 67211

Sht. 2 of 3
Drawn by:
Date: December 16, 1992