

BENCHMARK:
"□" CUT ON TOP OF CURB
AT WEST LINE OF LOT 7,
BLOCK A, AUBURN HILLS 5TH
ADD.
ELEV. = 1395.13 NGVD29

DISC IN BACK OF CURB,
NORTH OF FRONT CORNER
COMMON TO LOTS 23 AND 24,
BLOCK D, AUBURN HILLS 12TH
ADD.
ELEV. = 1379.24 NGVD29

"□" CUT ON CENTER OF
CATCH BASIN, NORTH OF LOT
CORNER COMMON TO LOTS 1
AND 15, BLOCK B, AUBURN
HILLS 14TH ADD.
ELEV. = 1381.05 NGVD29

Existing Pond Data:
Static WS elev. = 197.0
100-yr WS elev. = 200.8

Sta 0+04, Begin Line 3
Begin construction of 24"
RCP with end section
14 S.Y. heavy stone rip-rap


Contractor shall remove and
replace existing barbed wire
fence as necessary. Cost to
be included in "Site Clearing
and Restoration"

SAVINA, RICHARD K ETAL
14901 W. MAPLE
WICHITA, KS 67235-8700

AUBURN HILLS
16TH ADDITION

Sta 1+60.4, End Line 3
Construct std. type 1A
inlet (10'x3')
1 - 18" Stub (SE) w/ plug
Top Elev. = 206.0

Scale: 1" = 20' Horizontal
1" = 5' Vertical
• = Iron

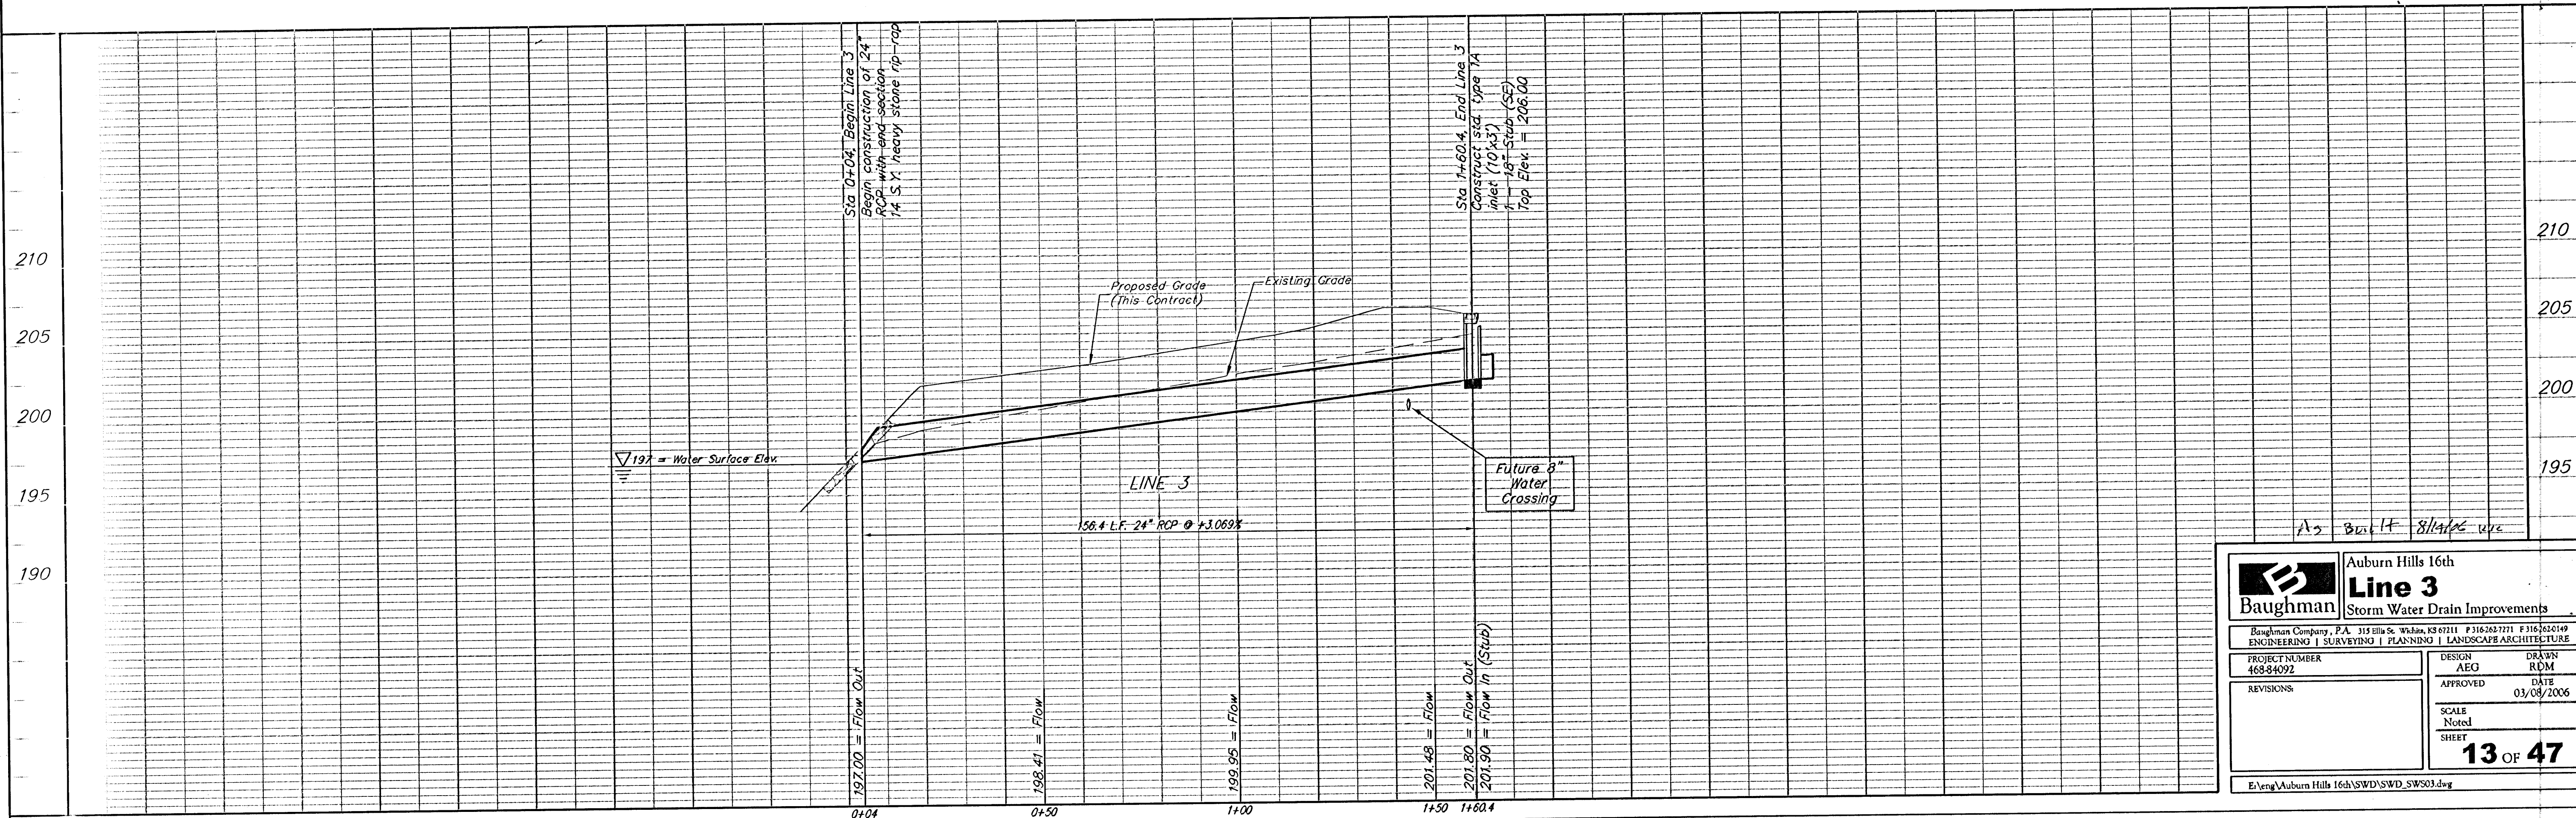

Baughman		Auburn Hills 16th Line 3 Storm Water Drain Improvements	
Baughman Company, P.A. 315 Ellis St. Wichita, KS 67211 P 316-262-7271 F 316-262-149 ENGINEERING SURVEYING PLANNING LANDSCAPE ARCHITECTURE			
PROJECT NUMBER 468-84092	DESIGN AEO	DRAWN RDM	DATE 03/08/2006
REVISIONS:	APPROVED	SCALE Noted	SHEET 13 OF 47
E:\eng\Auburn Hills 16th\SWD\SWD_SW303.dwg			