

BENCHMARK:
"□" CUT ON TOP OF CURB
AT WEST LINE OF LOT 7,
BLOCK A, AUBURN HILLS 5TH
ADD.
ELEV. = 1395.13 NGVD29

DISC IN BACK OF CURB,
NORTH OF FRONT CORNER
COMMON TO LOTS 23 AND 24,
BLOCK D, AUBURN HILLS 12TH
ADD.
ELEV. = 1379.24 NGVD29

"□" CUT ON CENTER OF
CATCH BASIN, NORTH OF LOT
CORNER COMMON TO LOTS 1
AND 15, BLOCK B, AUBURN
HILLS 14TH ADD.
ELEV. = 1381.05 NGVD29

Remove trees only as necessary
for construction and only with
permission of Developer or
Baughman Co. Cost of removal
to be incidental to lump sum
bid item "Site Clearing &
Restoration".

Existing Pond Data:
Static WS elev. = 197.0
100-yr WS elev. = 200.8


Sta 0+00, Begin Line 4
Begin construction of 30"
RCP with end section
18 S.Y. heavy stone rip-rap

Sta 0+92.6, End Line 4
Construct std shallow
Type P manhole (5' dia.)
1 - 30" Stub (S) w/ plug
Top Elev. = 202.80

Contractor shall remove and
replace existing barbed wire
fence as necessary. Cost to
be included in "Site Clearing
and Restoration".

SAVINA, RICHARD K ETAL
14901 W. MAPLE
WICHITA, KS 67235-8700

Scale: 1" = 20' Horizontal
1" = 5' Vertical
• = Iron

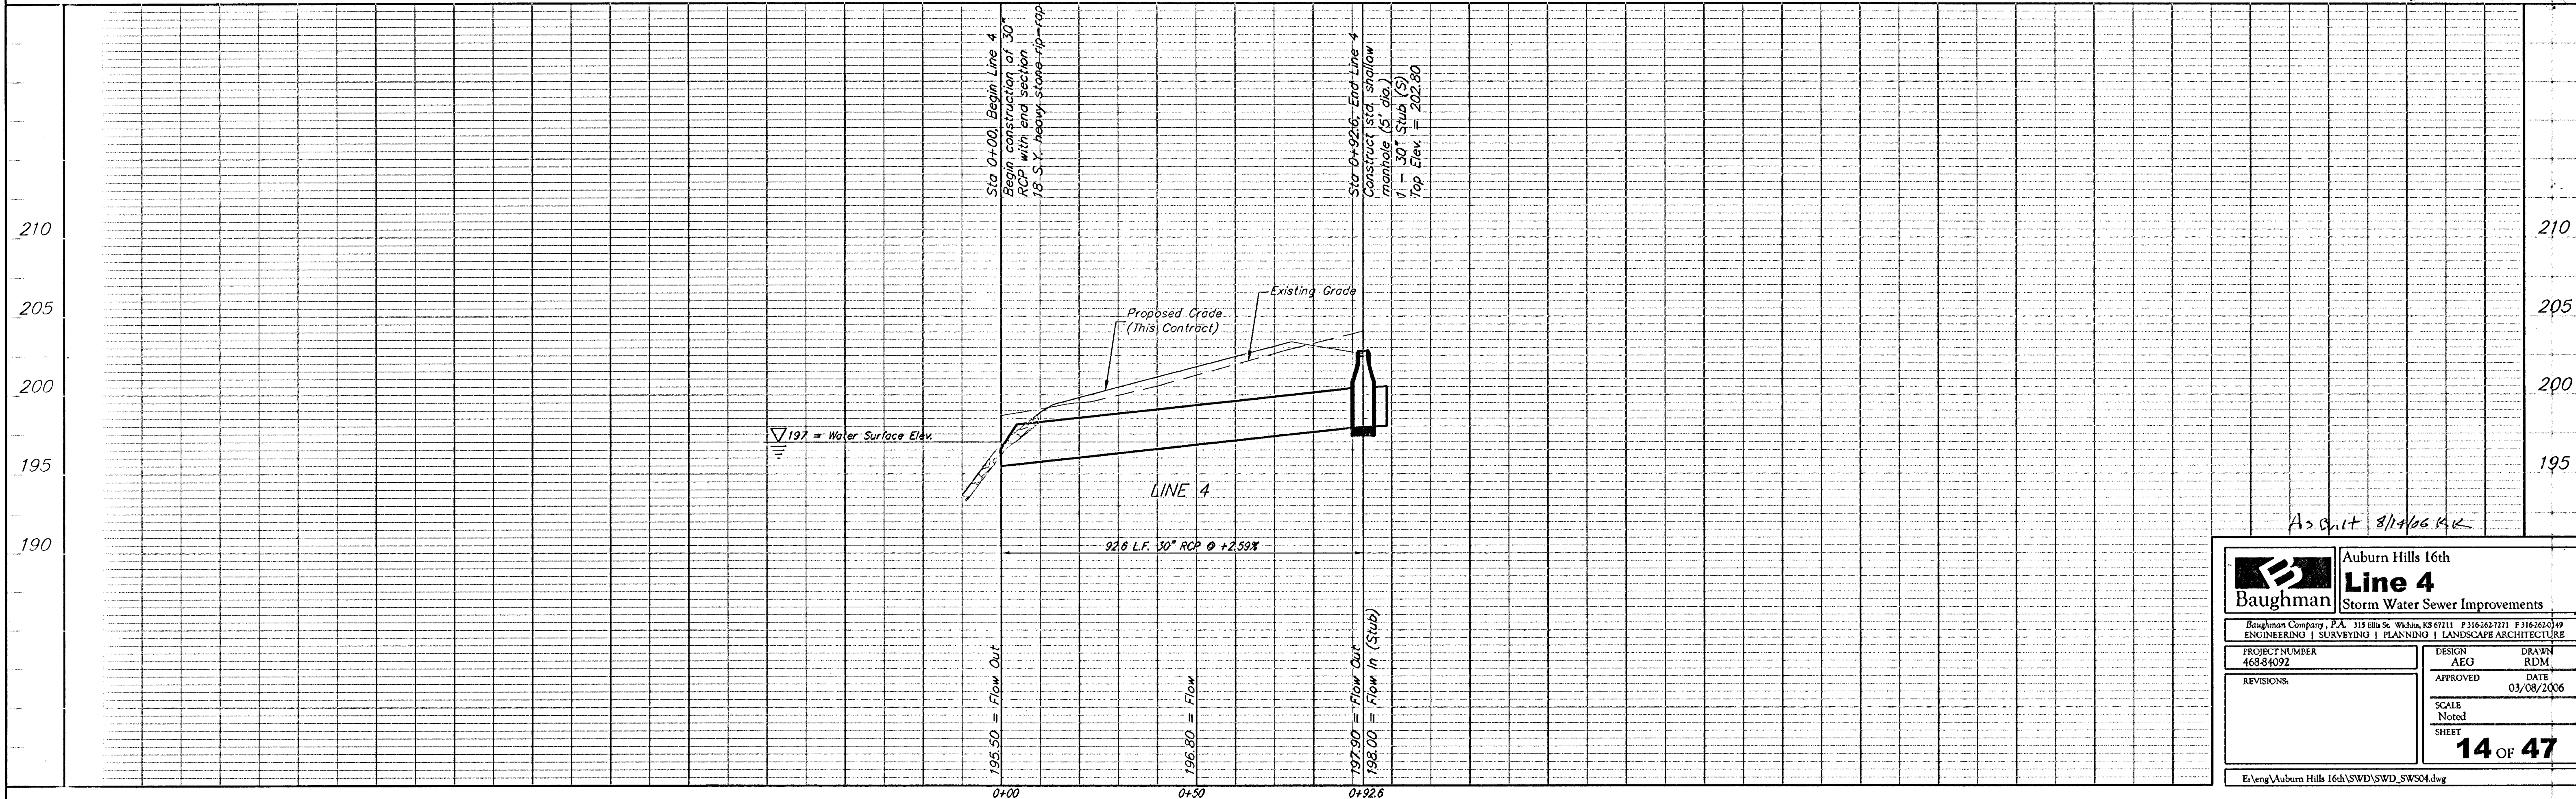

Baughman		Auburn Hills 16th Line 4 Storm Water Sewer Improvements	
Baughman Company, P.A. 315 Ellis St. Wichita, KS 67211 P 316-262-7221 F 316-262-0149 ENGINEERING SURVEYING PLANNING LANDSCAPE ARCHITECTURE			
PROJECT NUMBER 468-64092		DESIGN AEG	DRAWN RDM
REVISIONS:		APPROVED DATE 03/08/2006	SCALE Noted SHEET 14 OF 47
E:\eng\Auburn Hills 16th\SWD\SWD_SW504.dwg			