

CONSTRUCTION NOTES

New signal heads and signing shall be installed as close to traffic-direction conversion as practicable. All new signal heads and signing on traffic signal equipment shall be covered until traffic conversion occurs. The removal of any signing on traffic signal equipment shall occur at the time of the traffic conversion.


Contractor shall install Traffic Signal Pole #1, new Traffic Signal Controller, Traffic Signal 6A (mast arm), Traffic Signal Head 6A (pole), and Street Name Sign "M" (mast arm).

Contractor shall install Traffic Signal Head 2A (pole) on Traffic Signal Pole #4.

Contractor shall install Traffic Signal Pole #5, Traffic Signal 8A (mast arm), Traffic Signal Head 8A (pole), Traffic Signal Head 2K (pole), Traffic Signal Head 8K (pole), and Street Name Sign "N" (mast arm).

Contractor shall remove the following signs:

- "One Way" (R6-1R) sign from Traffic Signal Pole #2 (pole)
- "One Way" (R6-1R) sign from Traffic Signal Pole #3 (mast arm)
- "One Way" (R6-1L) sign from Traffic Signal Pole #4 (mast arm)
- "One Way" (R6-1L) sign from Traffic Signal Pole #4 (pole)

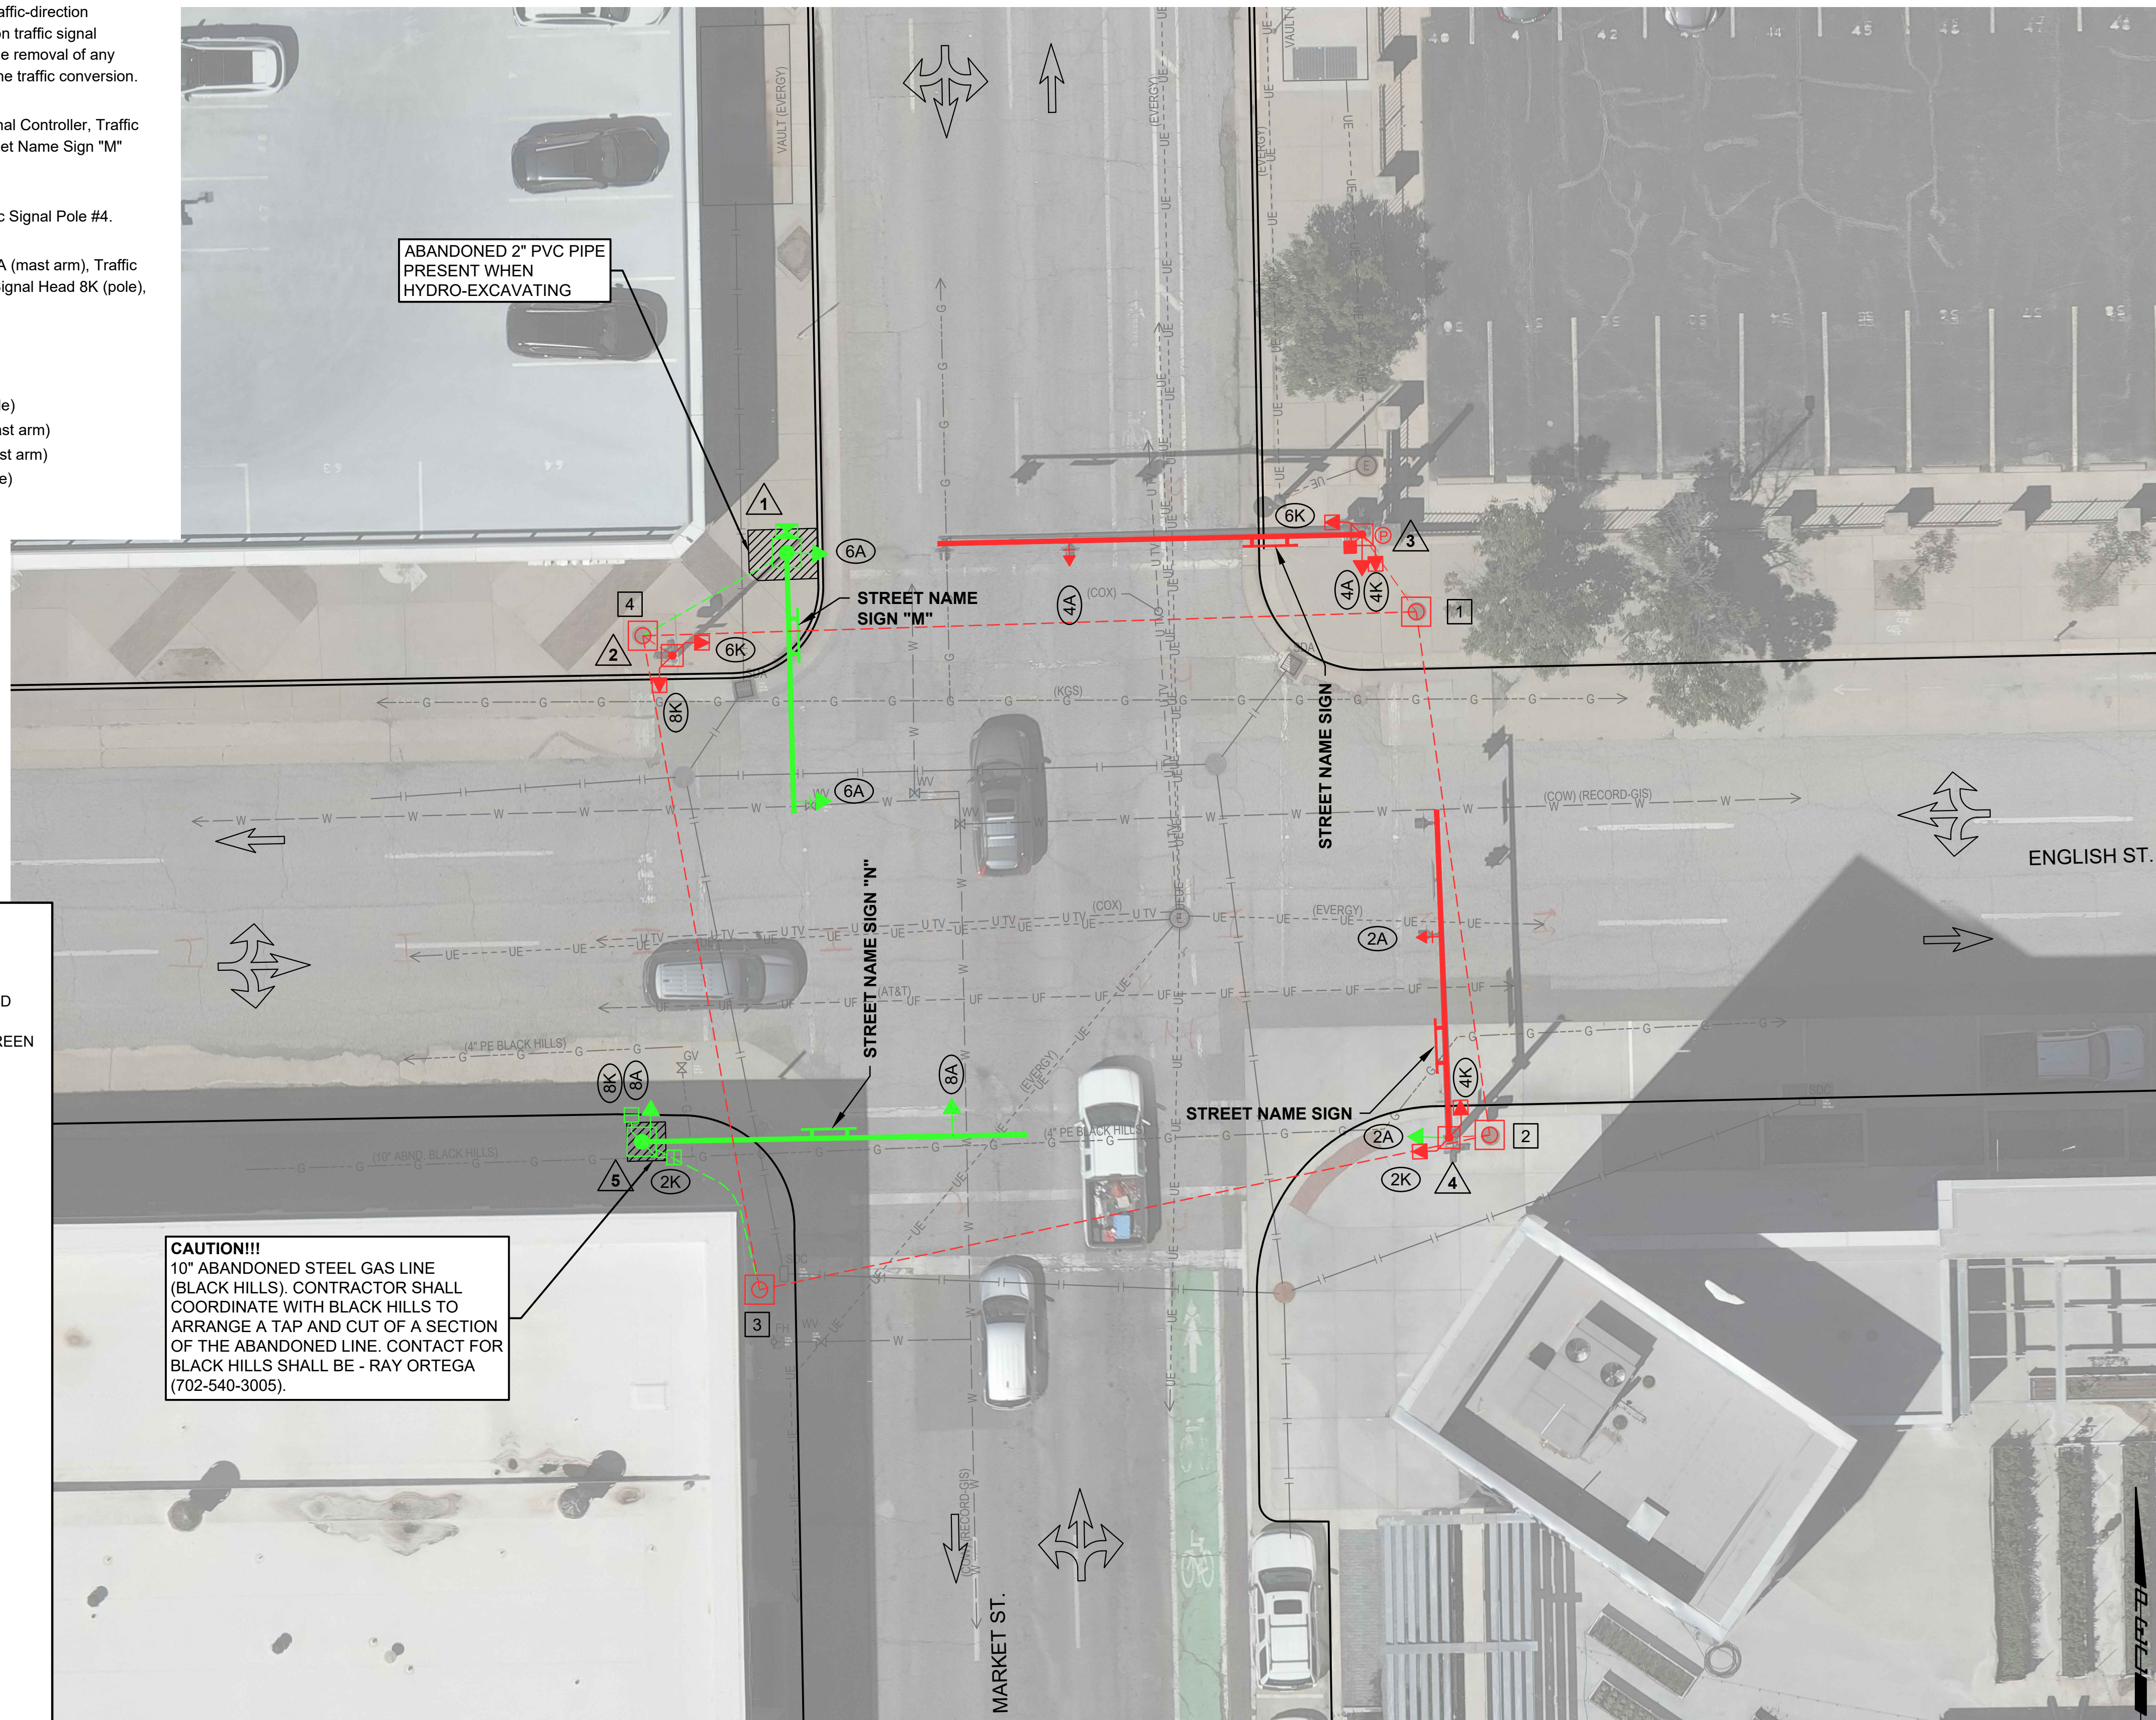


ABANDONED 2" PVC PIPE PRESENT WHEN HYDRO-EXCAVATING

CAUTION!!!
10" ABANDONED STEEL GAS LINE (BLACK HILLS). CONTRACTOR SHALL COORDINATE WITH BLACK HILLS TO ARRANGE A TAP AND CUT OF A SECTION OF THE ABANDONED LINE. CONTACT FOR BLACK HILLS SHALL BE - RAY ORTEGA (702-540-3005).

LEGEND

- PAVEMENT REMOVED & REPLACED
- TRAFFIC EQUIPMENT TO REMAIN IN RED
- PROPOSED TRAFFIC EQUIPMENT IN GREEN
- POWER/METER LOCATION
- TRAFFIC CONTROLLER CABINET
- SERVICE BOX
- CONDUIT
- TRAFFIC SIGNAL POLE
- SIGNAL HEAD W/BACKPLATE
- SIGNAL HEAD
- PEDESTRIAN SIGNAL HEAD
- PEDESTRIAN PUSHBUTTON
- TRAFFIC SIGN
- LUMINAIRE WITH ARM
- COMM. ANTENNA MOUNT
- VIDEO DETECTION CAMERA
- RADAR DETECTION UNIT
- LANE USE
- SERVICE BOX NUMBER
- SIGNAL POLE NUMBER
- SIGNAL HEAD PHASE/TYPE
- DETECTOR NUMBER

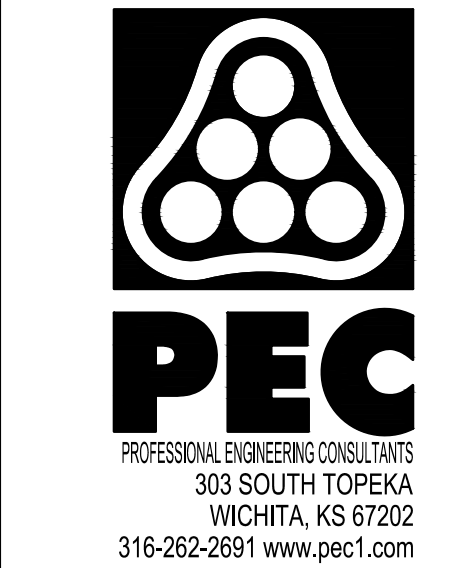

**DOWNTOWN
TWO-WAY STREET
CONVERSION
CENTRAL BUSINESS DISTRICT
WICHITA, KANSAS**

Issue:	
1	

JOB NO.	230431-000
DATE	JULY 2024
PM	TPA
DESIGNED BY	LGP/SAC
DRAWN BY	CP/SAC
CHECKED BY	SAC/TPA

MARKET ST. & ENGLISH ST.
TRAFFIC SIGNAL PLAN SHEET