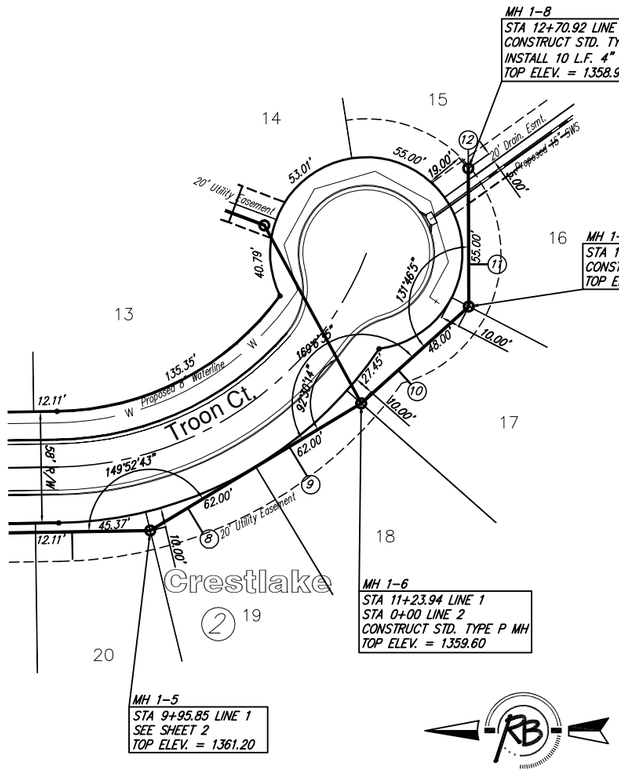

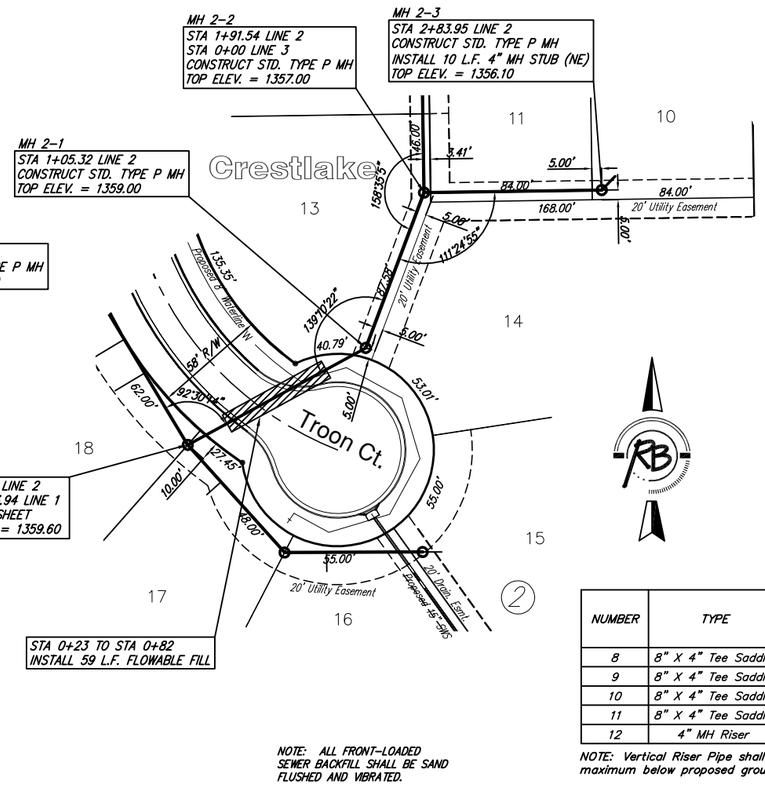

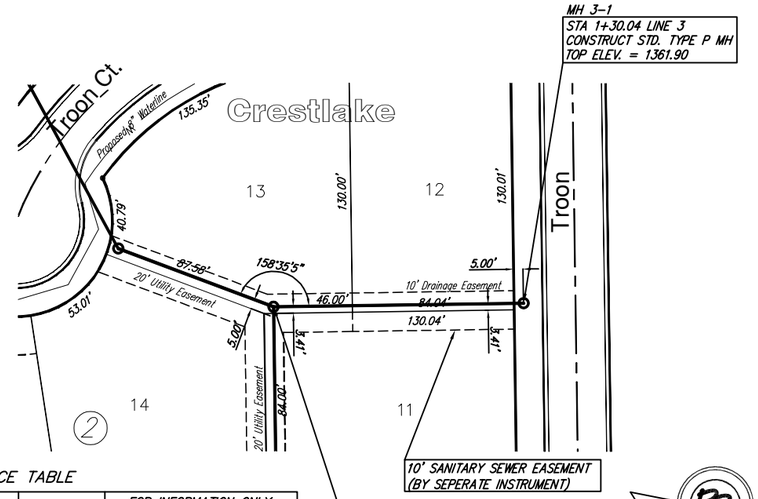

SEWER SERVICE TABLE

NUMBER	TYPE	LOCATION LOT NO.	LOCATION BLOCK NO.	LOCATION LINE NO.	STATION \ DIRECTION	FOR INFORMATION ONLY APPROXIMATE LENGTH 4" PIPE VERTICAL	FOR INFORMATION ONLY APPROXIMATE LENGTH 4" PIPE HORIZONTAL
8	8" X 4" Tee Saddle	19	2	1	10+~~40~~/R	18.35'8'	15'
9	8" X 4" Tee Saddle	18	2	1	10+~~90~~/R	78.35'7'	18'
10	8" X 4" Tee Saddle	17	2	1	11+~~50~~/R	49.94'5'	10'
11	8" X 4" Tee Saddle	16	2	1	12+~~24~~/R	23.16'5'	10'
12	4" MH Riser	15	2	1	12+~~71~~/R	70.92'5'	10'

NOTE: Vertical Riser Pipe shall be extended to 2' minimum above ground water elevation and 4' maximum below proposed ground elevation.

NOTE: ALL FRONT-LOADED SEWER BACKFILL SHALL BE SAND FLUSHED AND VIBRATED.

SCALE 1" = 40' HORIZ.
1" = 5' VERT.
IRON = ●

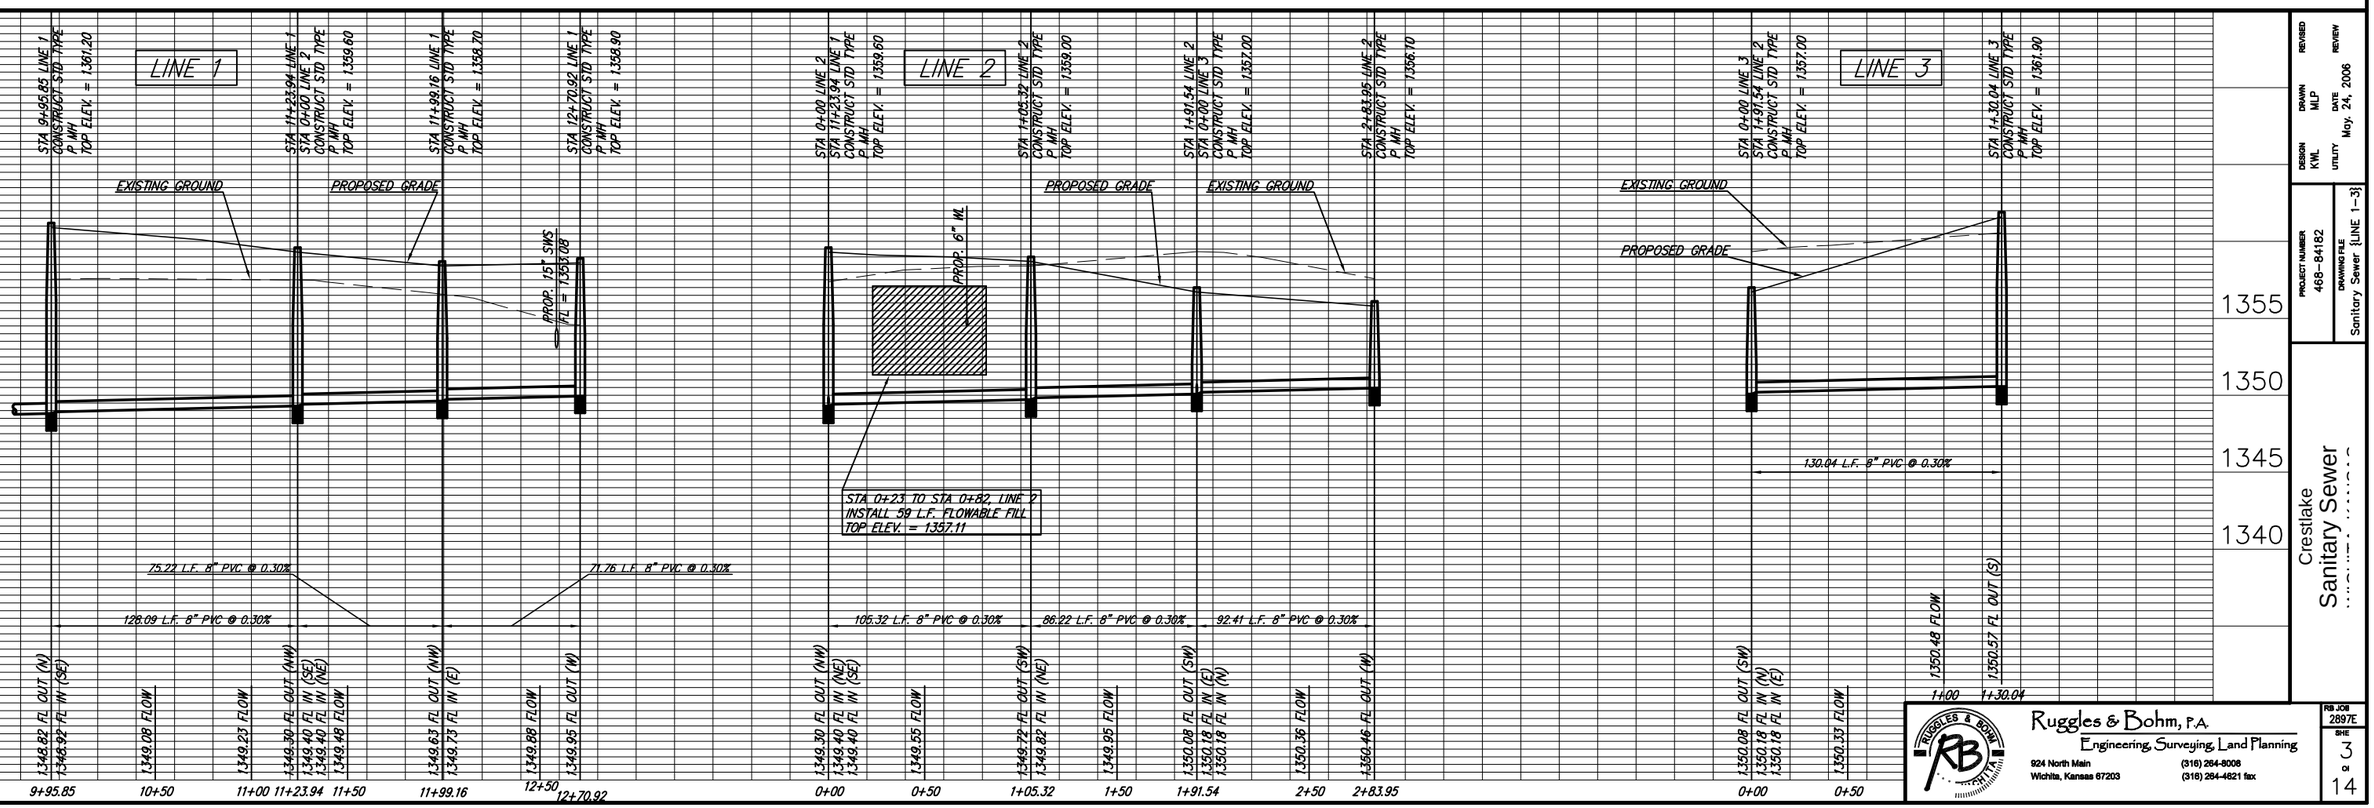

REVISED
REVIEW
DRAWN MLP
DESIGN KWL
UTILITY
DATE May, 24, 2006
PROJECT NUMBER 468-84182
DRAWING FILE Sanitary Sewer (LINE 1-3).dgn

Crestlake
Sanitary Sewer

Ruggles & Bohm, P.A.
Engineering, Surveying, Land Planning
924 North Main
Wichita, Kansas 67203
(316) 264-8006
(316) 264-4621 fax

RB JOB 2897E
SHEET 3 of 14