
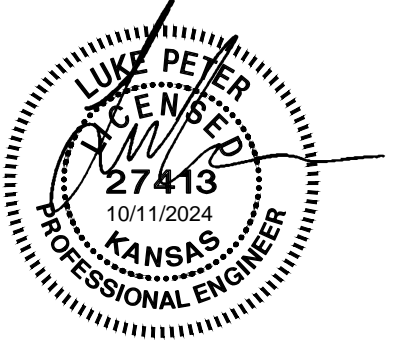
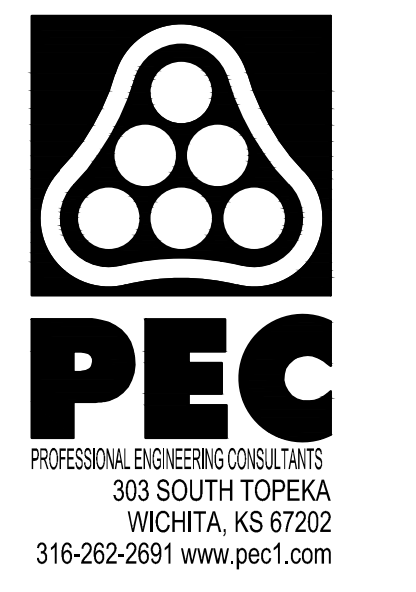
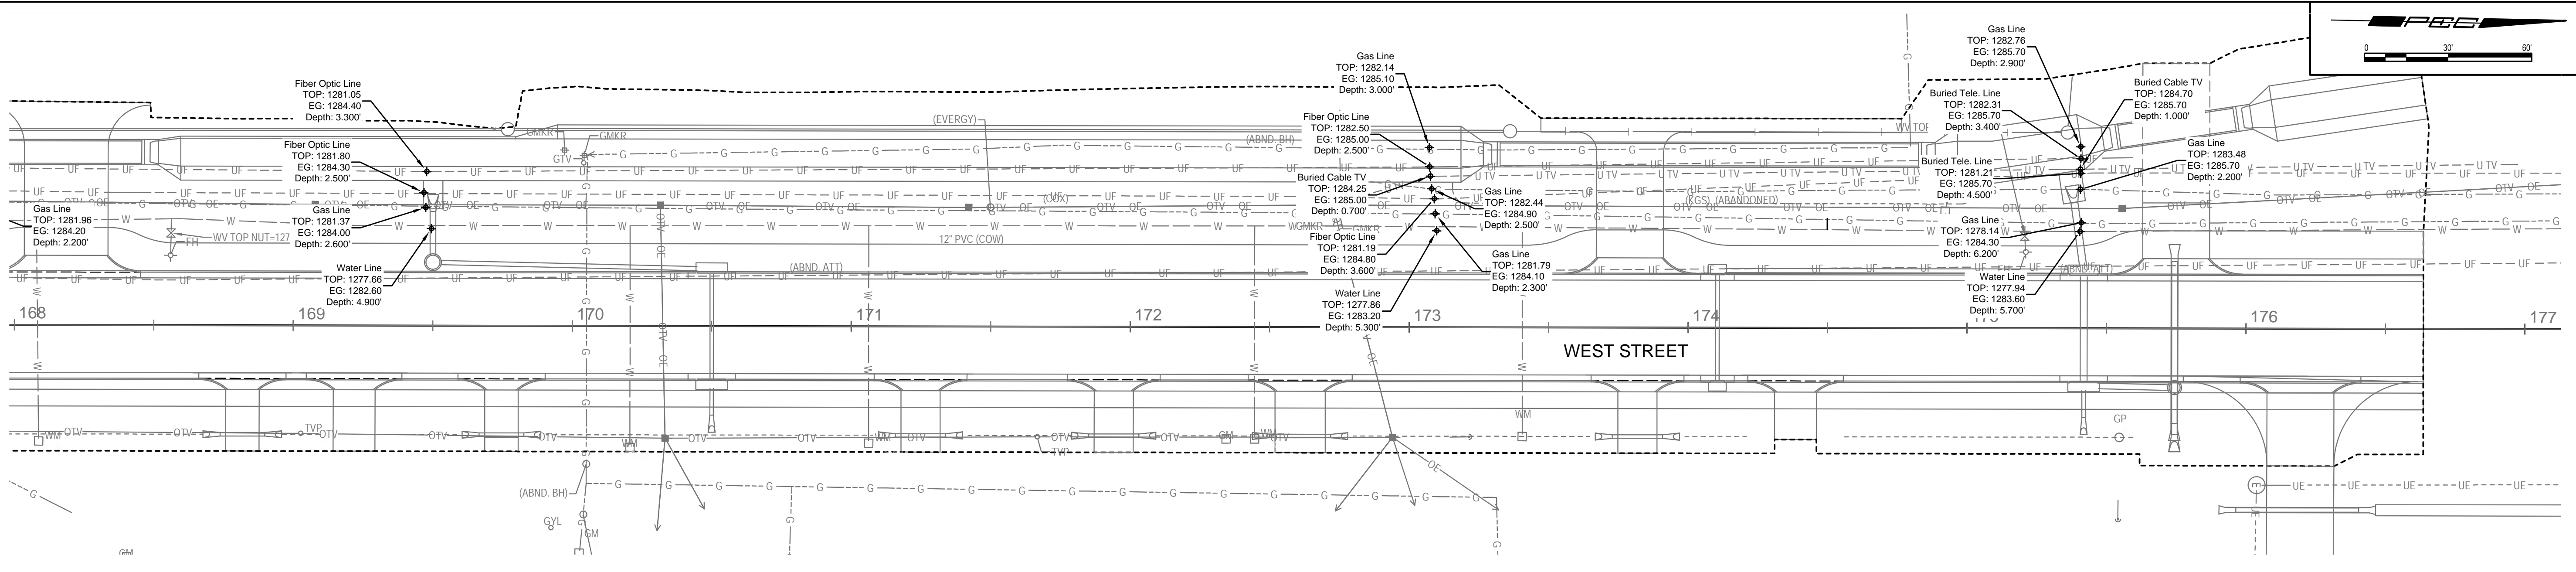
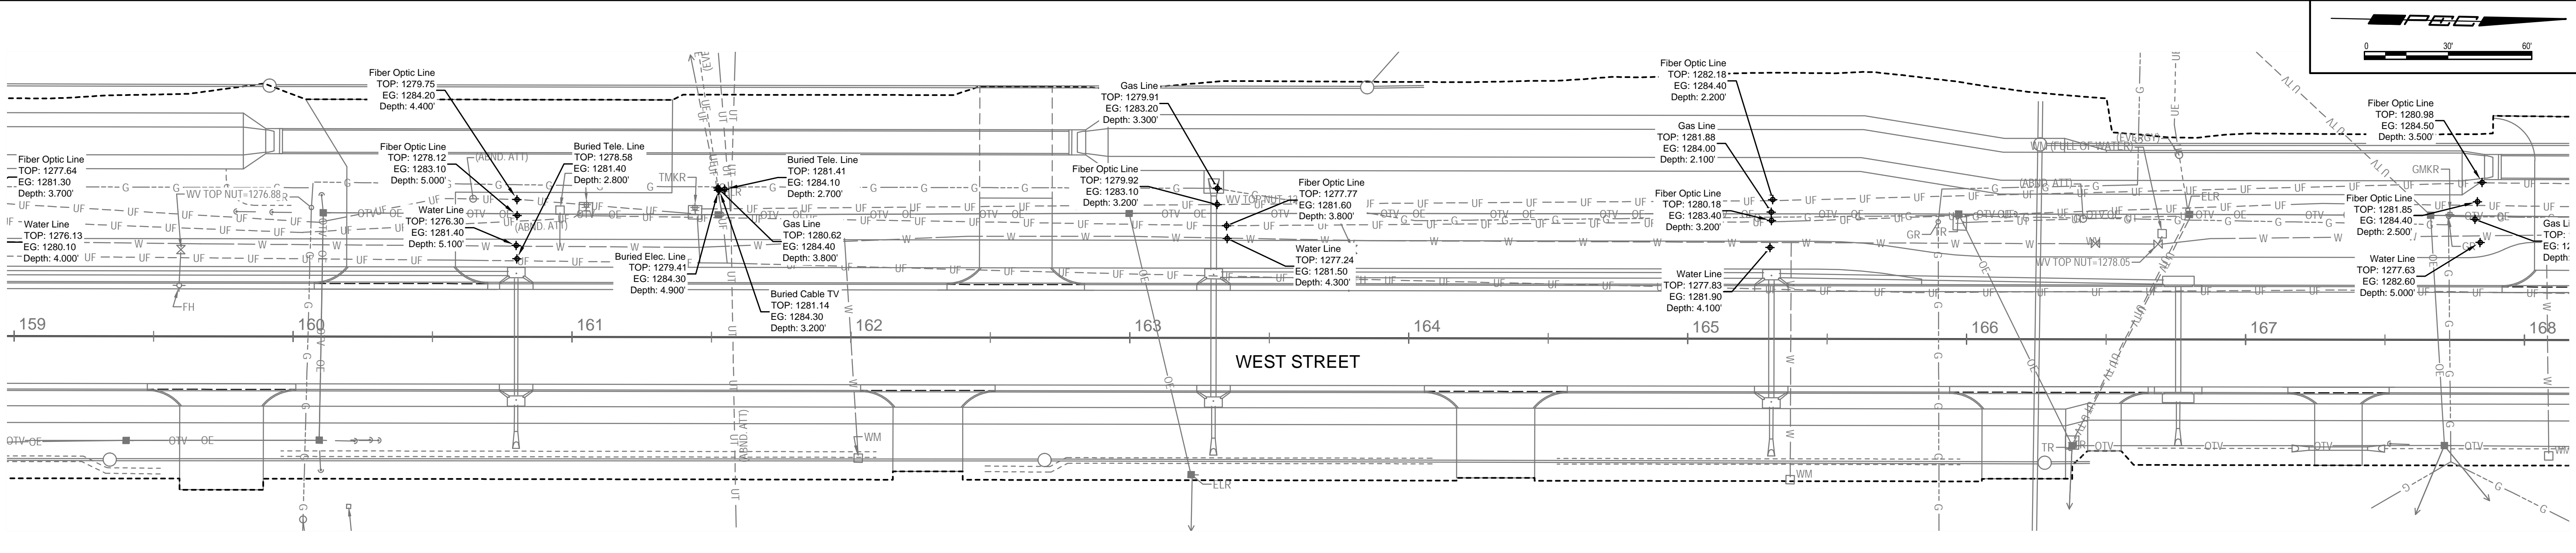


SAVED 10/10/2024 8:48:21 AM BY LUKE.PETER  
 PLOTTED 10/10/2024 1:51:25 PM BY LUKE.PETER  
 U:\WICHITA-CIVIL\2024\1210254\001\PECDRAWINGS\210254-001\_PROBES.DWG

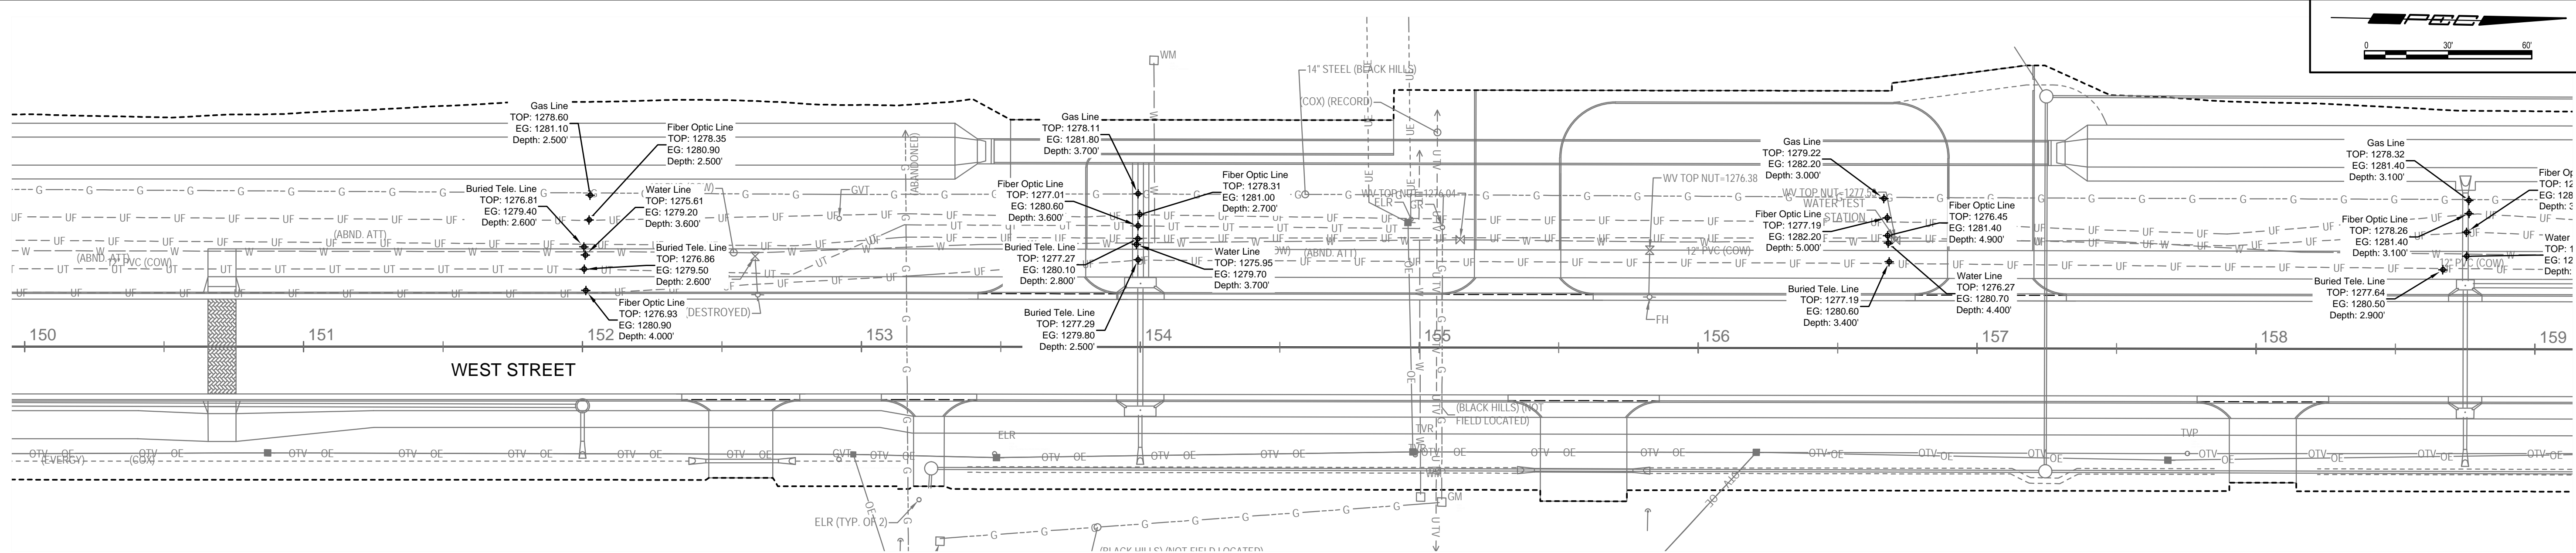

**WEST STREET IMPROVEMENTS  
 FROM MACARTHUR ROAD TO  
 47TH ST. SOUTH**  
 CITY OF WICHITA

Issue:	
JOB NO.	210254-001
DATE	OCTOBER 2024
PM	TPA
DESIGNED BY	LGP
DRAWN BY	CP
CHECKED BY	KMS
UTILITY POTHOLING (FOR REFERENCE)	
<b>CL202</b>	
105 OF 206	