



### Defect Listing Plot

Pipe Segment Refere... <b>13</b>	City <b>WICHITA</b>	Street <b>MCLEAN BLVD</b>	Material <b>PolyVinyl Chloride</b>	Location C... <b>Easement/R...</b>	Sewer Use <b>Stormwater</b>
Upstream MH <b>0+60.90</b>	Total Length	Up Rim to Invert <b>12.5</b>	Shape <b>Circular</b>	Location Details <b>LINE 0</b>	
DS Manhole <b>0+44.08</b>	Length surveyed <b>21.4</b>	Down Rim to Invert <b>9</b>	Height <b>18</b>	Width <b>18</b>	Pipe Joint...
SPR <b>0</b>	MPR <b>0</b>	PO Number <b>603 PPD 133119</b>		Customer <b>DONDLINGER</b>	
SPRI <b>0</b>	MPRI <b>0</b>	Work Order		Purpose <b>Pre-Acceptance</b>	
QSR <b>0000</b>	QMR <b>0000</b>	Direction <b>Downstream</b>	Date <b>20200124</b>	Media label	
OPR <b>0</b>	Surveyed By <b>Chuck</b>	Pre-Cleaning <b>Jetting</b>	Time <b>12:10</b>	Weather <b>Light Rain</b>	
OPRI <b>0</b>	Certificate Number <b>U-0118-070300421</b>		End Time <b>12:11</b>	Additional Info <b>TV14</b>	
	Date Cleaned <b>20200124</b>				


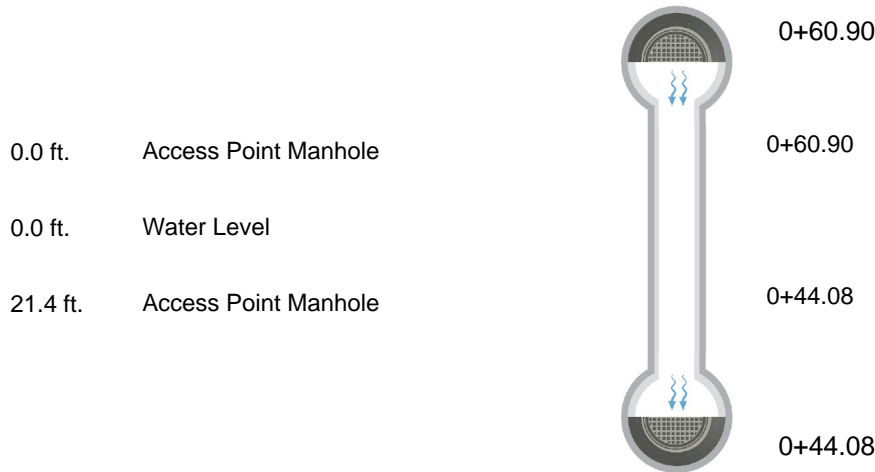




Image Report 1/Page

Pipe Segment Refere... 13	City WICHITA	Street MCLEAN BLVD	Material PolyVinyl Chloride	Location C... Easement/R...	Sewer Use Stormwater
Upstream MH 0+60.90	Total Length	Up Rim to Invert 12.5	Shape Circular	Location Details LINE 0	
DS Manhole 0+44.08	Length surveyed 21.4	Down Rim to Invert 9	Height 18	Width 18	Pipe Joint...

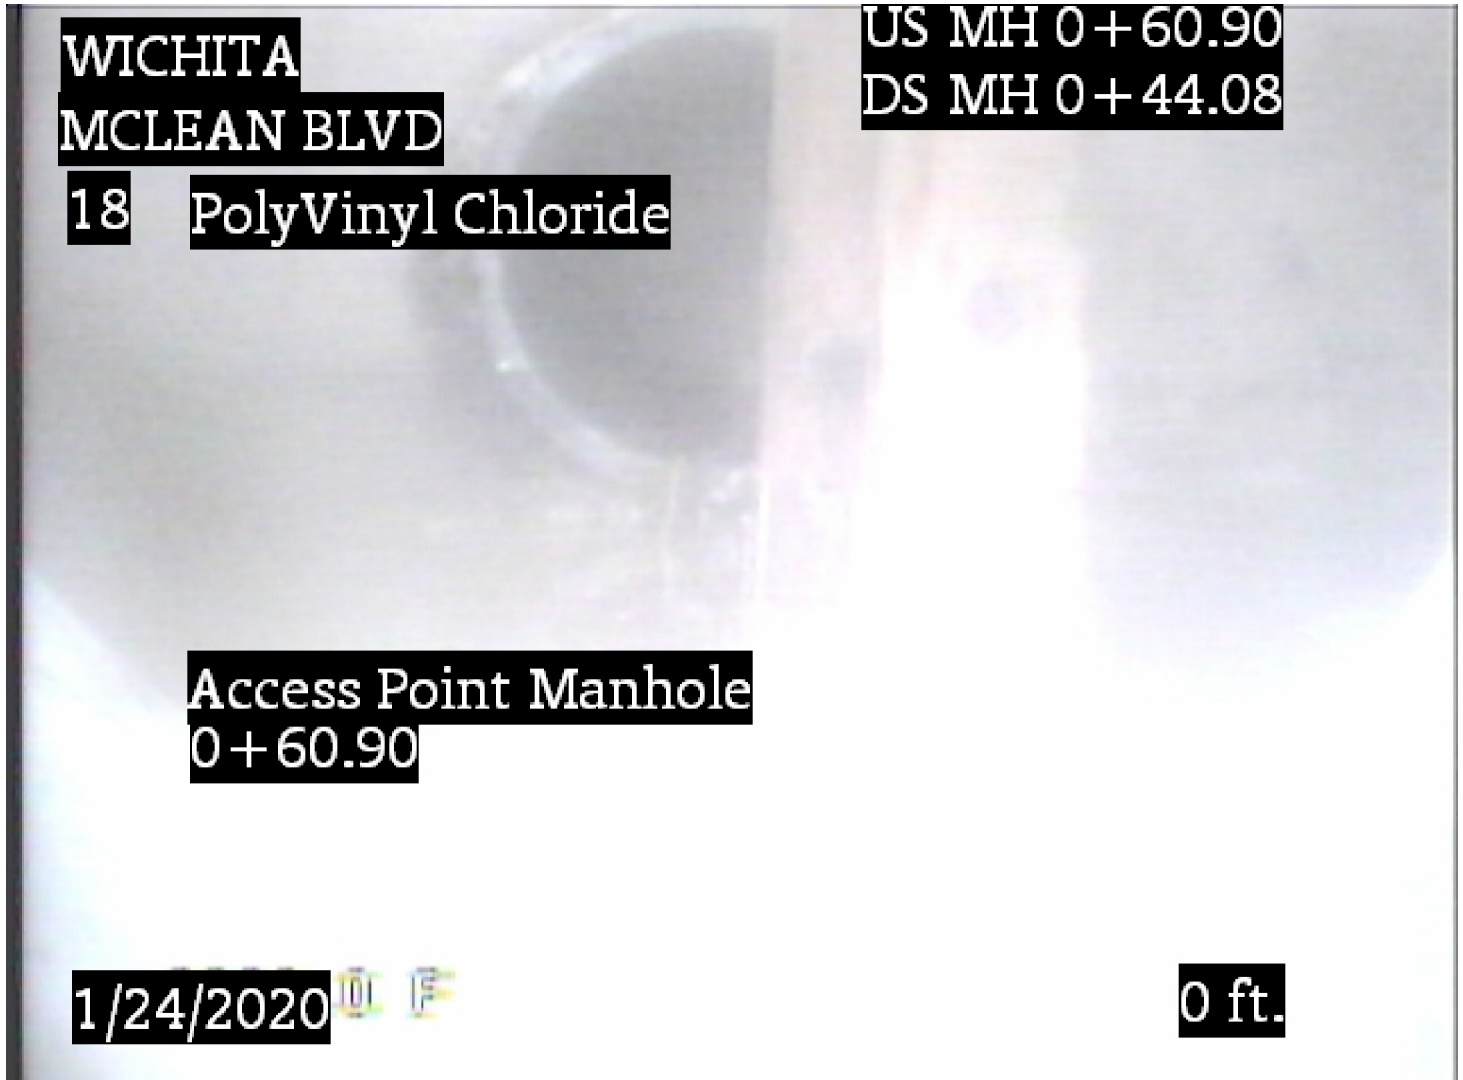


Distance:	0.0 ft.
Condition:	Access Point Manhole
Grade:	0
Remarks:	0+60.90



Image Report 1/Page

Pipe Segment Refere... 13	City WICHITA	Street MCLEAN BLVD	Material PolyVinyl Chloride	Location C... Easement/R...	Sewer Use Stormwater
Upstream MH 0+60.90	Total Length	Up Rim to Invert 12.5	Shape Circular	Location Details LINE 0	
DS Manhole 0+44.08	Length surveyed 21.4	Down Rim to Invert 9	Height 18	Width 18	Pipe Joint...

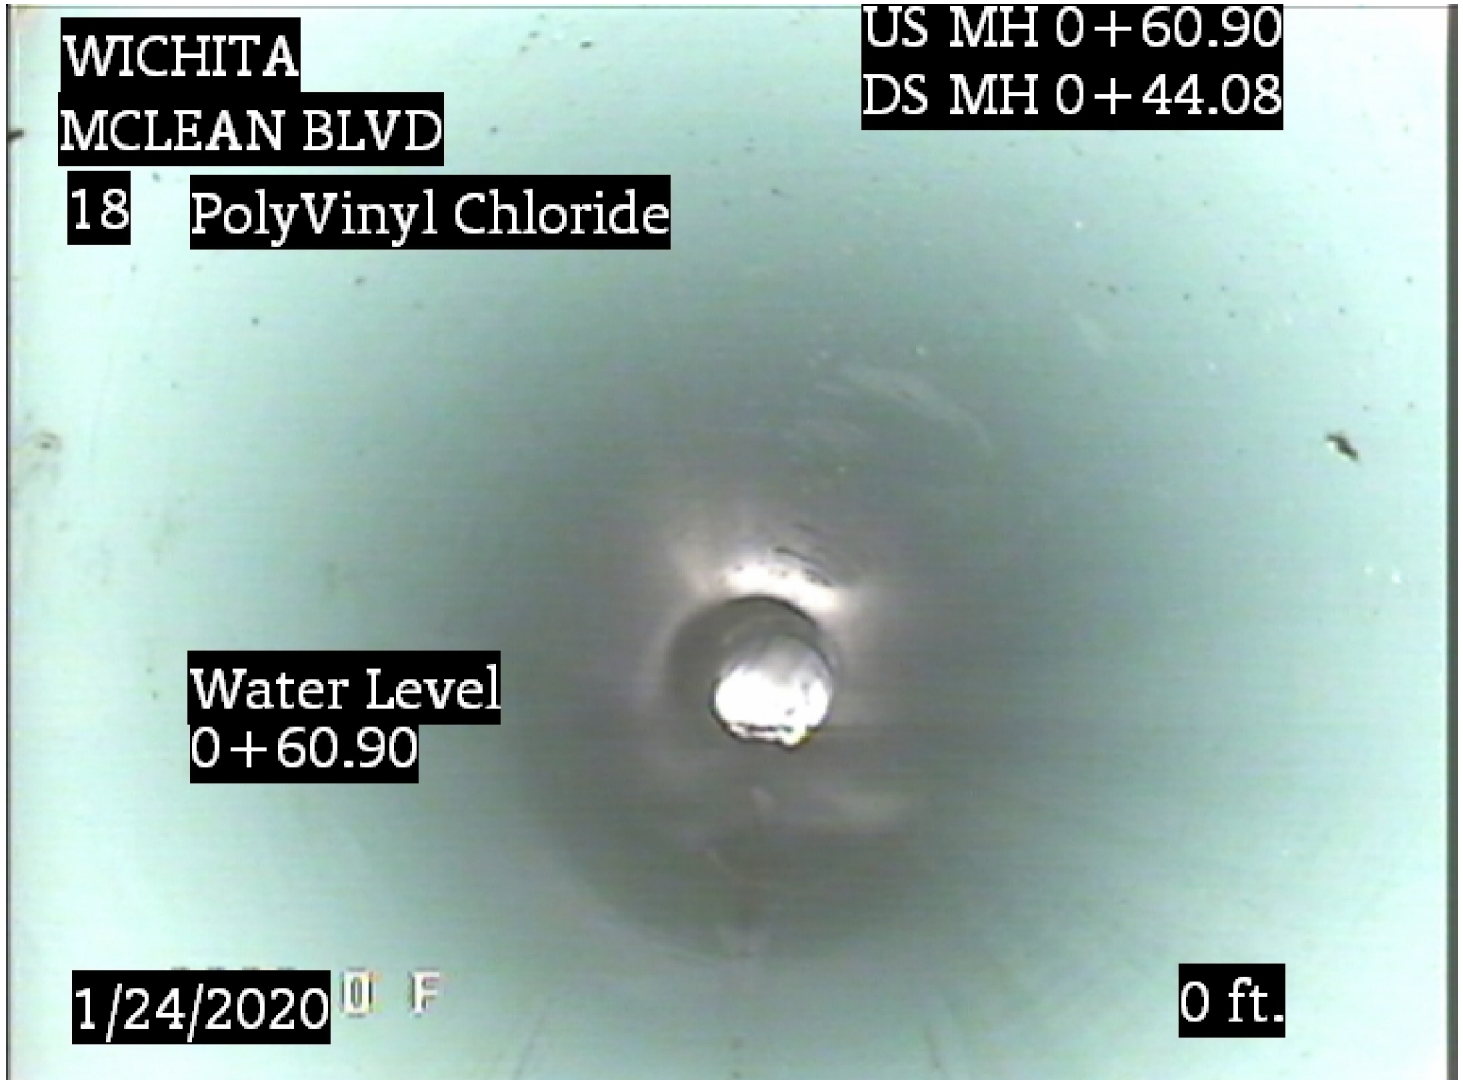


Distance:	0.0 ft.
Condition:	Water Level
Grade:	0
Remarks:	N/A



Image Report 1/Page

Pipe Segment Refere... 13	City WICHITA	Street MCLEAN BLVD	Material PolyVinyl Chloride	Location C... Easement/R...	Sewer Use Stormwater
Upstream MH 0+60.90	Total Length	Up Rim to Invert 12.5	Shape Circular	Location Details LINE 0	
DS Manhole 0+44.08	Length surveyed 21.4	Down Rim to Invert 9	Height 18	Width 18	Pipe Joint...

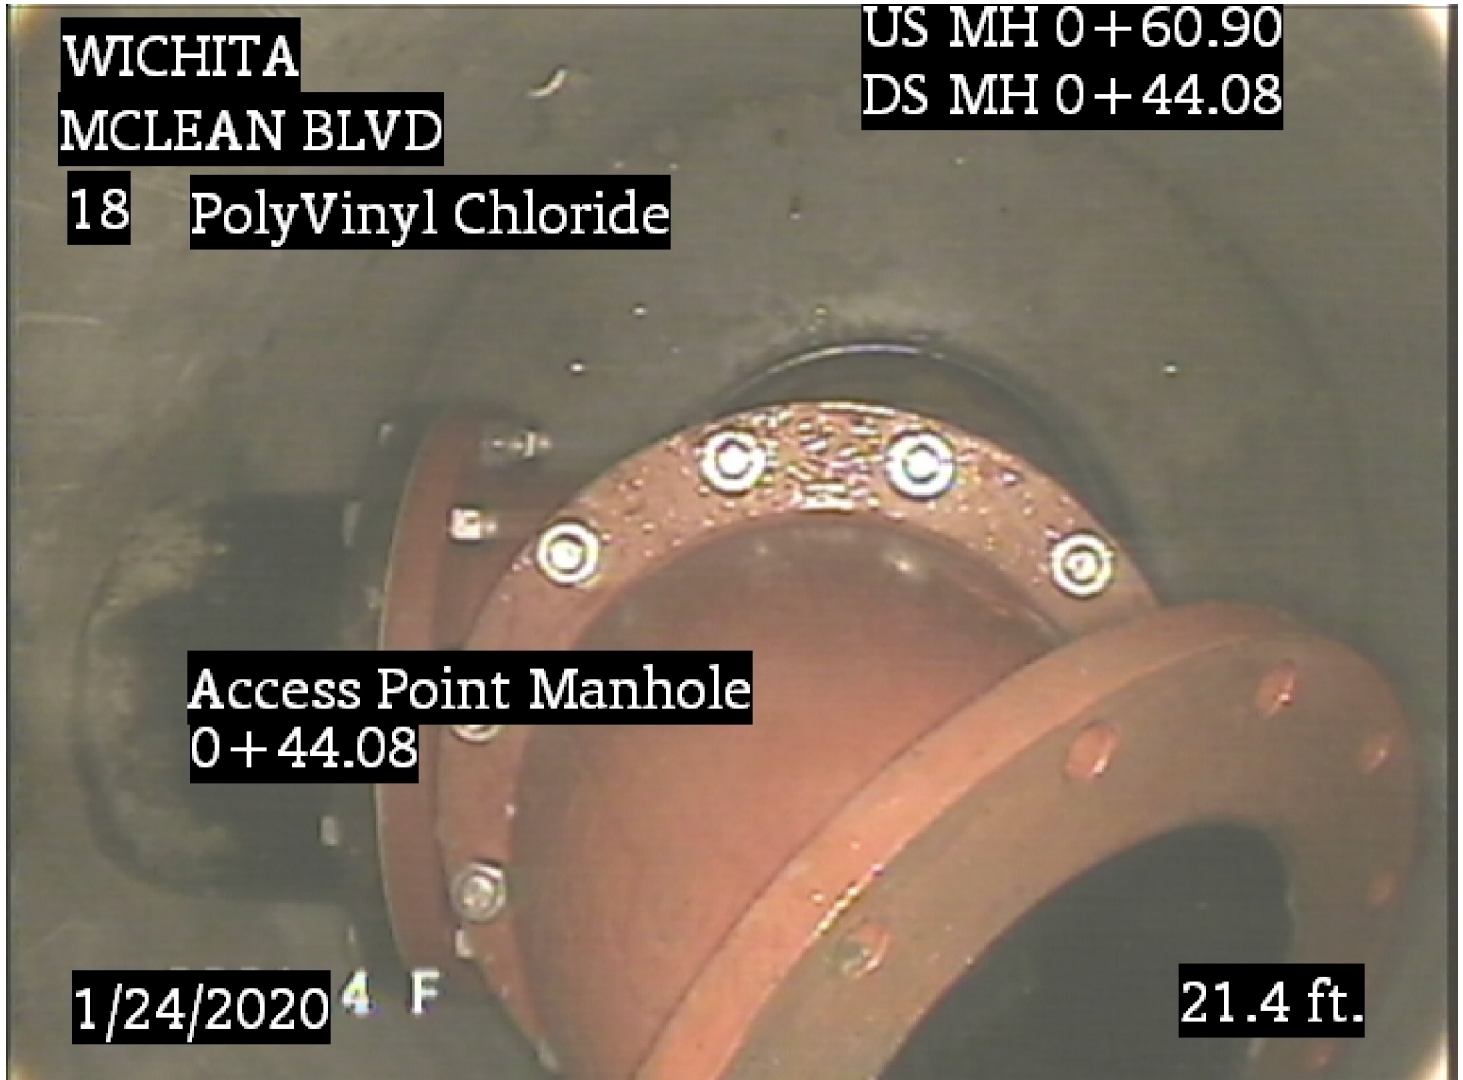

Distance:	21.4 ft.
Condition:	Access Point Manhole
Grade:	0
Remarks:	0+44.08