ENGINEERING DEPARTMENT — CITY OF WICHITA — MISCELLANEOUS INFORMATION


Signed Chris Copeland-10 | Contractor KANSAS PAVING | Date 7/1/05

Project MY HOUSE ADD. (56TH S. AT MINNIE)

Project Number 472-84049 (765903)

1.) PLANS CALLED FOR 5" OF ROCK AND 5" OF ASPHALT IN ENTRANCES OF 56TH ST. CIR. AND WAYNE CIR. TOP OF PVMT. AT WEST EDGE OF MINNIE IS THE SAME AS THE TOP OF THE NEW 12" RCP CULVERT PIPE. TO ENSURE WE GOT 5" OF ROCK AND 5" OF ASPHALT OVER THE RCP, STEVE DEGENHARDT, PROJECT ENGINEER, ELECTED TO RAISE PAVEMENT ELEV. AT ℄ OF CULVERT PIPE 5" AND TO STRAIGHT GRADE FROM THERE DOWN TO PAVEMENT AT MINNIE. (SEE BACK) →

Form 192-034 (4/81)

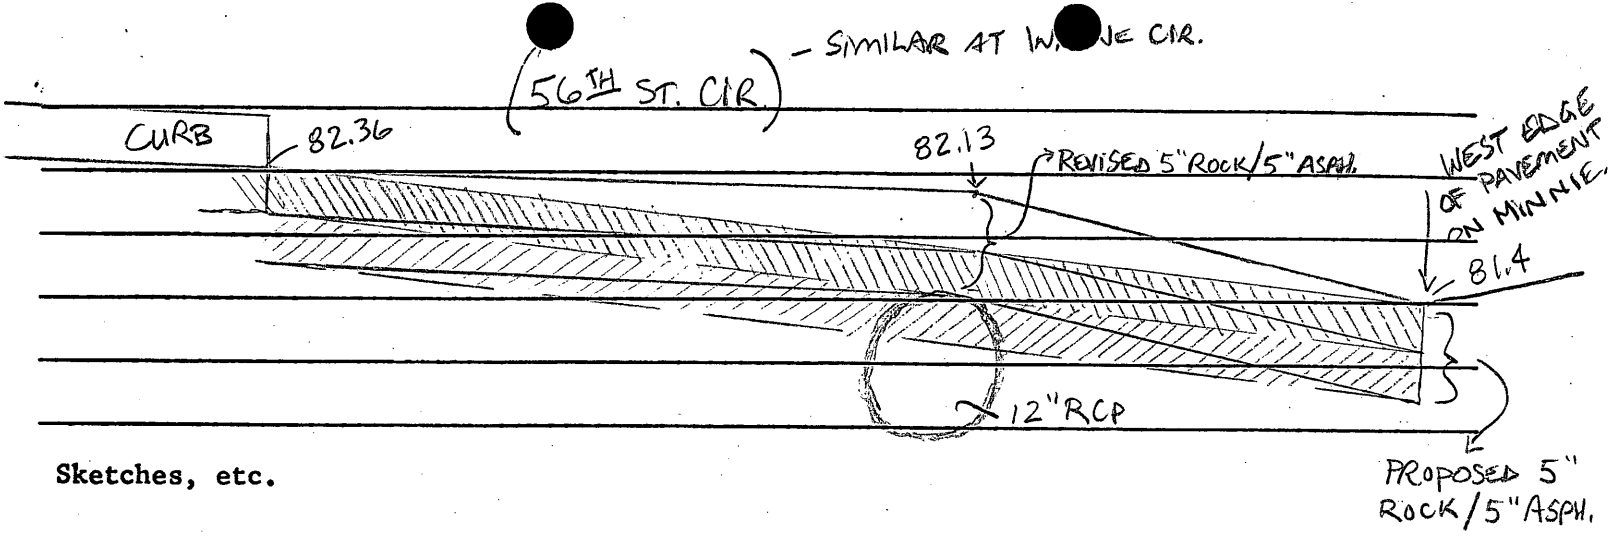

Sketches, etc.