

ENGINEERING DEPARTMENT

CITY OF WICHITA

MISCELLANEOUS INFORMATION

Signed Chris Condon

Contractor KANSAS PAVING

Date 7/1/05

Project

MY HOUSE ADD. (56TH S. AT MINNIE)


Project Number

472-84049 (765903)

- 1) PLANS CALLED FOR 5" OF ROCK AND 5" OF ASPHALT IN ENTRANCES OF 56TH ST. CIR. AND WAYNE CIR. TOP OF PVMT. AT WEST EDGE OF MINNIE IS THE SAME AS THE TOP OF THE NEW 12" RCP CULVERT PIPE. TO ENSURE WE GOT 5" OF ROCK AND 5" OF ASPHALT OVER THE RCP, STEVE DEGENHARDT, PROJECT ENGINEER, ELECTED TO RAISE PAVEMENT ELEV. AT $\frac{1}{4}$ OF CULVERT PIPE 5" AND TO STRAIGHT GRADE FROM THERE DOWN TO PAVEMENT AT MINNIE. (SEE BACK) →

(56TH ST. CIR.)

- SIMILAR AT W. JE CIR.

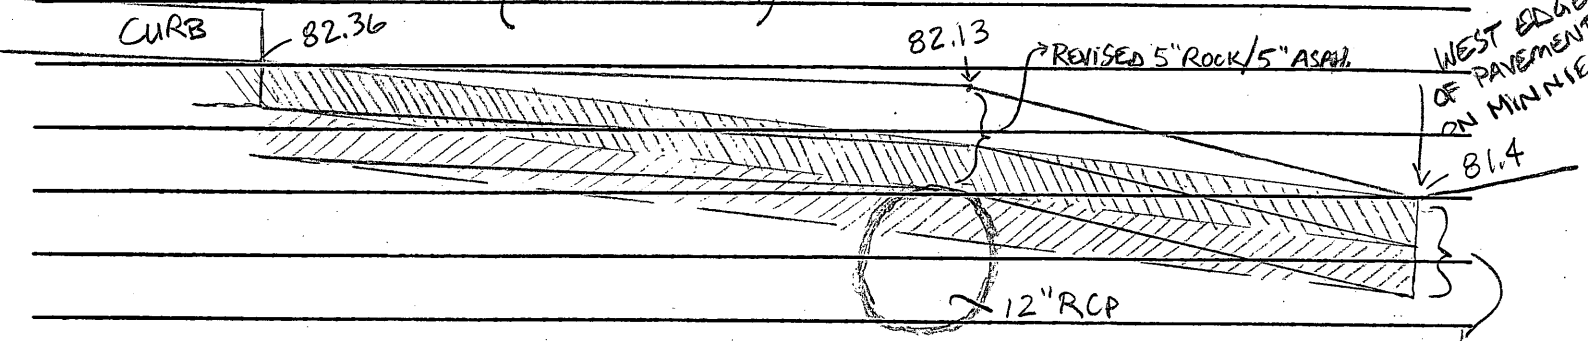

CURB

82.36

82.13

REVISED 5" ROCK / 5" ASPH.

WEST EDGE OF PAVEMENT ON MINNIE.

81.4

12" RCP

PROPOSED 5" ROCK / 5" ASPH.

Sketches, etc.