PRIVATE SANITARY SEWER EXTENSION

TO SERVE

ETHANOL PRODUCT CORP HEADQUARTERS

PRIVATE PROJECT NO. 1749 PPS (607861)

CITY OF WICHITA, KANSAS

JAMES L. ARMOUR, P.E. - CITY ENGINEER

INDEX OF SHEETS

SHEET NO. C3.1	TITLE SHEET
SHEET NO. C3.2	KEY MAP AND GENERAL NOTES
SHEET NO. C3.3	PLAN/PROFILE
SHEET NO. C5.2-5.4	SOIL EROSION BMP DETAILS
SHEET NO. C6.1	PLAT
SHEET NO. C6.2	TYPE "P" MANHOLE DETAILS
SHEET NO. C6.3	FRAME & COVER DETAILS

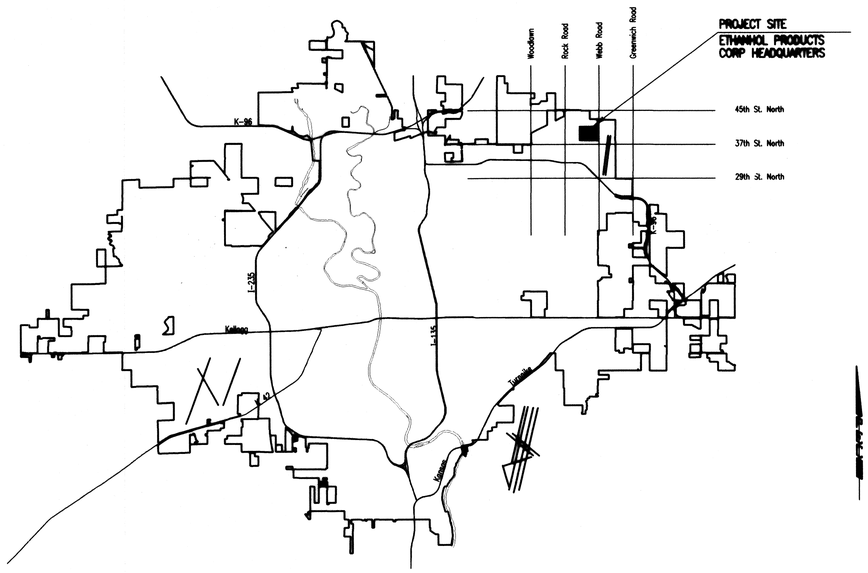

LOCATION MAP

APPROVED AS NOTED
By CITY ENGINEER OF WICHITA

Sanitary Sewers VRH 3/8/07

Storm Sewers _____

Driveway Approaches _____

Paving _____

NOTE TO CONTRACTOR

INSPECTION AND TESTING FOR THIS PROJECT IS TO BE PROVIDED BY A LICENSED CONSULTING ENGINEERING FIRM CONTRACTED BY THE OWNER/DEVELOPER. SAID INSPECTION TO BE IN ACCORDANCE WITH THE CITY OF WICHITA STANDARD CONSTRUCTION ENGINEERING PRACTICES AND CERTIFIED BY A LICENSED PROFESSIONAL ENGINEER. NO WORK SHALL BE PERFORMED IN DEDICATED EASEMENTS OR PUBLIC RIGHT-OF-WAY BY THE CONTRACTOR UNTIL SUCH INSPECTION IS ARRANGED FOR AND REQUIRED BONDS HAVE BEEN SUBMITTED TO AND APPROVED BY THE CITY NOR SHALL ANY WORK BE COMMENCED IN DEDICATED EASEMENTS OR PUBLIC RIGHT-OF-WAY WITHOUT WRITTEN AUTHORIZATION BY THE CITY ENGINEER. IMPROVEMENTS PERFORMED UNDER THIS PROJECT SHALL NOT BE ACCEPTED BY THE CITY UNTIL ALL APPLICABLE DOCUMENTATION HAS BEEN SUBMITTED TO THE CITY ENGINEER. THIS MAY INCLUDE: RECORD DRAWINGS, INSPECTION LOGS, TEST DOCUMENTATION, TV TAPES, AND A CERTIFICATE OF COMPLETION. THE ABOVE SHALL BE PERFORMED BY THE CONSULTING FIRM CONTRACTED TO INSPECT THIS PROJECT.

AS-BUILT
9/7/07
Date
Signed

MARCH 2007

PLANS PREPARED BY

PROFESSIONAL ENGINEERING CONSULTANTS, P.A.

ENGINEERS

WICHITA, KANSAS

Professional Engineering Consultants, P.A.
303 S. Topeka • Wichita, Kansas 67202 • 316.262.2691 • FAX 316.262.8003
www.pec1.com

Architectural Development Services, L.L.C.
P.O. Box 48406
Wichita, Kansas 67201
Phone: 316 686-4343
Fax: 316 686-8084

SHAWN RAY HILL
LICENSED
17894
KANSAS
PROFESSIONAL ENGINEER
3/8/07

Ethanol Products
Corporate Headquarters
38th and Webb Road
Wichita, Kansas

prints issued
3-9-07
For Construction

project no.
06122

drawn SAW check SHRH

PRIVATE SANITARY SEWER TITLE SHEET

C3.1

of

Saved 03-08-2007 11:03:30 AM by SAW
Plot Scale 1:1 03-09-2007 1:18:20 PM by SAW
Q:\2006\06567\Site Civil\Private Plans\Sanitary Sewer\06567-C3.1-PPSTITLE