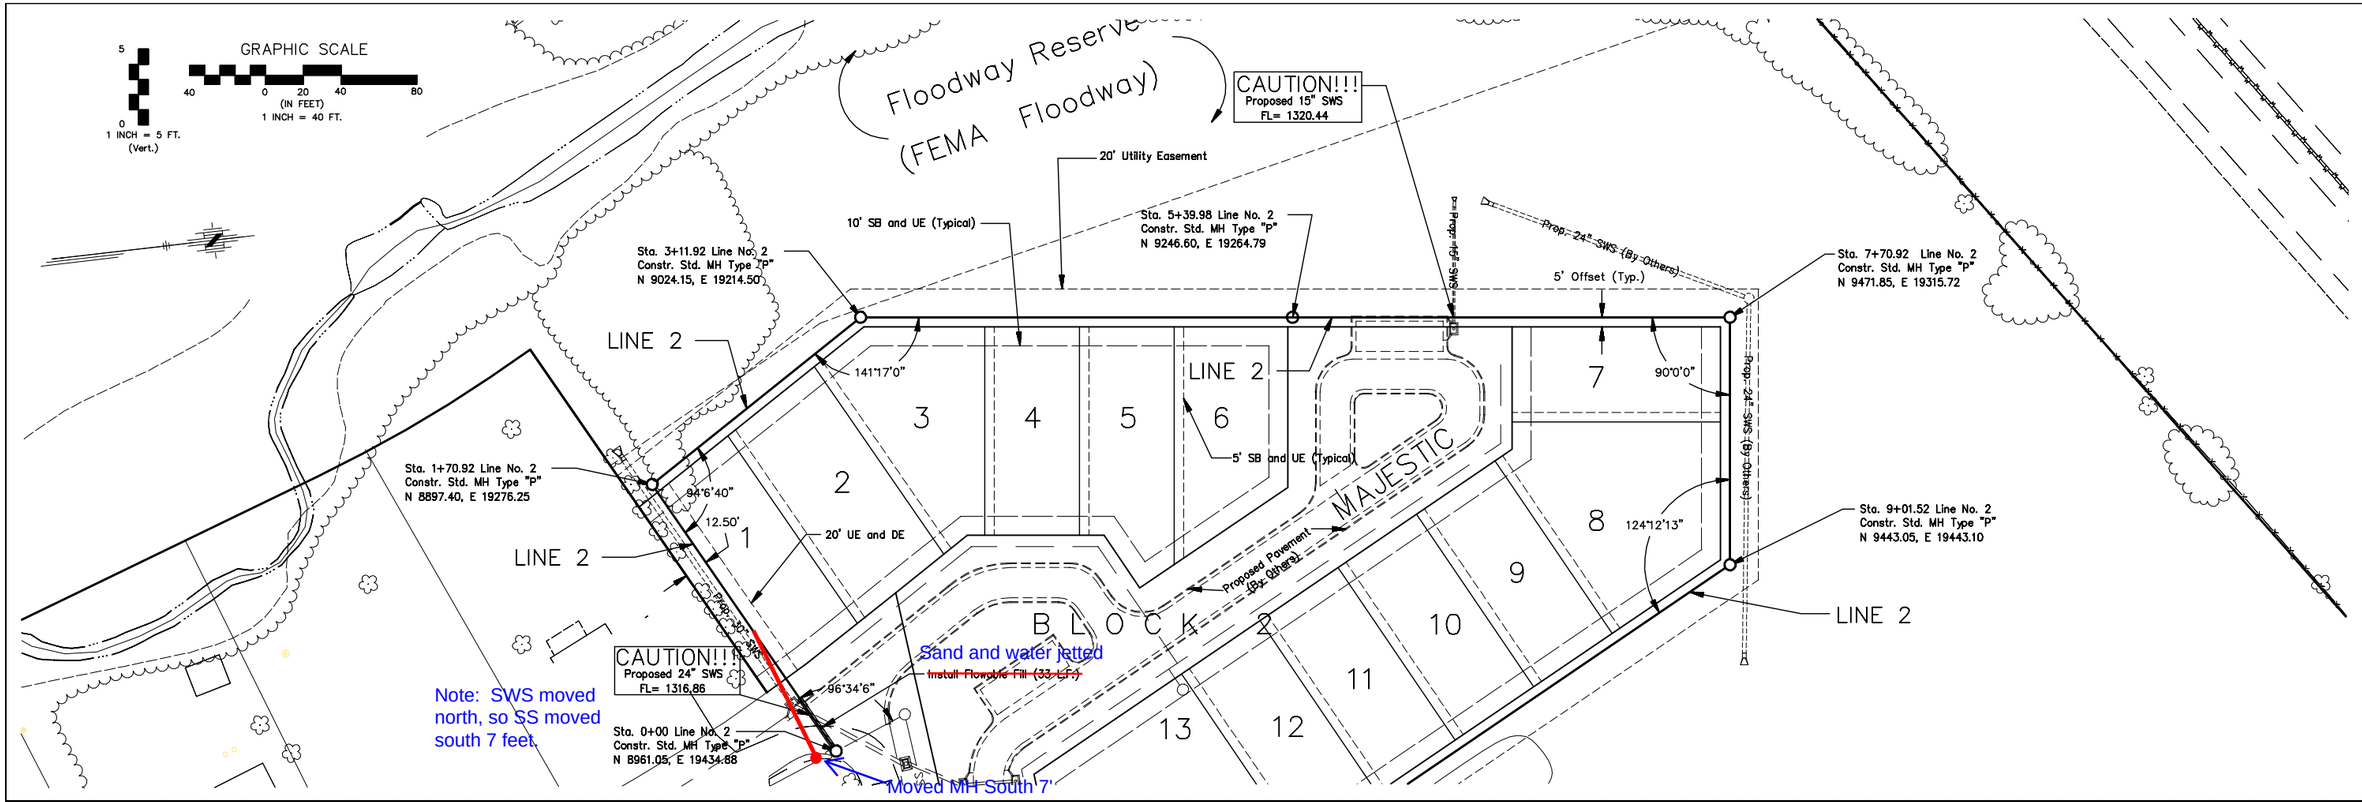

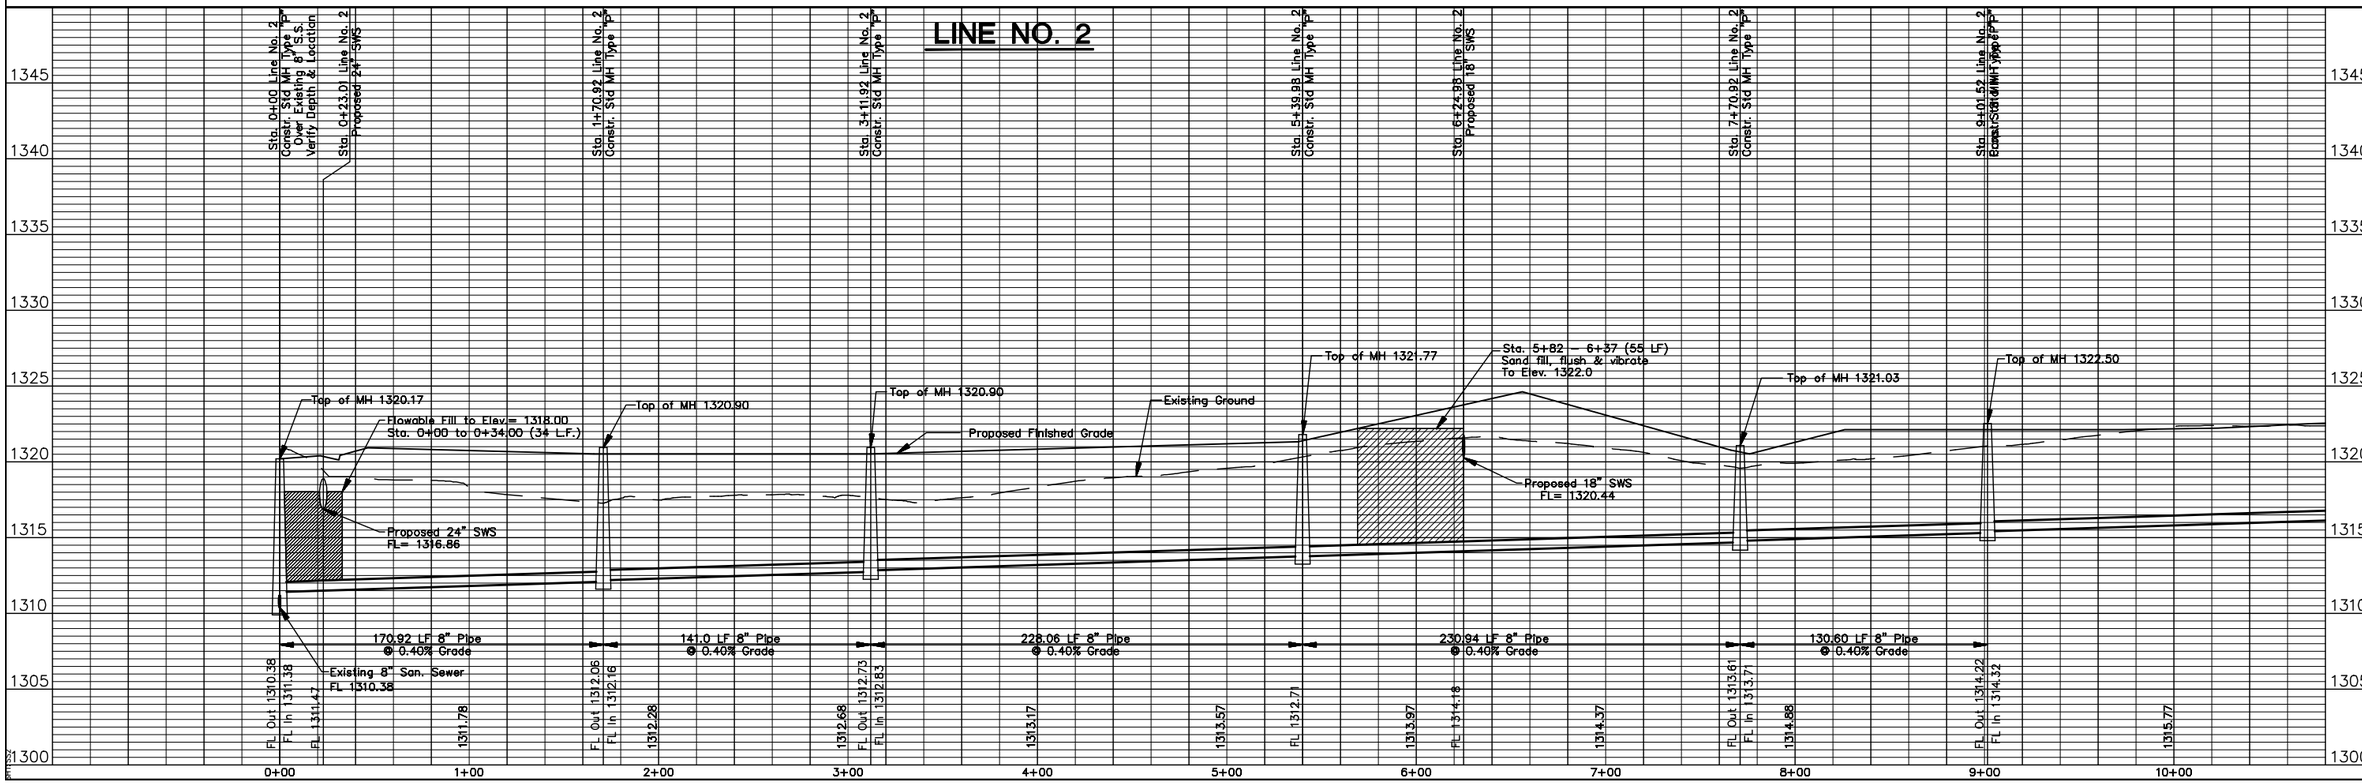

No.	Revision	Approved	By	Date

TERRADYNE WEST ADDITION
LATERAL 402, FOUR MILE CREEK SEWER
SANITARY SEWER LINE NO. 2
CITY OF WICHITA, KANSAS
JAMES L. ARMOUR, P.E. – CITY ENGINEER
Proj. No. 468-84261 O.C.A.# 744203

POE & ASSOCIATES, INC.
CONSULTING ENGINEERS
3340 E. Central, Suite 200 • Wichita, KS 67208-4242
Phone 316/685-4114 • FAX 316/685-4444

FINAL

Designed By: J. Ubert / J. Dickman
Drawn By: M. Tucker
Poe Job No.: 1809
Date: December 2006

Sheet
2 of 15