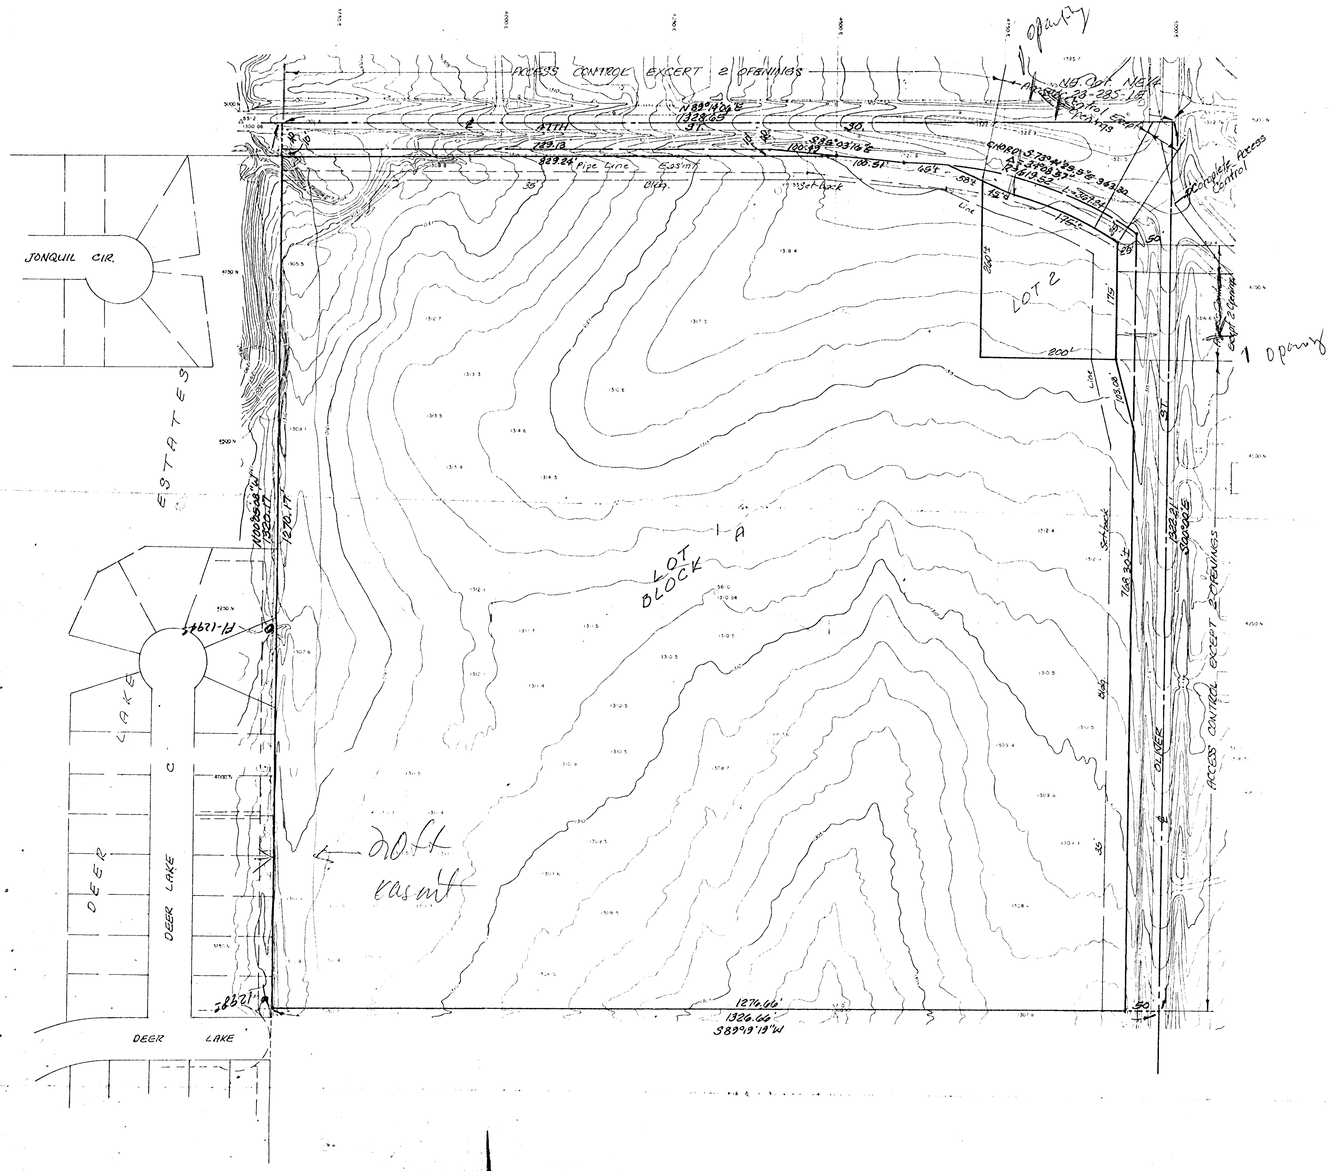

REVISED

PRELIMINARY PLAT

CHELSEA INDUSTRIAL PARK

NE¼ OF THE NE¼ OF SEC. 23 TWP 28-S R-1-E OF THE 6TH P.M., SEDGWICK COUNTY, KANSAS.

OWNER: JEFF GREENBERG

1"=100'
(ASSUMED AZIMUTH)
ELEV = M.S.L.

TOPOGRAPHIC MAP OF LANDS LOCATED AT
N.E. 1/4 SECTION 23, 28S/1E.
SEDGWICK COUNTY, KANSAS

SURVEYING & ENGINEERING
LOWELL D. HIGH, L.S.

PHOTOGRAMMETRY BY
MILES AIR PHOTO & SURVEY
DWIGHT, KANSAS 66849
(913) 482-3550 FILE M-150 P-65

AERIAL PHOTOGRAPHY
TYPE: VERTICAL AT 40% F.O.
ALTITUDE: 1,500 FT. A.M.S.L.
DATE/S OBTAINED OF MAR-1983

BAUGHMAN COMPANY, P.A.
SURVEYING & ENGINEERING
316-262-7271 • 330 LAURA • WICHITA, KANSAS 67211

Rev. 13 DEC 84
6 DEC 83