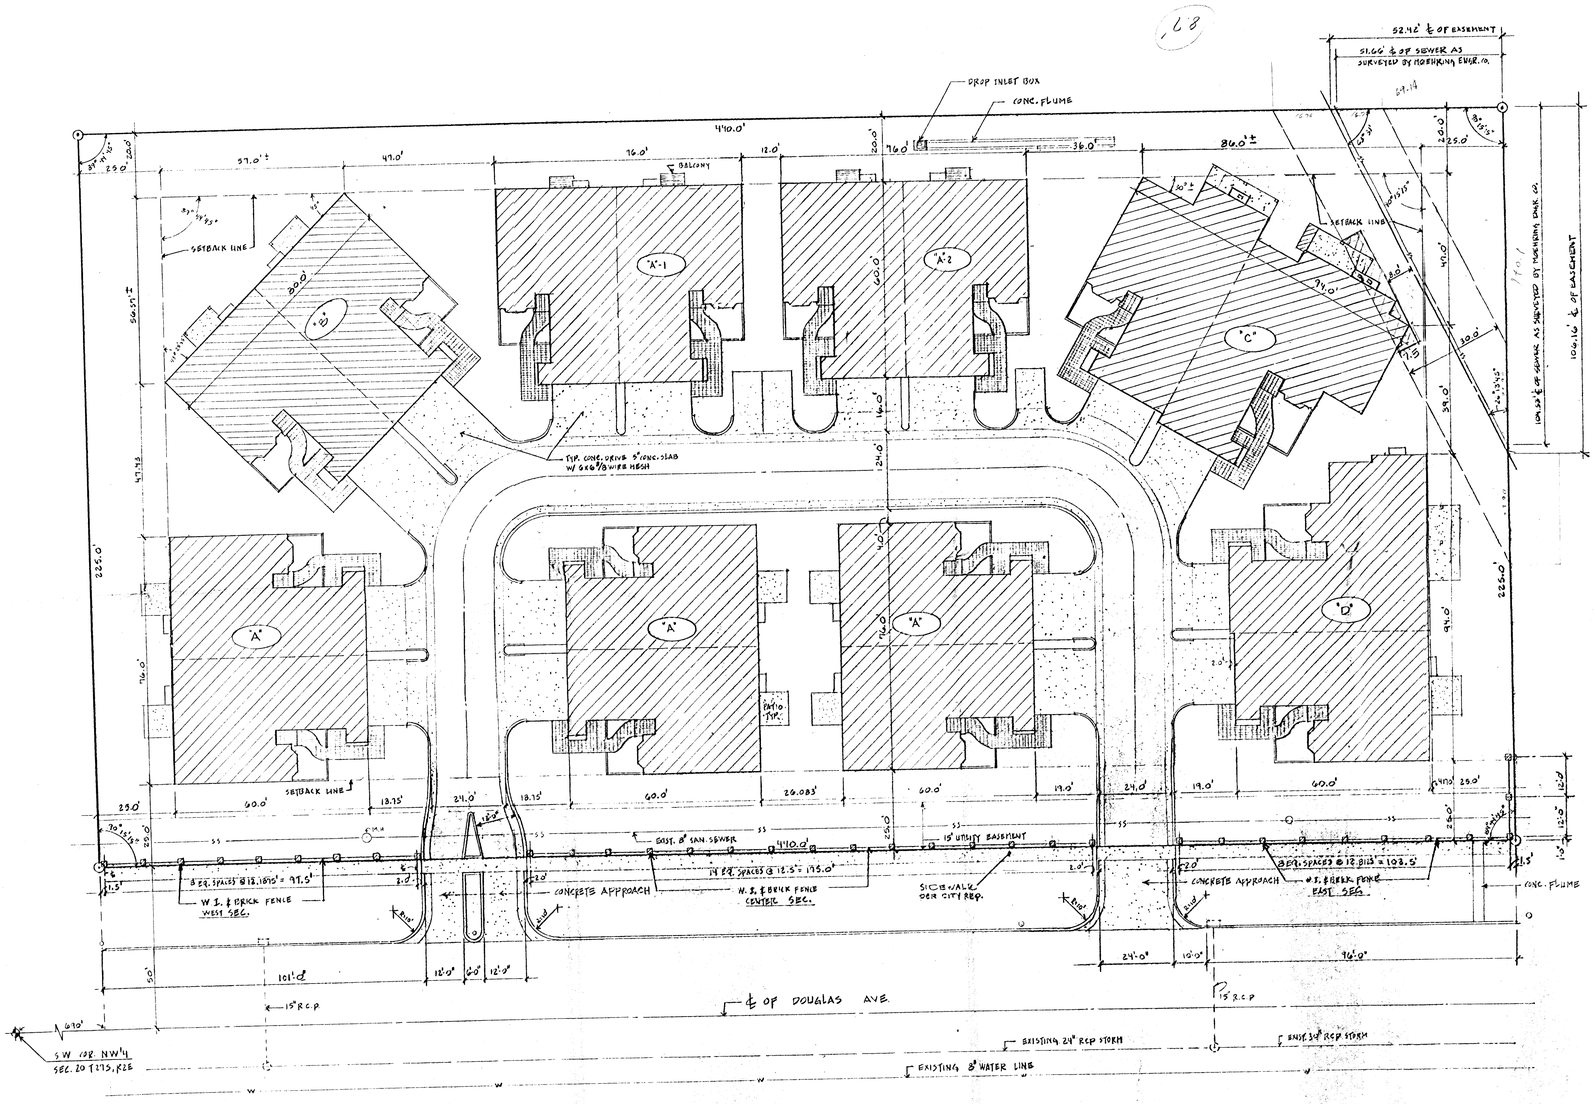

SITE PLAN 1"=20'

LOT 2 OF B&H ADDITION & 40' EAST PART OF THE NW¼ SECTION 20, T27S, R2E

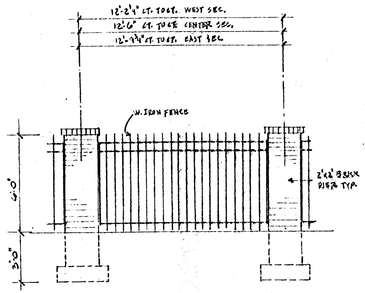

TYP. FENCE ELEV. 1"=1'-0"

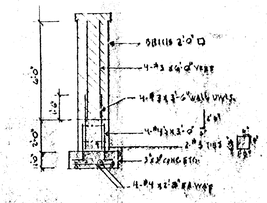

TYP. BRICK PIER SEC.

REVISED 12-18-78, LOCATION OF BUILDINGS A-1, A-2 & C & ADDED 30' SEWER EASEMENT

DEC 18 1978

DEC 18 1978

CALHAIR VILLAGE
COMMERCIAL
EAST

dick brabham
architect
321 so. hydraulic wichita ks.

date
12-5-78
12-14-78

sheet
SITE PLAN
of 1