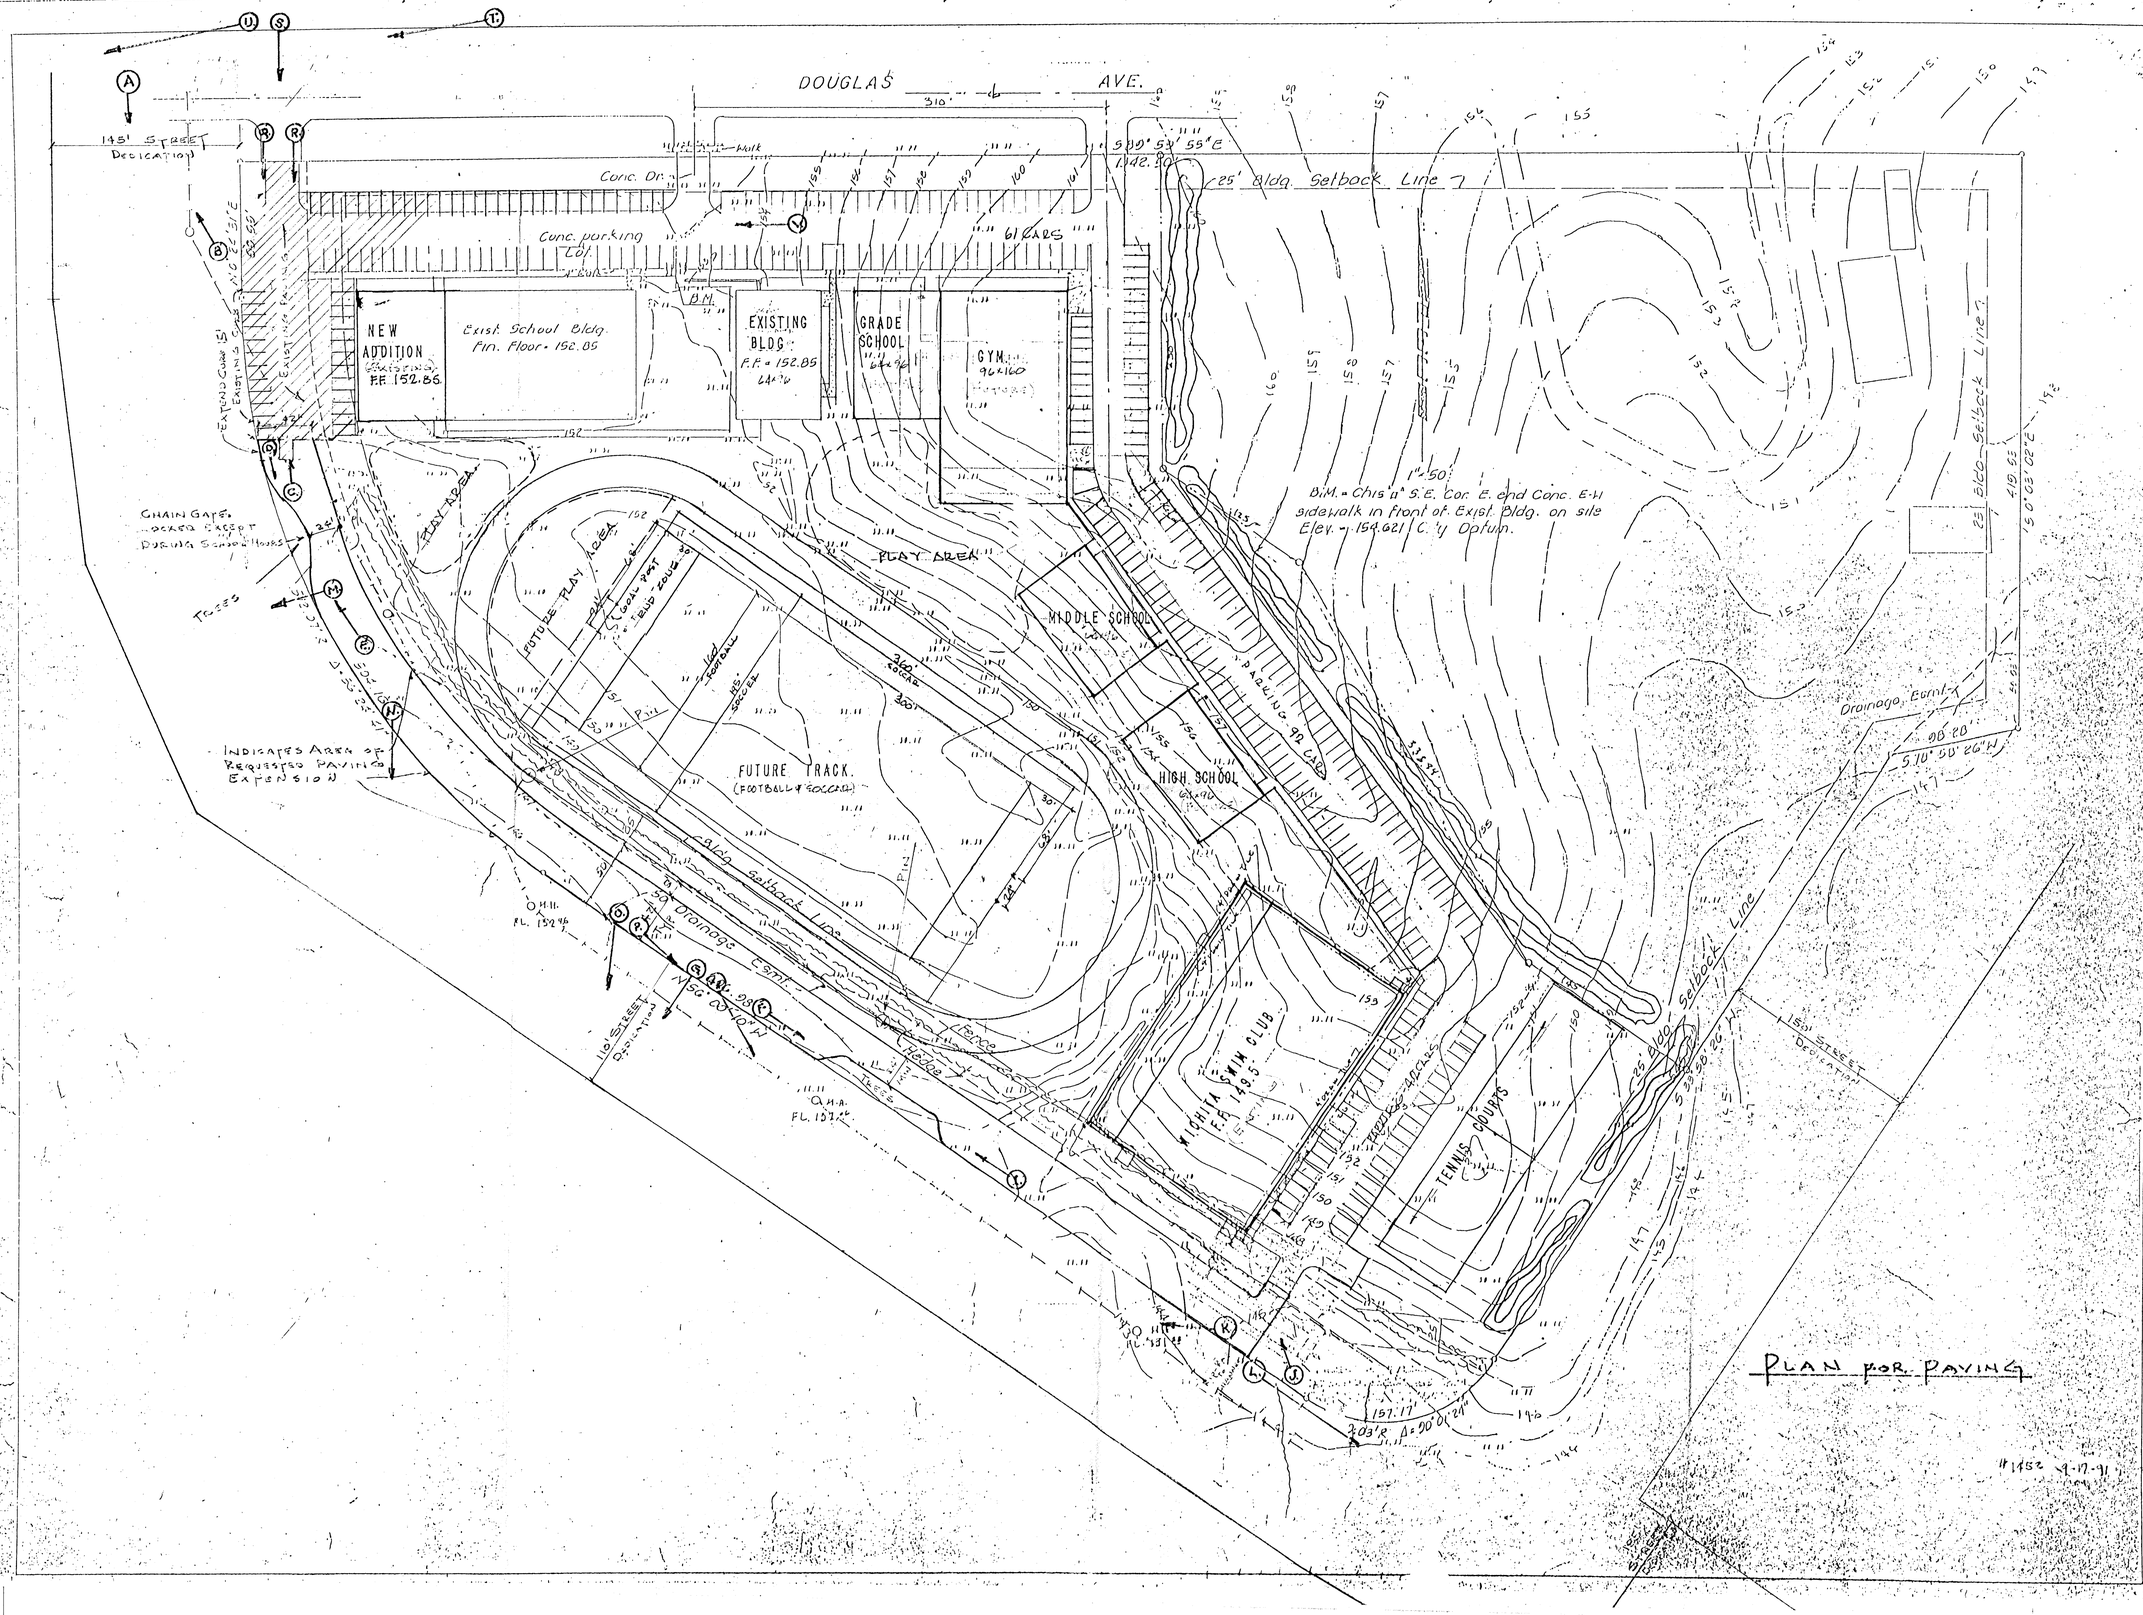

LAWRENCE E. WELLS
ARCHITECT
234 LAURA, SUITE 205
WICHITA, KANSAS 67211

DATE 12-11-91
DRAWN
CHECKED
REVISED

SITE PLAN

AN ADDITION TO
THE INDEPENDENT SCHOOL
WICHITA - KANSAS

PROJECT

PLAN NO.

SHEET 1B OF