
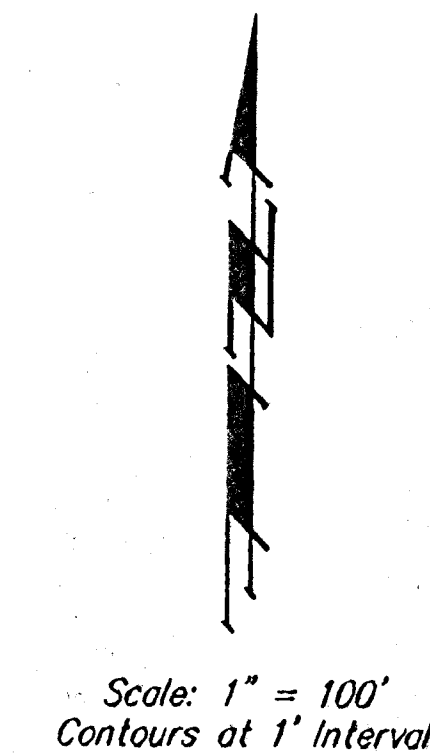


PRELIMINARY PLAT


BRITTAIN INDUSTRIAL PARK

WICHITA, SEDGWICK COUNTY, KANSAS

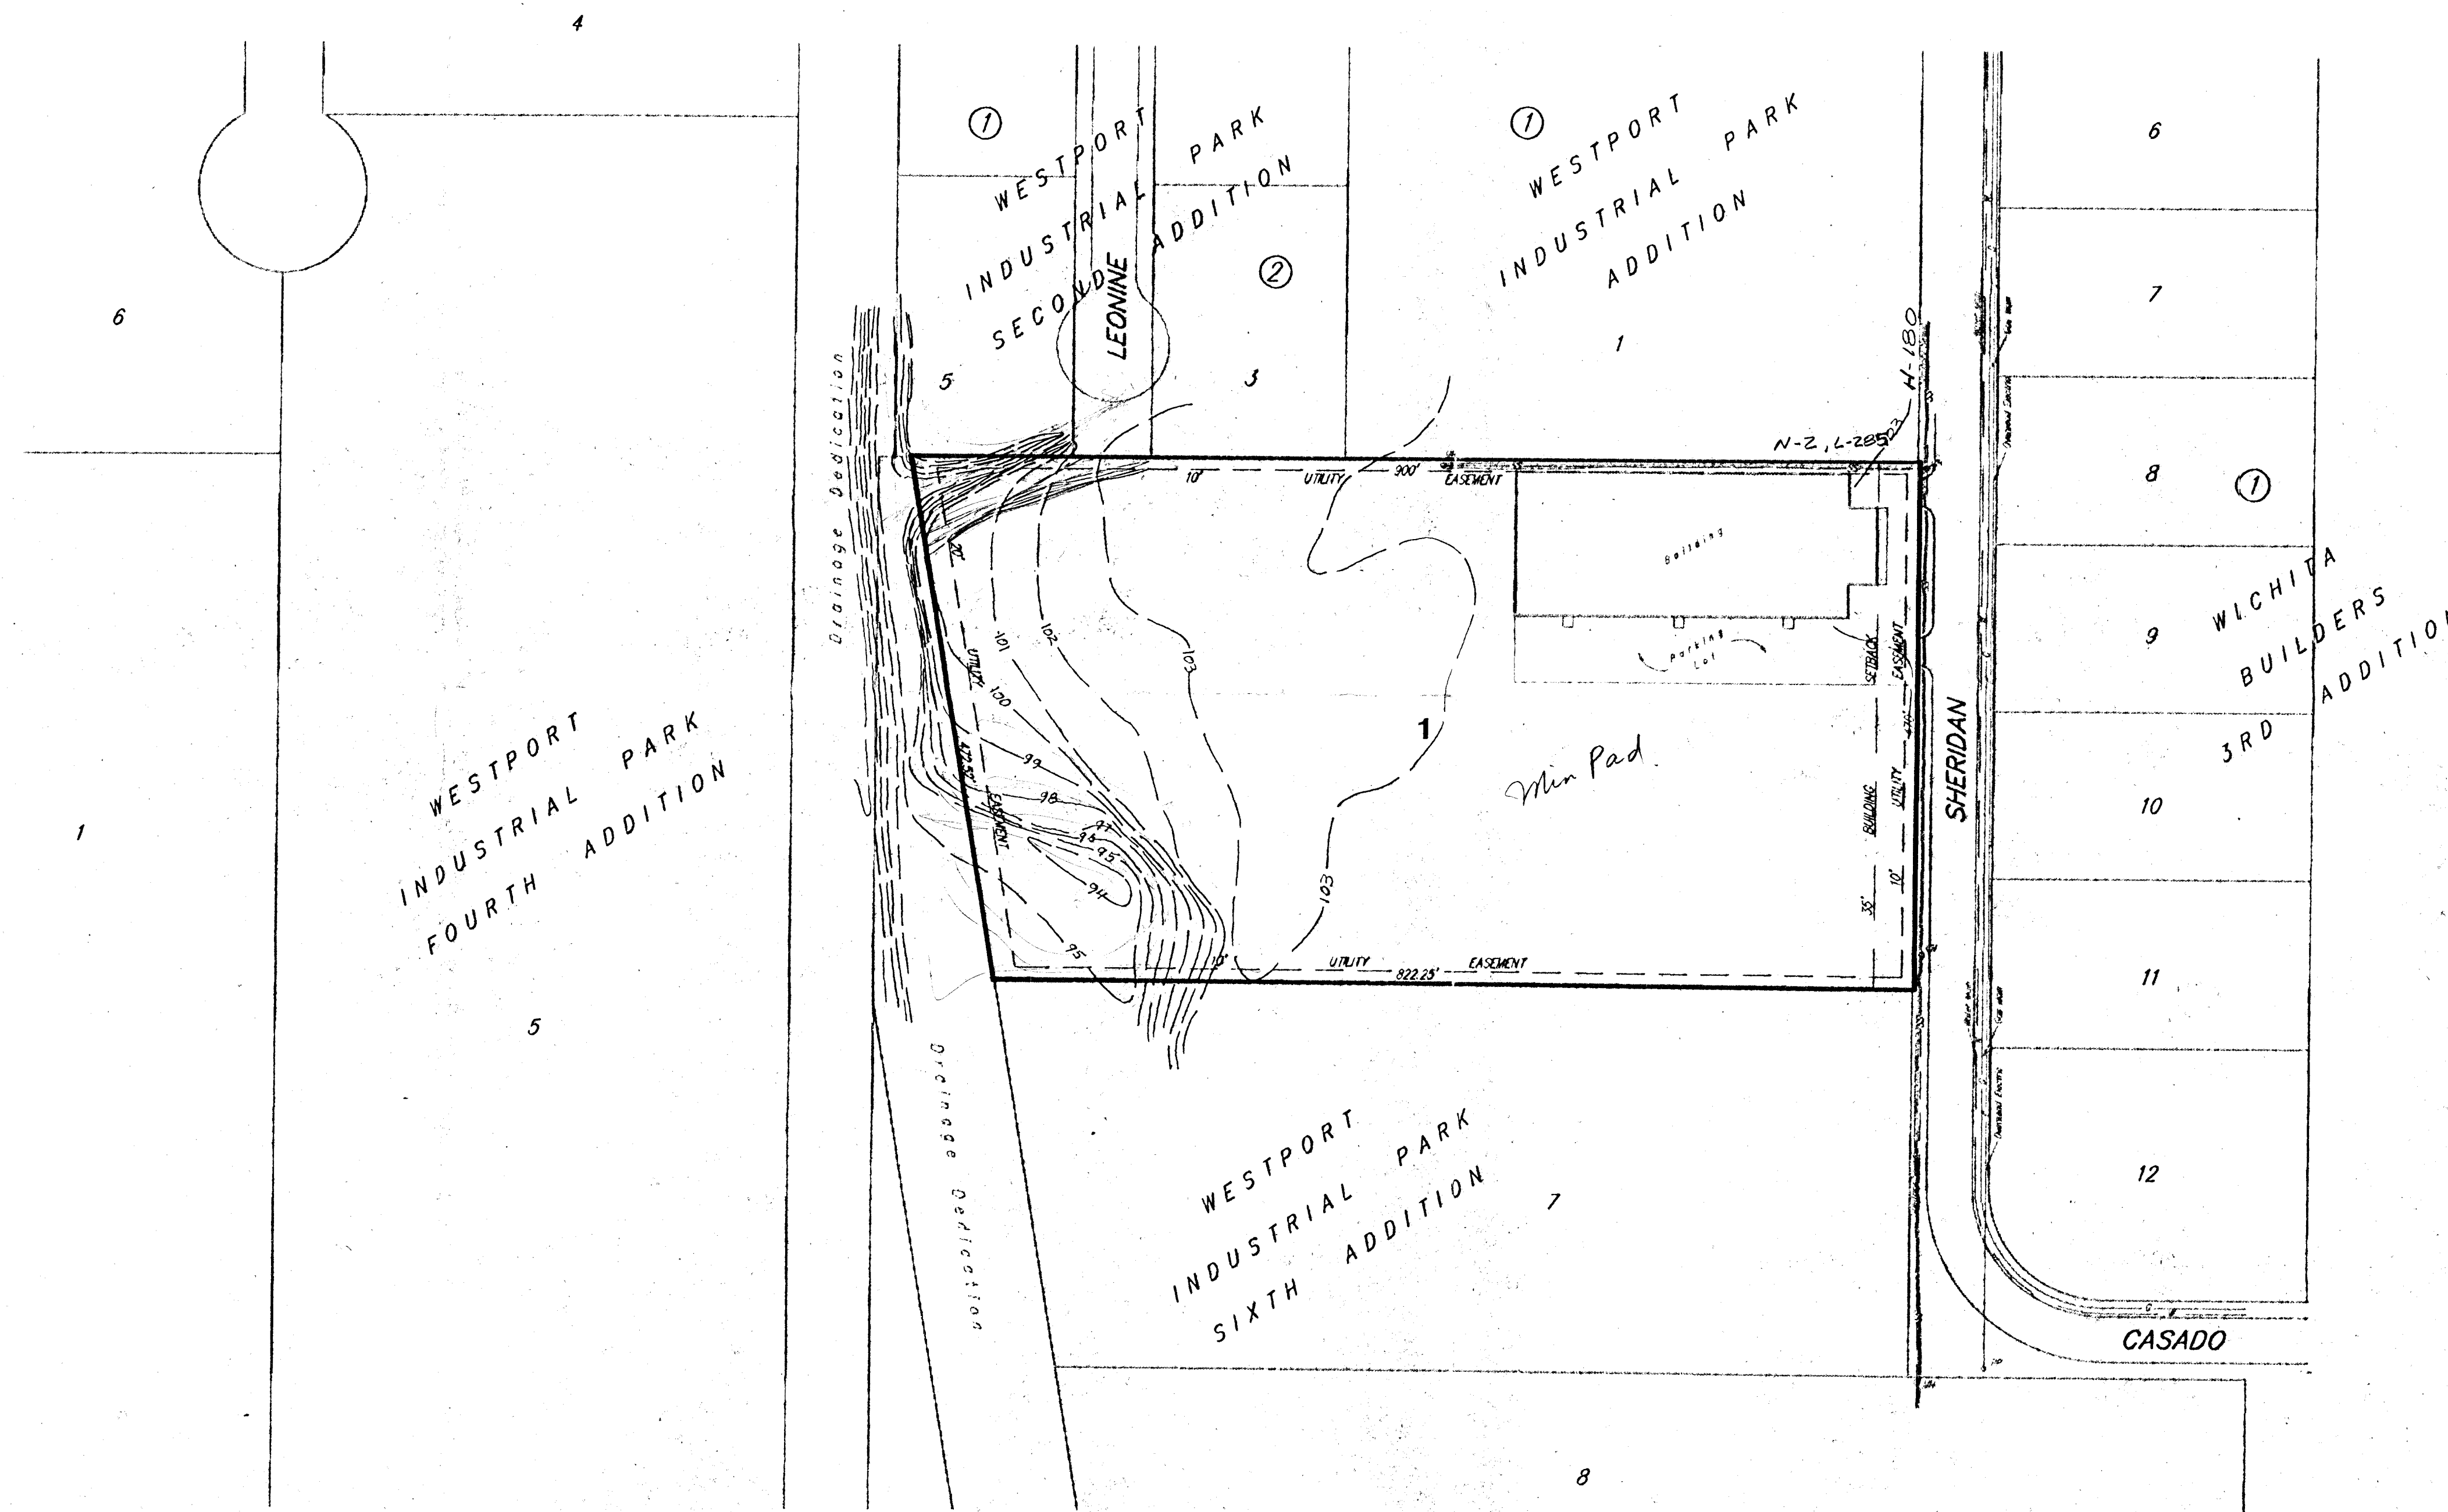

Owner: Dewey Brittain
2520 S. Sheridan
P.O. Box 17227
Wichita, Kansas 67217
(913) 942-8223

Legal Description:
A replat of Lots 1, 2, 3, 4, 5, and 6,
Westport Industrial Park Sixth Addition,
Wichita, Sedgwick County, Kansas.

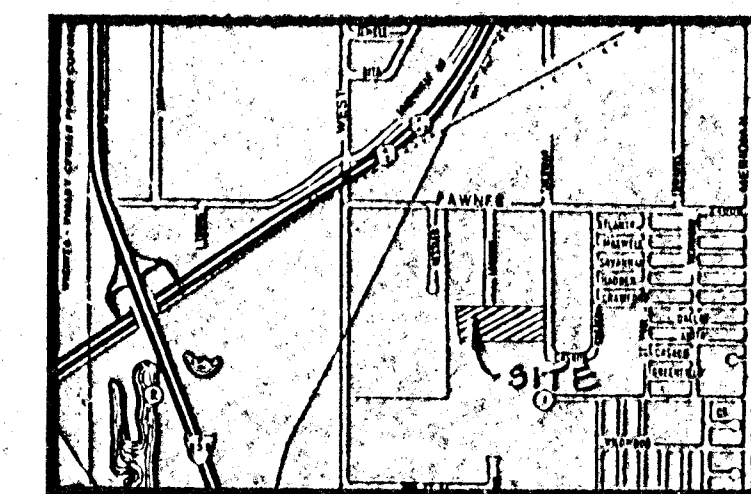

Vicinity Map