


FINAL SURVEY	BY	DATE
SUBMITTED		
PLOTTED		
AREA'S		
NO.		


ORIGINAL SURVEY	BY	DATE
SUBMITTED		
TEMPLATE		
AREA'S		
NO.		

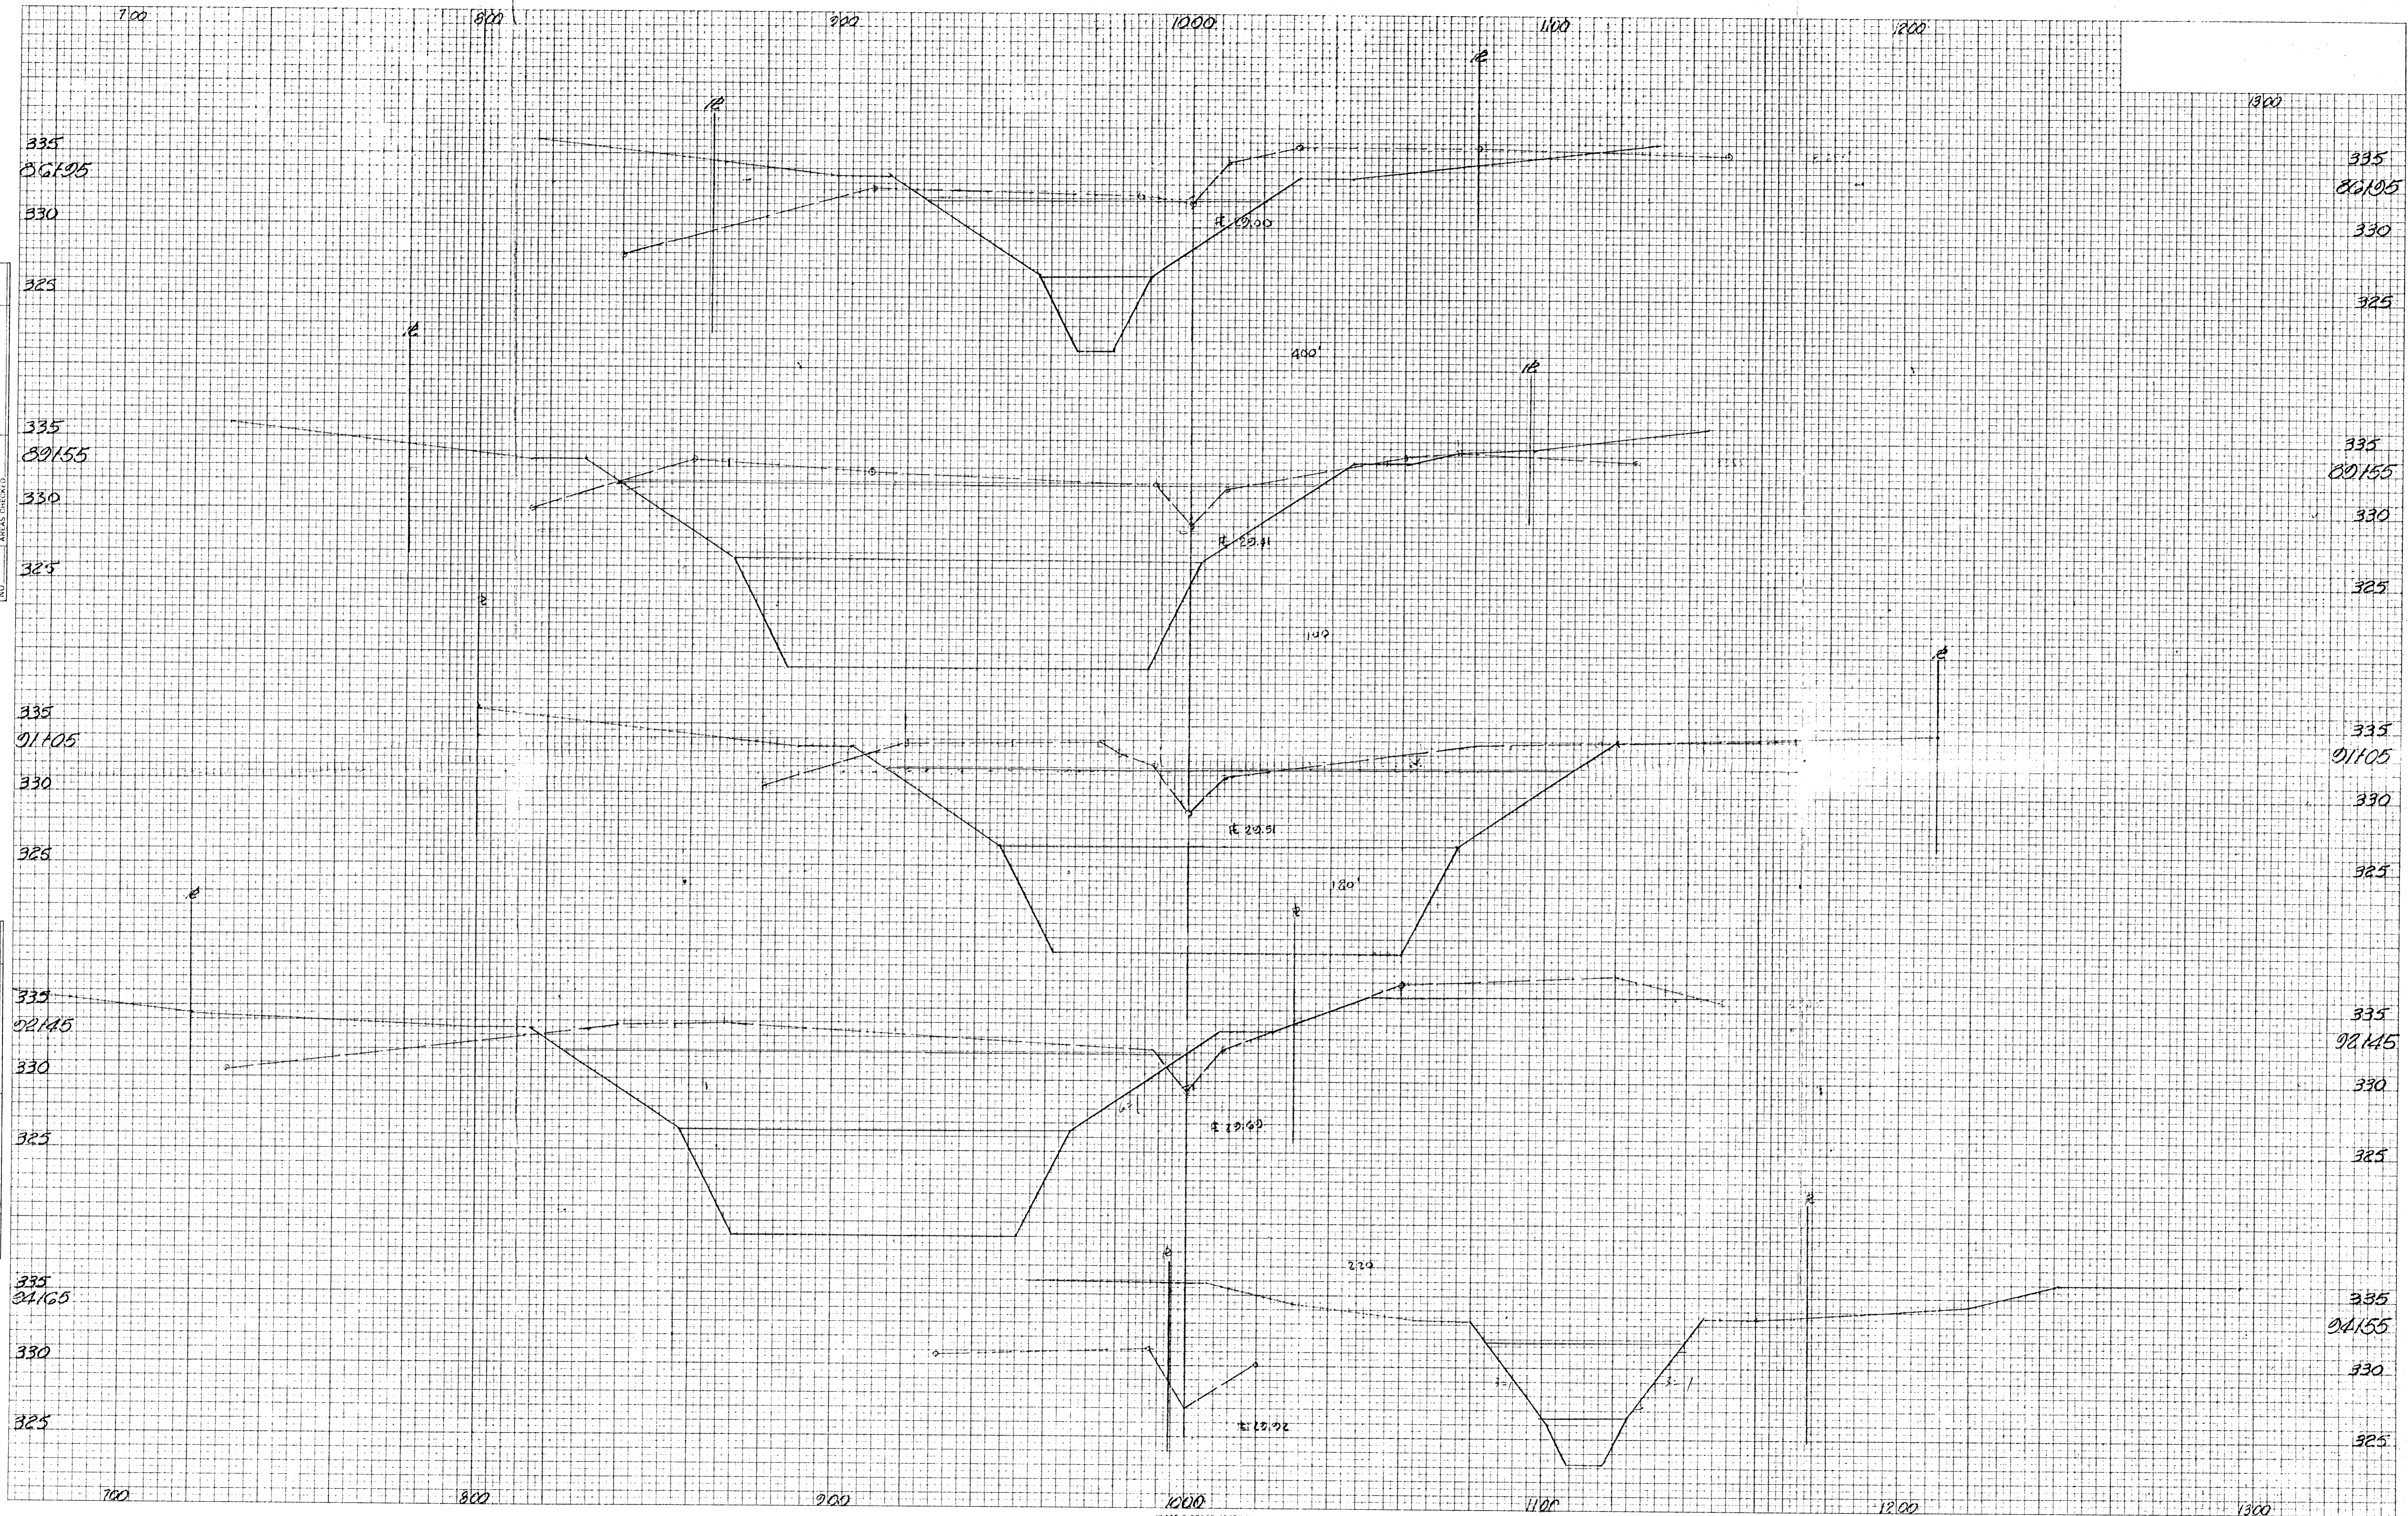

22102-2213

DATE: _____
 BY: _____
 ORIGINAL SURVEY PLOTTED: _____
 NOTE BOOK NO: _____
 AREAS CHECKED: _____

DATE: _____
 BY: _____
 ORIGINAL SURVEY PLOTTED: _____
 NOTE BOOK NO: _____
 AREAS CHECKED: _____

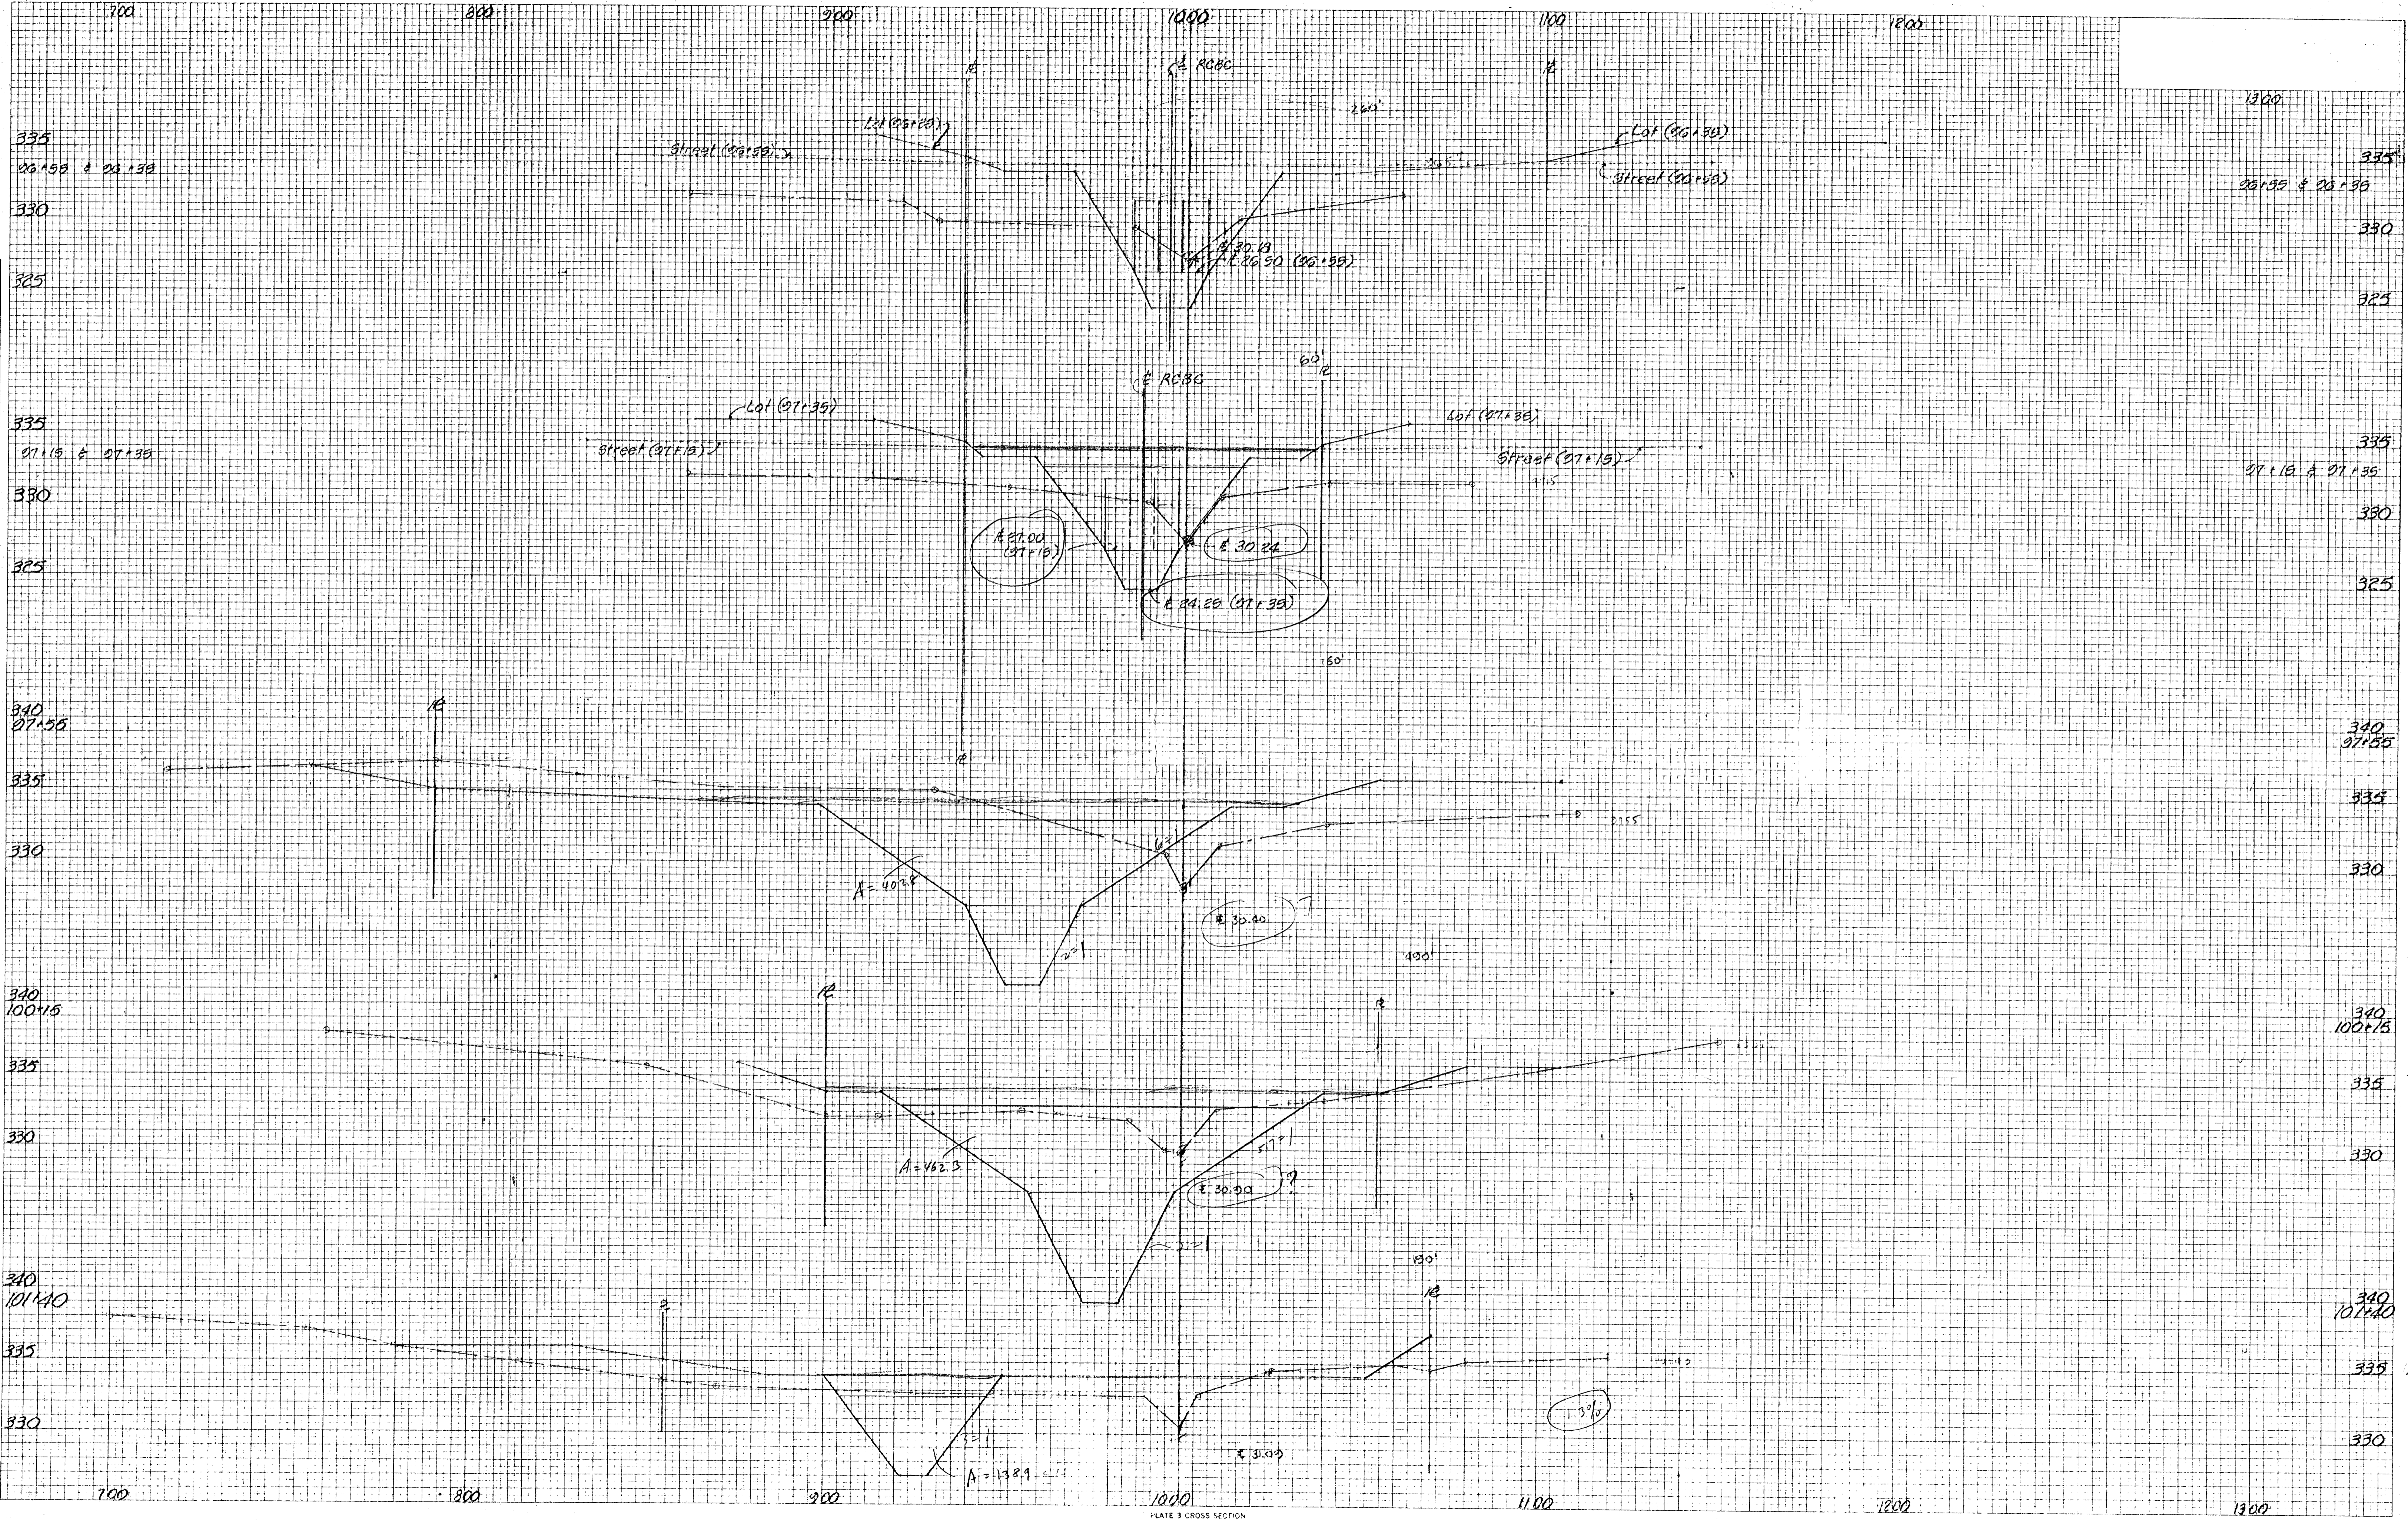

22142402

FINAL SURVEY NOTE BOOK NO. _____

DATE _____

BY _____

QUANTITY PLOTTED _____

TEMPLATE AREA _____

AREAS CALCULATED _____

ORIGINAL SURVEY NOTE BOOK NO. _____

DATE _____

BY _____

QUANTITY PLOTTED _____

TEMPLATE AREA _____

AREAS CALCULATED _____

