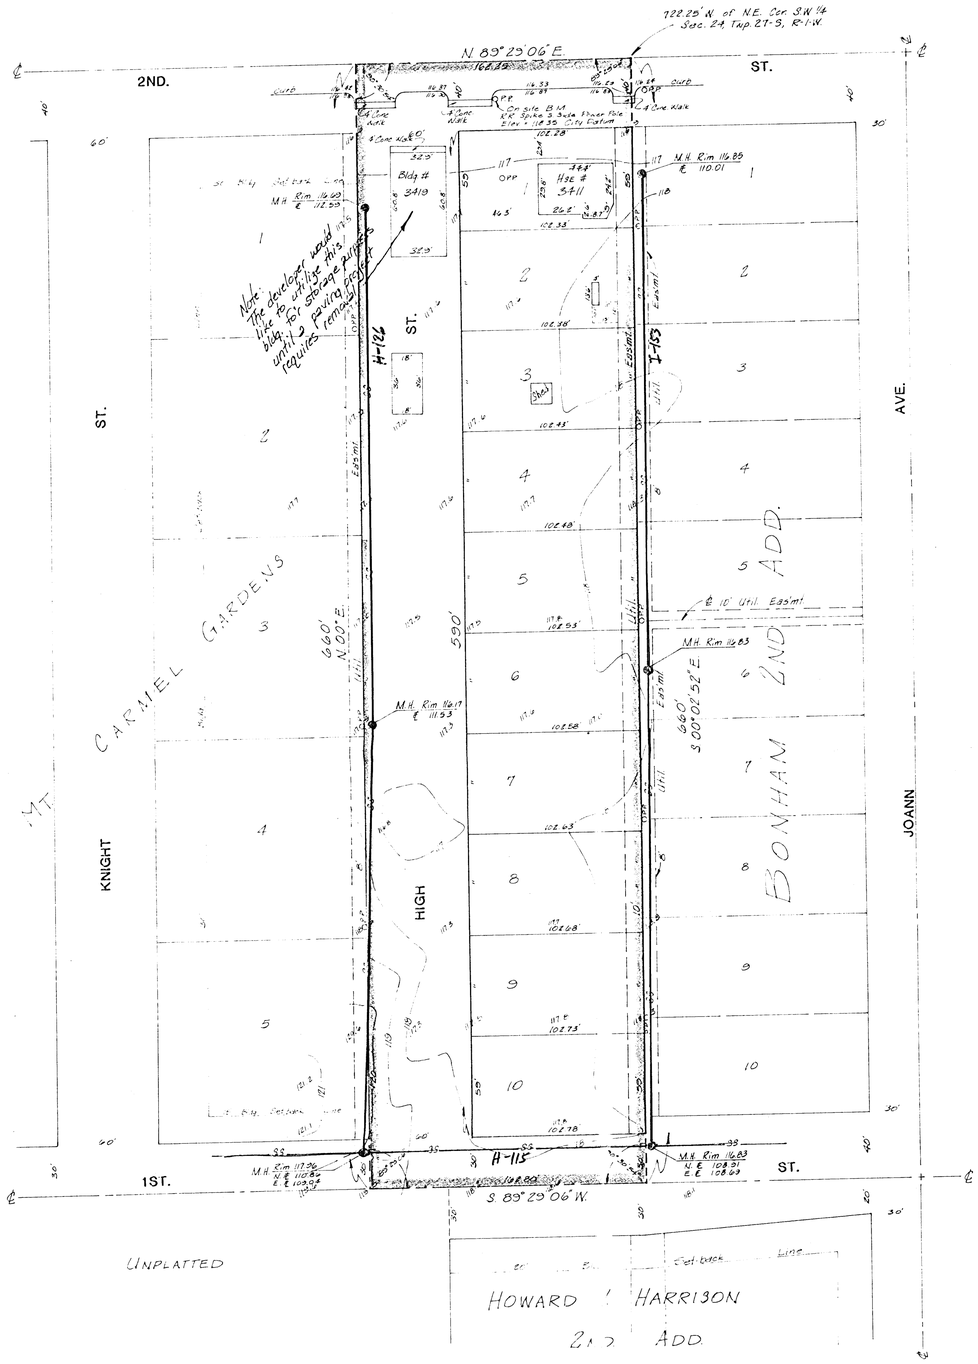

PRELIMINARY PLAT

BADER 3RD ADDITION

PART OF THE S.W. 1/4
SEC. 24, TWP. 27-S., R-1-w W.

GERALD BADER

N

Scale: 1" = 40'
Elevation = City Datum

BENCH MARK:
City Standard Disc. 34 W
± 18' S of ℄ West St
and 2nd St
Elevation = 118.87 City Datum

VICINITY PLAT
1" = 2000'

BAUGHMAN COMPANY, P.A. 6 June 85
SURVEYING & ENGINEERING
316 262-7271 • 330 LAURA • WICHITA, KANSAS 67211