PRELIMINARY PLAT

BALMORAL BRIAR ADDITION

TO SEDGWICK COUNTY, KANSAS

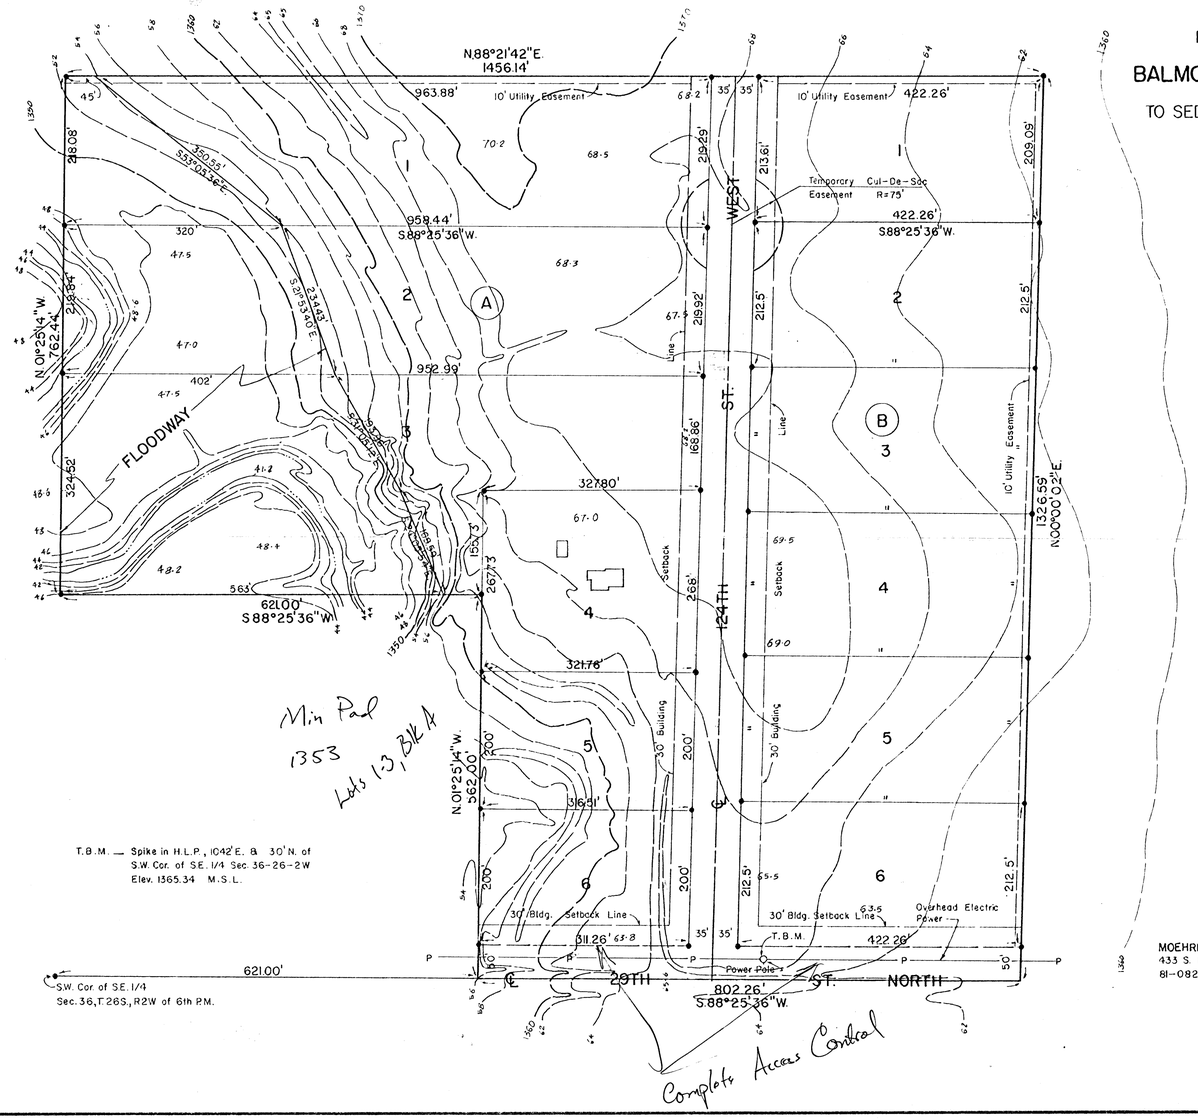

T.B.M. — Spike in H.L.P., 1042'E. & 30'N. of S.W. Cor. of S.E. 1/4 Sec. 36-26-2W Elev. 1365.34 M.S.L.

LEGAL DESCRIPTION

The S.1/2 of the S.E. 1/4 of Sec. 36, T.26 S, R2W. of the 6th P.M., Sedgwick County, Kansas, except the E. 1203.32' thereof, and except the S. 562.00' of the W. 621.00' thereof.

N

1" = 100'
● = Iron

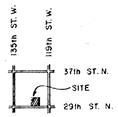

VICINITY MAP

MOEHRING & ASSOCIATES CONSULTING ENGINEERS
433 S. HYDRAULIC WICHITA, KANSAS
81-082-SD. AUGUST, 1981

DON L. MOEHRING II
LICENSED
3453
KANSAS
PROFESSIONAL ENGINEER