
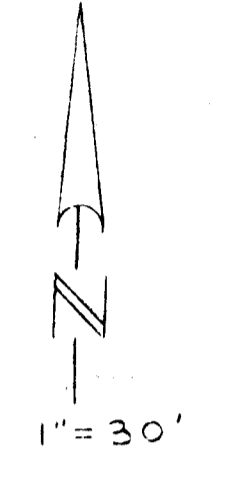


5/25/70  
20-4

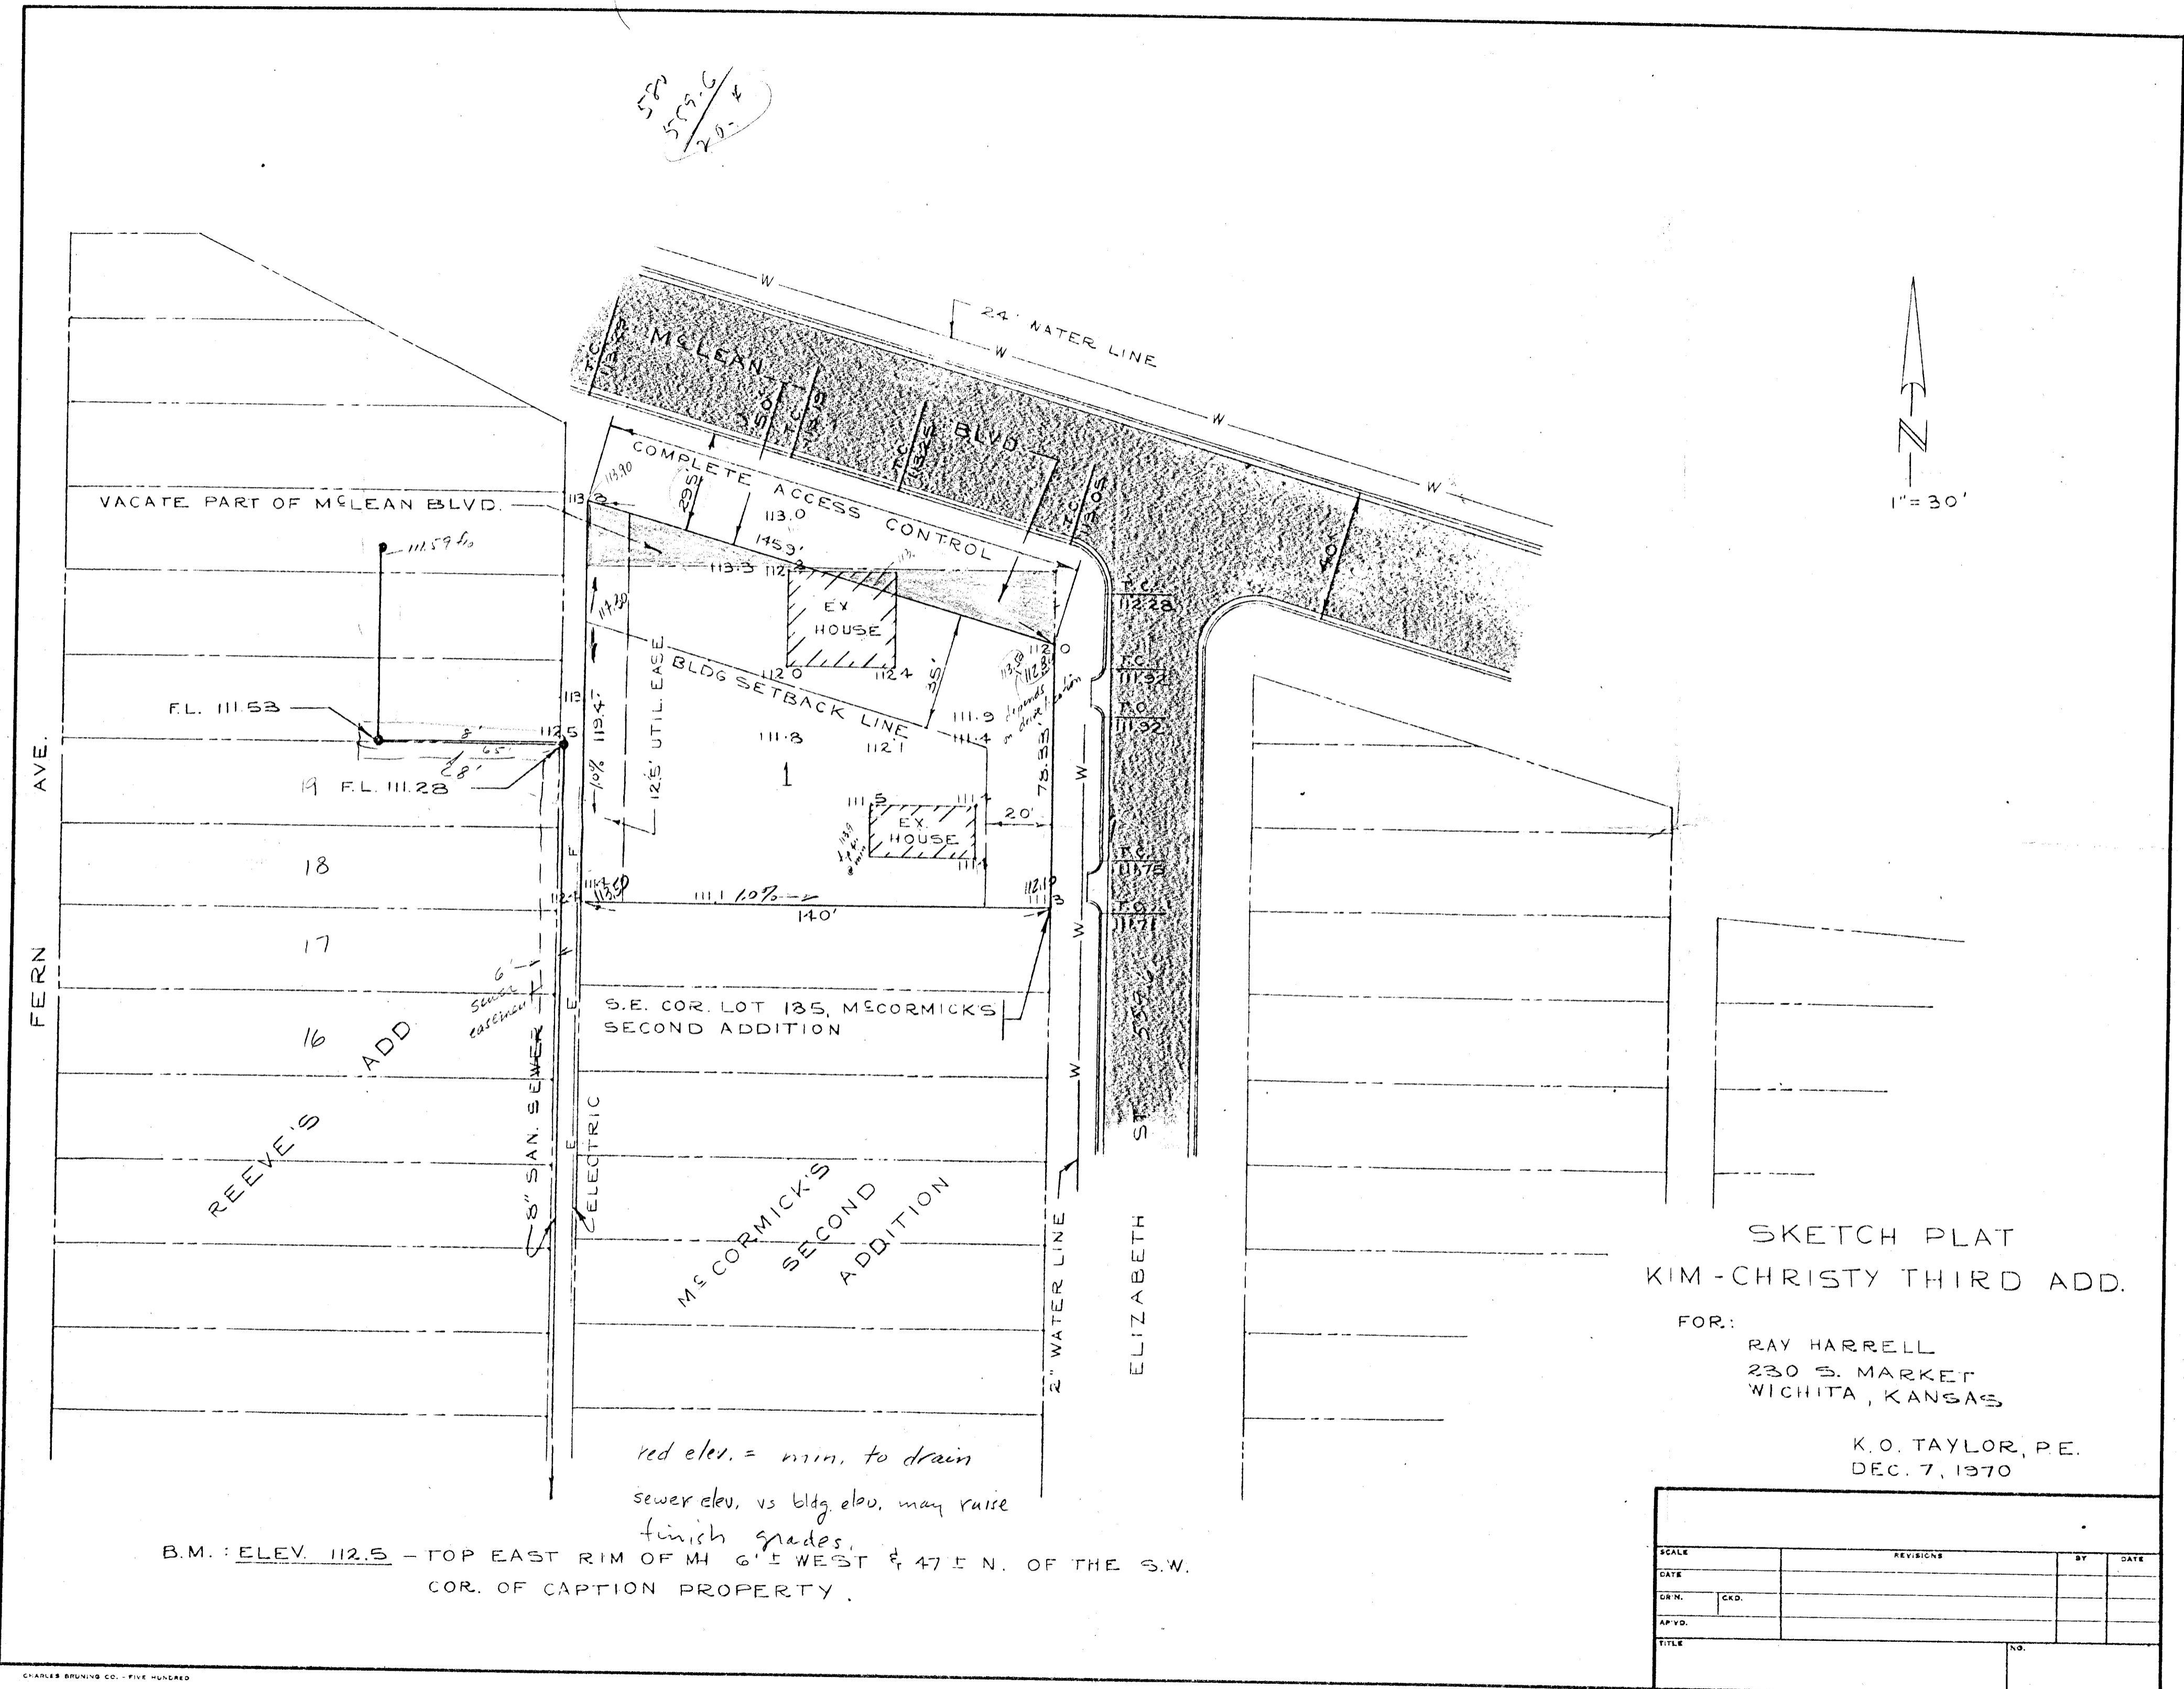

SKETCH PLAT  
KIM-CHRISTY THIRD ADD.

FOR:  
RAY HARRELL  
230 S. MARKET  
WICHITA, KANSAS

K.O. TAYLOR, P.E.  
DEC. 7, 1970

red elev. = min. to drain  
sewer elev. vs bldg elev. may raise  
finish grades.

B.M.: ELEV. 112.5 - TOP EAST RIM OF M4 6" I WEST & 47' N. OF THE S.W.  
COR. OF CAPTION PROPERTY.

SCALE		REVISIONS		BY	DATE
DATE					
DRN.	CKD.				
APVD.					
TITLE					