


CAMPUS VALLEY ADDITION

WICHITA, KANSAS.

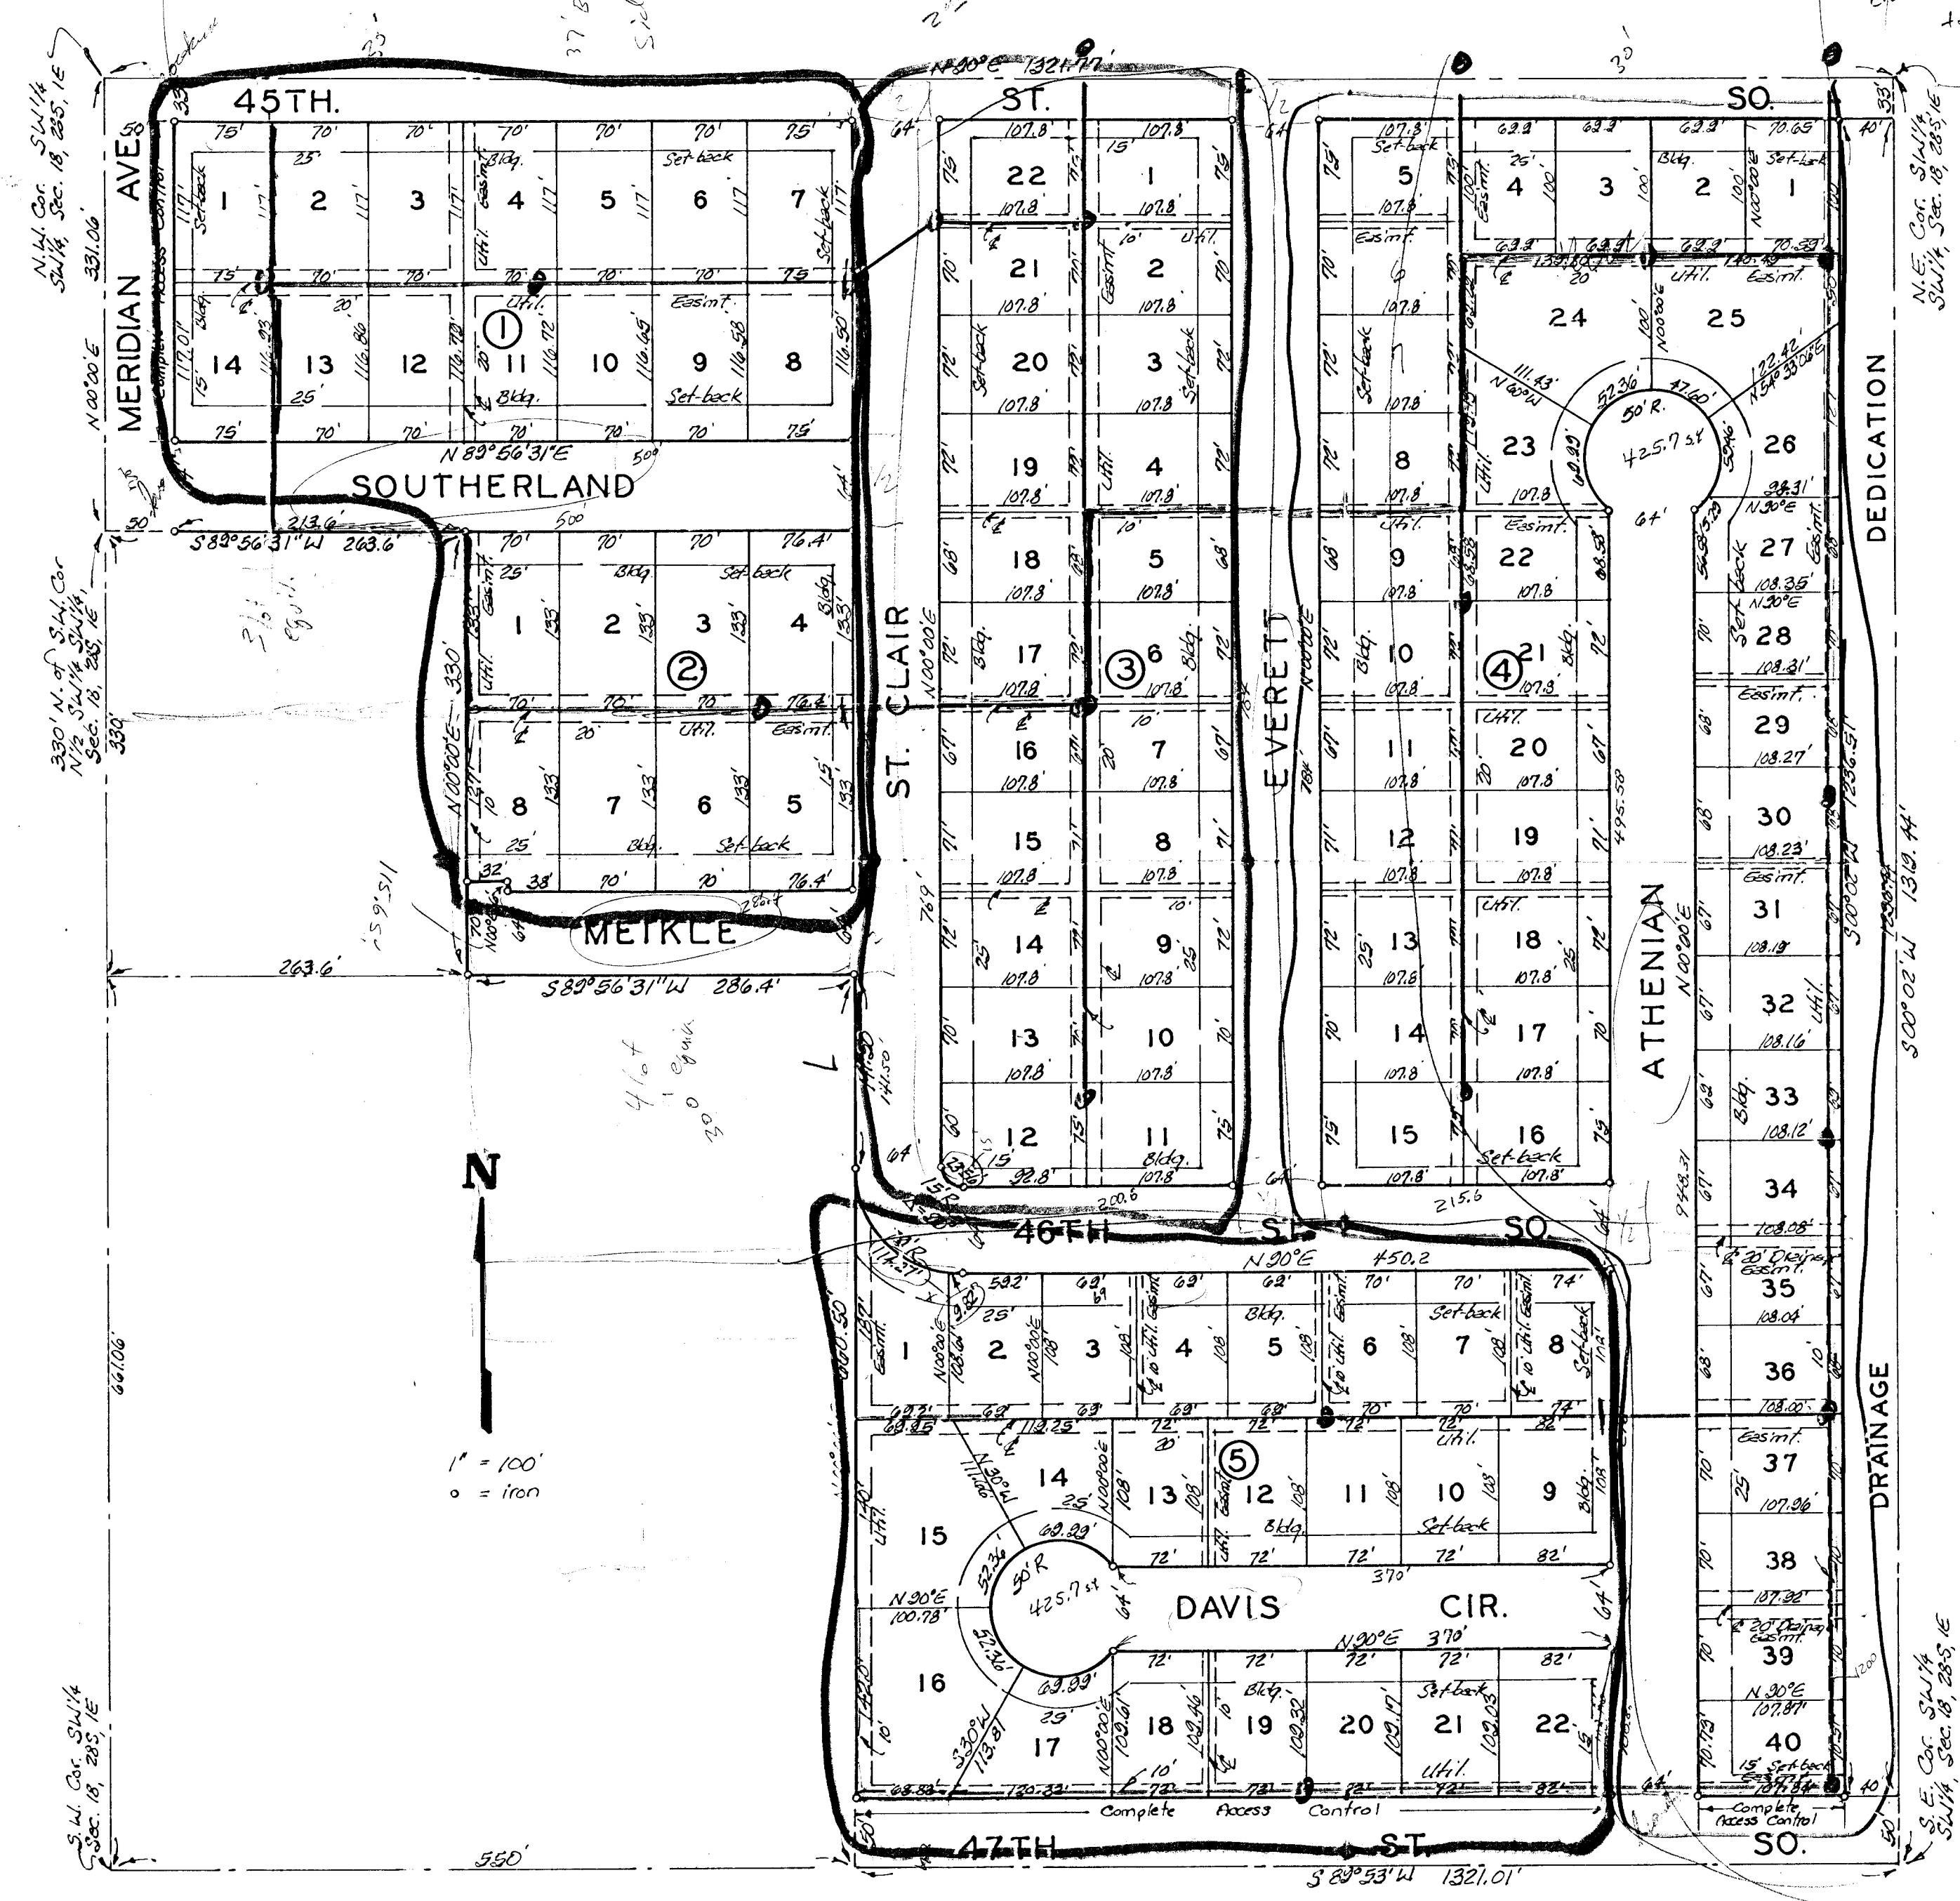

State of Kansas, S.S. We, Baughman Company, P.A., Surveyors in and said county and state do hereby certify that we have surveyed and platted "CAMPUS VALLEY ADDITION" Wichita, Kansas, and that the accompanying plat is a true and correct exhibit of the property surveyed, described as being the S 1/2 of the SW 1/4 of the SW 1/4 of Sec. 18, Twp. 28-S, R-1-E, of the 6th P.M., Sedgwick County, Kansas, except the west 550 feet thereof, together with the N 1/2 of the SW 1/4 of said SW 1/4, except the west 263.6 feet of the south 330 feet thereof.

Baughman Company, P.A.

Date _____
William L. Korber Surveyor

Know all men by these presents that we the undersigned, have caused the land described in the surveyors certificate to be platted into Lots, Blocks, Streets and a Drainage Dedication, to be known as "CAMPUS VALLEY ADDITION" Wichita, Kansas. The easements are hereby granted as indicated for the construction and maintenance of all public utilities. The Drainage Dedication is hereby dedicated for drainage purposes. The streets are hereby dedicated to and for the use of the public. All abutters rights of Access to or from Meridian Ave., over and across the west line of Lots 1 and 14, Block 1 and to or from 47th St. So. over and across the south line of Lot 40, Block 4 and Lots 16, 17, 18, 19, 20, 21, and 22, Block 5, are hereby granted to the City of Wichita, Kansas.

Herbert V. Peebler Lena P. Peebler

State of Kansas, S.S. The foregoing instrument was acknowledged before me this _____ day of _____ 1980, by Herbert V. Peebler and Lena P. Peebler, his wife.

Notary Public

My Comm. Exp. _____
1" = 100'

This plat of "CAMPUS VALLEY ADDITION", Wichita, Kansas, has been submitted to and approved by the Wichita-Sedgwick County Metropolitan Area Planning Commission, Wichita, Kansas. Dated this _____ day of _____ 1980.

Wichita-Sedgwick County Metropolitan Area Planning Commission.

William J. Goebble Chairman

Robert A. Lakin Secretary

This plat approved and all dedications shown hereon accepted by the Board of Commissioners of the City of Wichita, Kansas, this _____ day of _____ 1980.

Tony Casarolo Mayor

Donald C. Gursick City Clerk

This plat approved and all dedications shown hereon accepted by the Board of Commissioners, Sedgwick County, Kansas, this _____ day of _____ 1980.

Tom Scott Chairman

Everett Patrick Commissioner

Donald E. Graag Commissioner

Dorothy K. White County Clerk

Entered on transfer record this _____ day of _____ 1980.

Dorothy K. White County Clerk

State of Kansas, S.S. This is to certify that this plat has been filed for record in the office of the Register of Deeds, this _____ day of _____ 1980 at _____ o'clock _____ M., and is duly recorded.

Bette F. Meant Register of Deeds

Pat Kettler Deputy