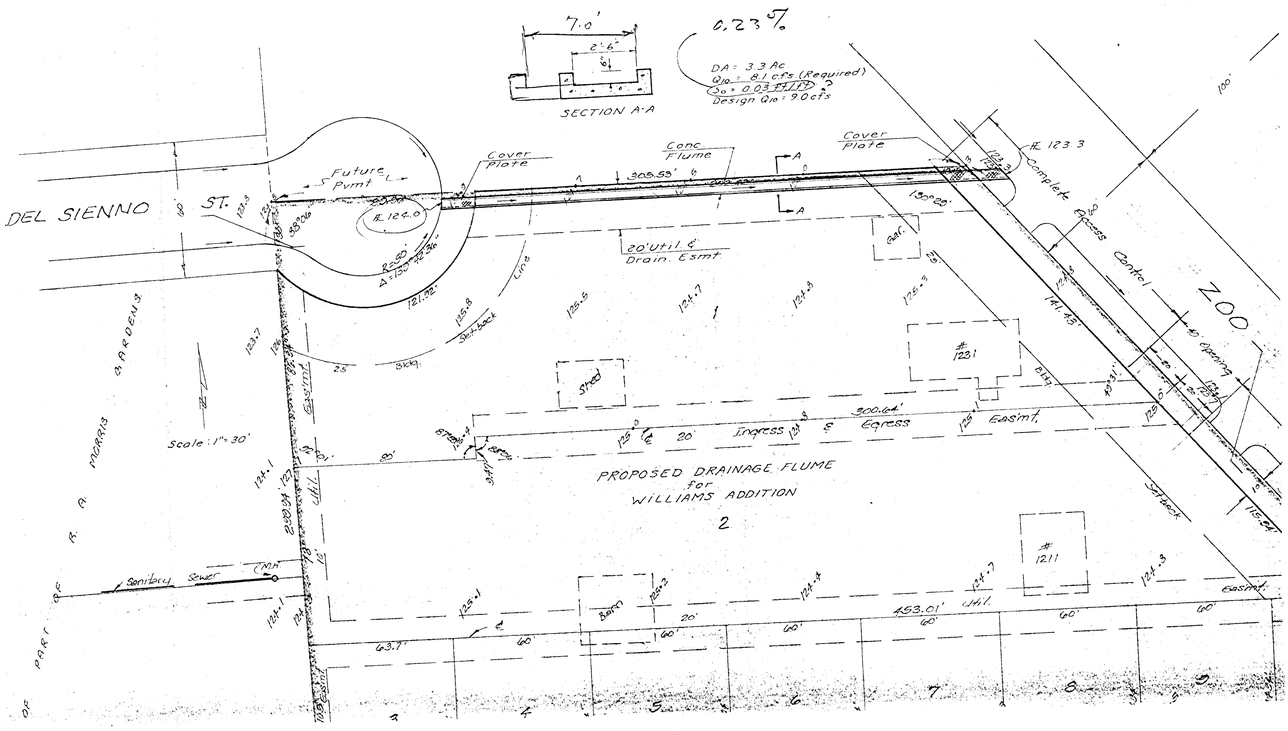
7.0'
2'-6"
SECTION A-A
0.23%
DA = 3.3 Ac
Q10 = 8.1 cfs (Required)
So = 0.03 ft/ft > 2
Design Q10 = 9.0 cfs
DEL SIENNO ST.
Future Pvmt
Cover Plate
Conc Flume
306.55'
Cover Plate
FL 123.3
FL 124.0
20' Util & Drain. Esmt.
Garage
Shed
Scale: 1" = 30'
PROPOSED DRAINAGE FLUME
for
WILLIAMS ADDITION
2
Ingress & Egress
300.64'
Sanitary Sewer
Barn
153.01'
Util.
Easmt.
Zoo
Parking
Setback
