

MC CORMICK
NOW
HIDDEN VALLEY ROAD


DRAINAGE CONCEPT

SCALE: 1" = 40'
FILE #3871507
8 MAY, 1997

Will be served by Combined
Interceptor Mainline
Provide Retention & Easement
for future San. Sewer Ext.
Min Pad Req'd = 1317.40 MSW
= 130 City Detm
Floodway limits questionable

FLOOD STUDY
CROSS-SECTION A
BASE FLOOD 1316.4

LOCATION MAP

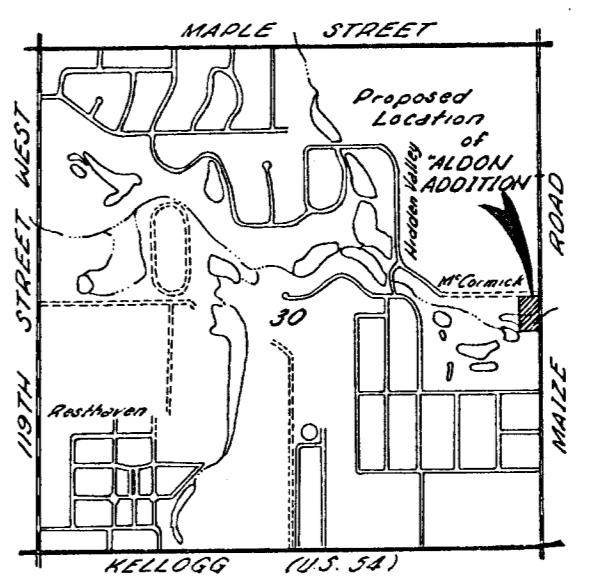

SCALE: 1" = 2000'

GENERAL NOTES:

Closest water main is 16" AC located
at intersection of Maple & Maize.
Sanitary Sewer located approx. 1/2 mile South
and 1/4 mile East of site. (Main B, SW
Interceptor - 15" VCP. Storm in Book 1, Pg. 263)