


**PHASE 1**  
 4210 LF  
 ~94 lots  
 = 44.8 LF/Lot  
 BK 2, lots 38-41  
 BK 3, lots 27-35  
 BK 4, lots 1-34  
 BK 5, lots 2-8

**PHASE 2**  
 3000 LF  
 ~71 lots  
 = 42.3 LF/Lot  
 BK 1, lots 2-9  
 BK 2, lots 1-37  
 BK 3, lots 1-26

**PHASE 3**  
 960 LF  
 ~1 lot  
 BK 5, lot 1

**PHASE 4**  
 1380 LF  
 ~32 lots  
 = 43.1 LF/Lot  
 BK 4, lots 35-40  
 BK 5, lots 9-34

**PHASE 5**  
 1040 LF  
 ~1 lot  
 BK 1, lot 1

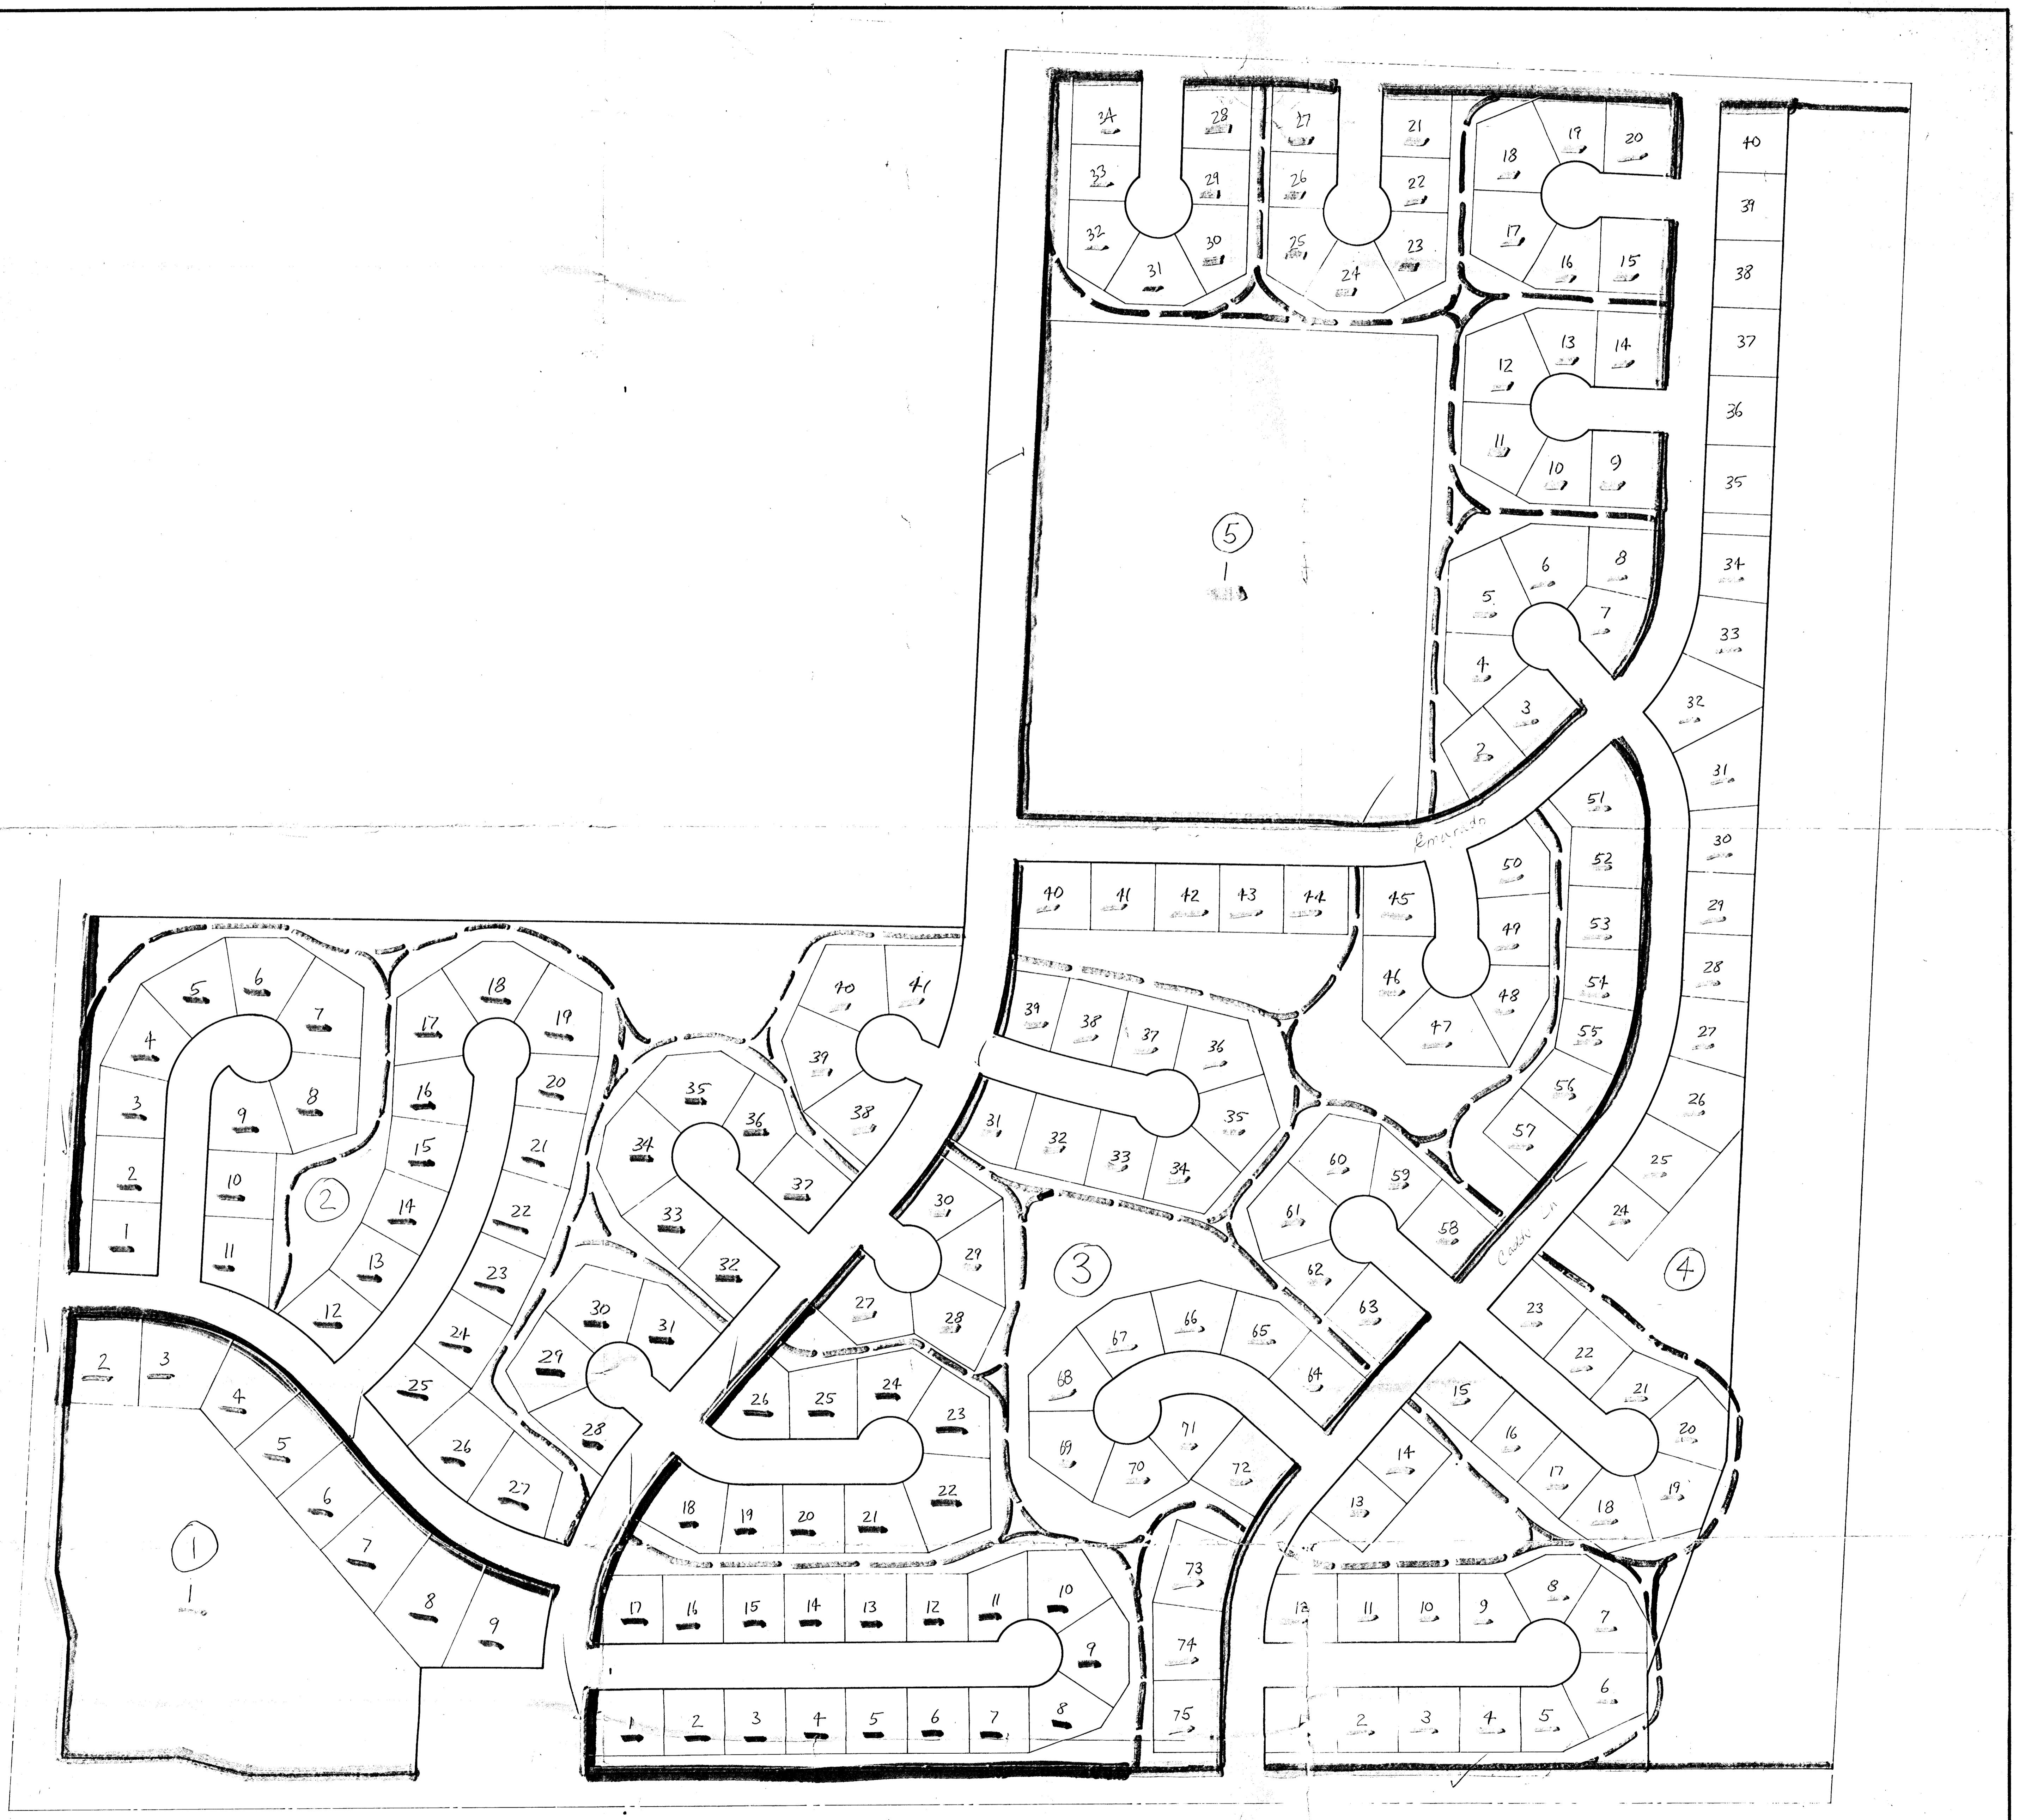

REVISED SIDEWALK PLAN  
**AMARADO ESTATES**

OWNER : AMARADO INVESTMENTS CO INC.  
 230 SOUTH MARKET  
 WICHITA KANSAS

LAND PLANNER : OBLINGER SMITH CORPORATION  
 625 FIRST NATIONAL BANK BLDG.  
 WICHITA, KANSAS

LEGEND  
 ——— SIDEWALKS ON PUBLIC STREET R.O.W.  
 - - - - SIDEWALKS ON PRIVATE OPEN SPACE.

NORTH  
 SCALE 1"=100'

Accepted By  
 METROPOLITAN AREA PLANNING DEPT. DATE