SKETCH PLAT
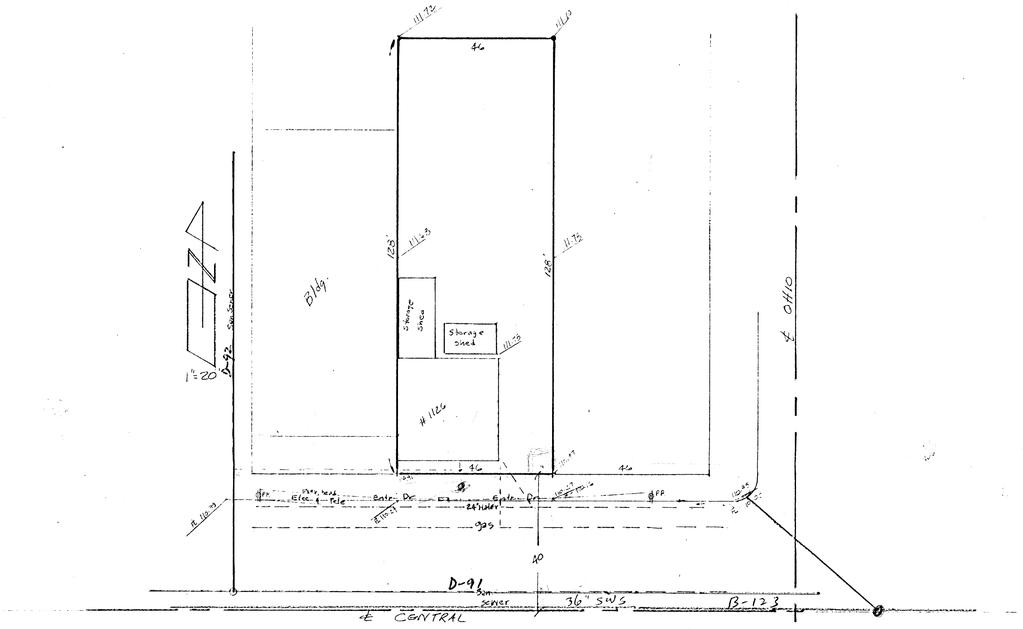
DAVIDSON AND FRAY ADD.