SKETCH PLAT
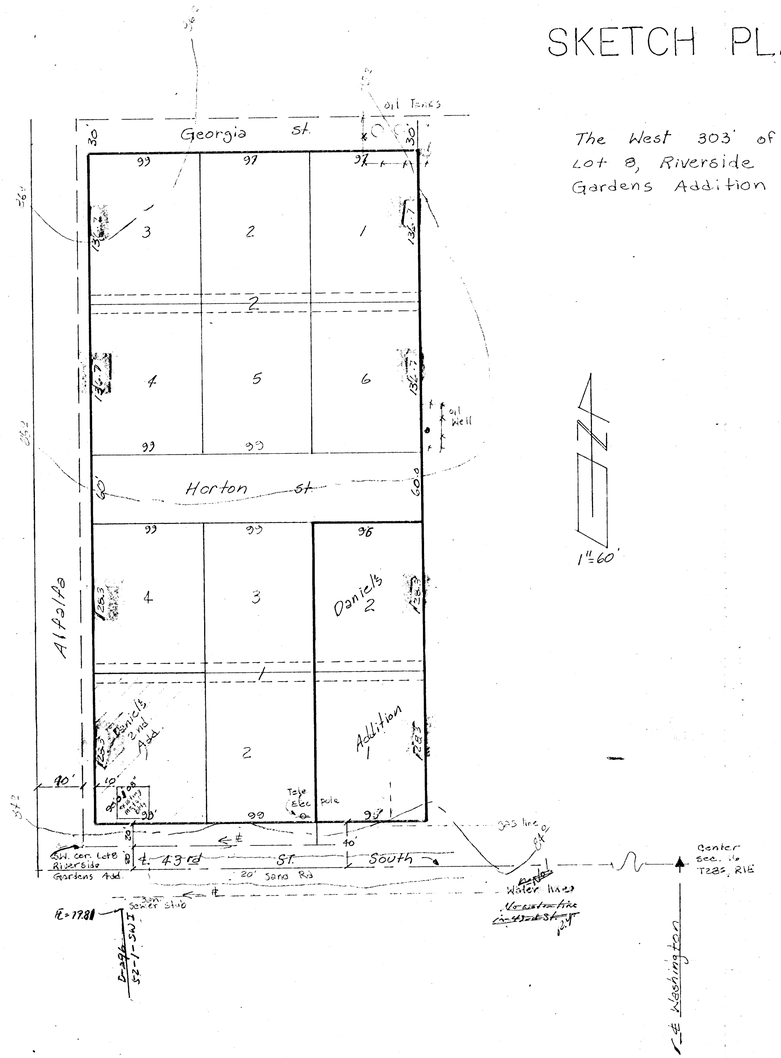
The West 303' of Lot 8, Riverside Gardens Addition