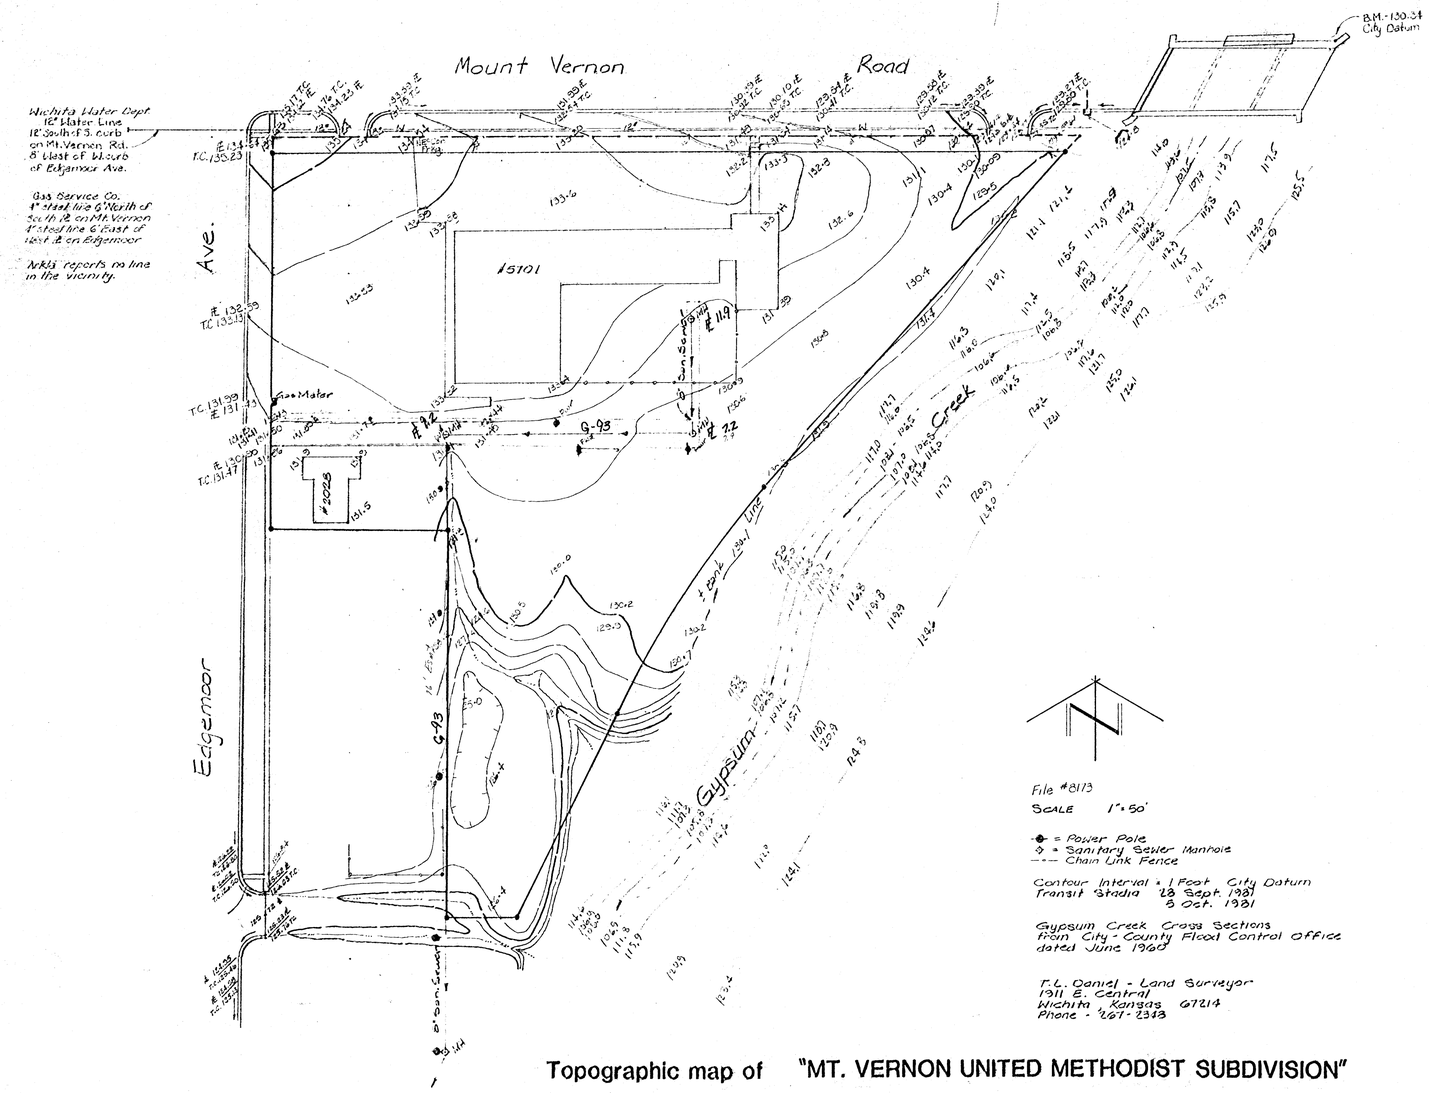

Topographic map of "MT. VERNON UNITED METHODIST SUBDIVISION"