



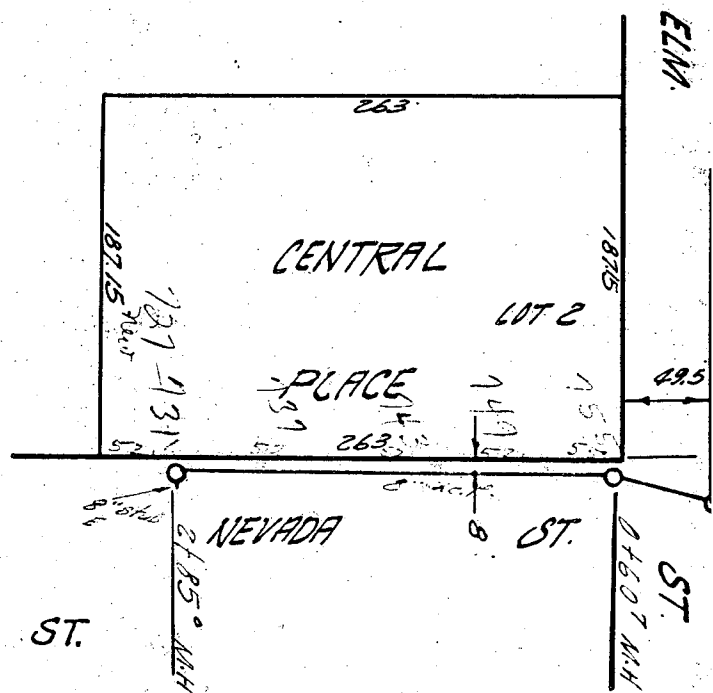

LATERAL 33 SUB 5 S.S. &
 W.B. CARTER CONSTE CO. 9-1
 PROJ. NO. C-27-110 BK. NO. K

Woolly
 731
 743
 743

Woolly

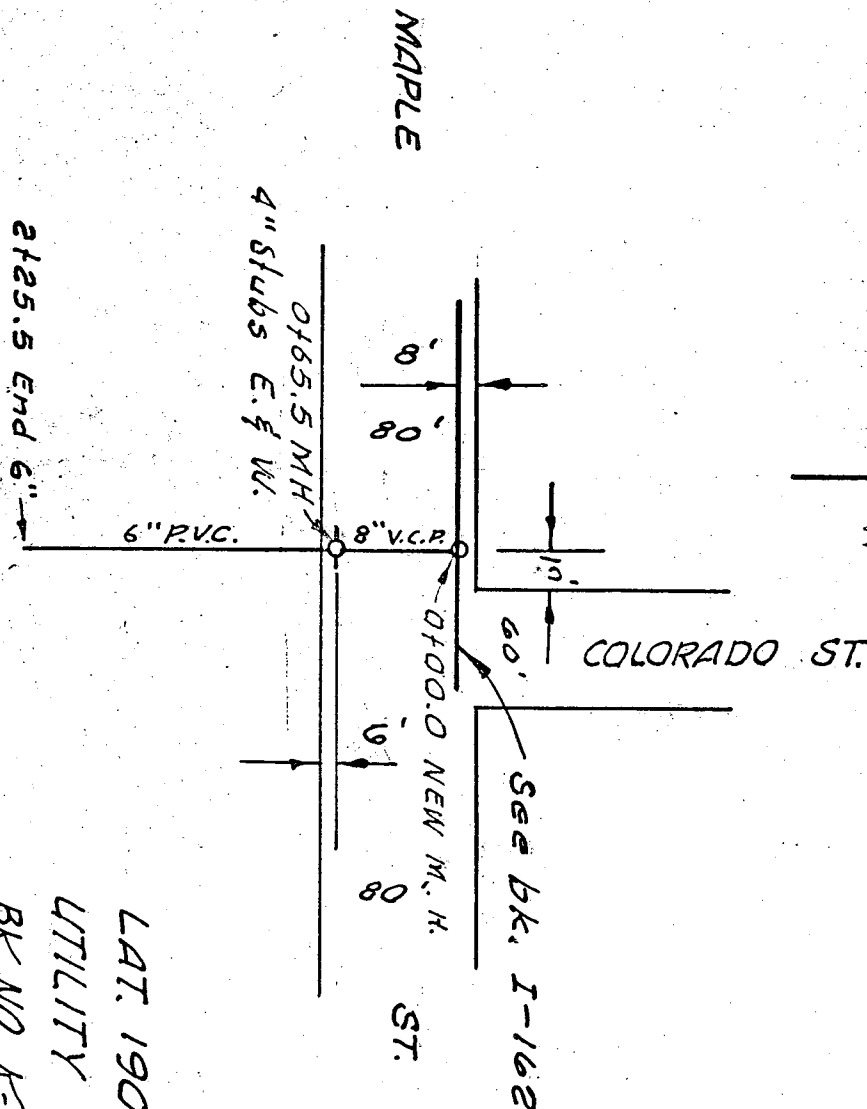

LAT. 190, SUB 5 S.S. &
 UTILITY CONTR. INC., MAR. 1
 BK. NO. K-85, PRIVATE CON