


David Brace
267-5683

1010
1110
1120
1130
1140
1150

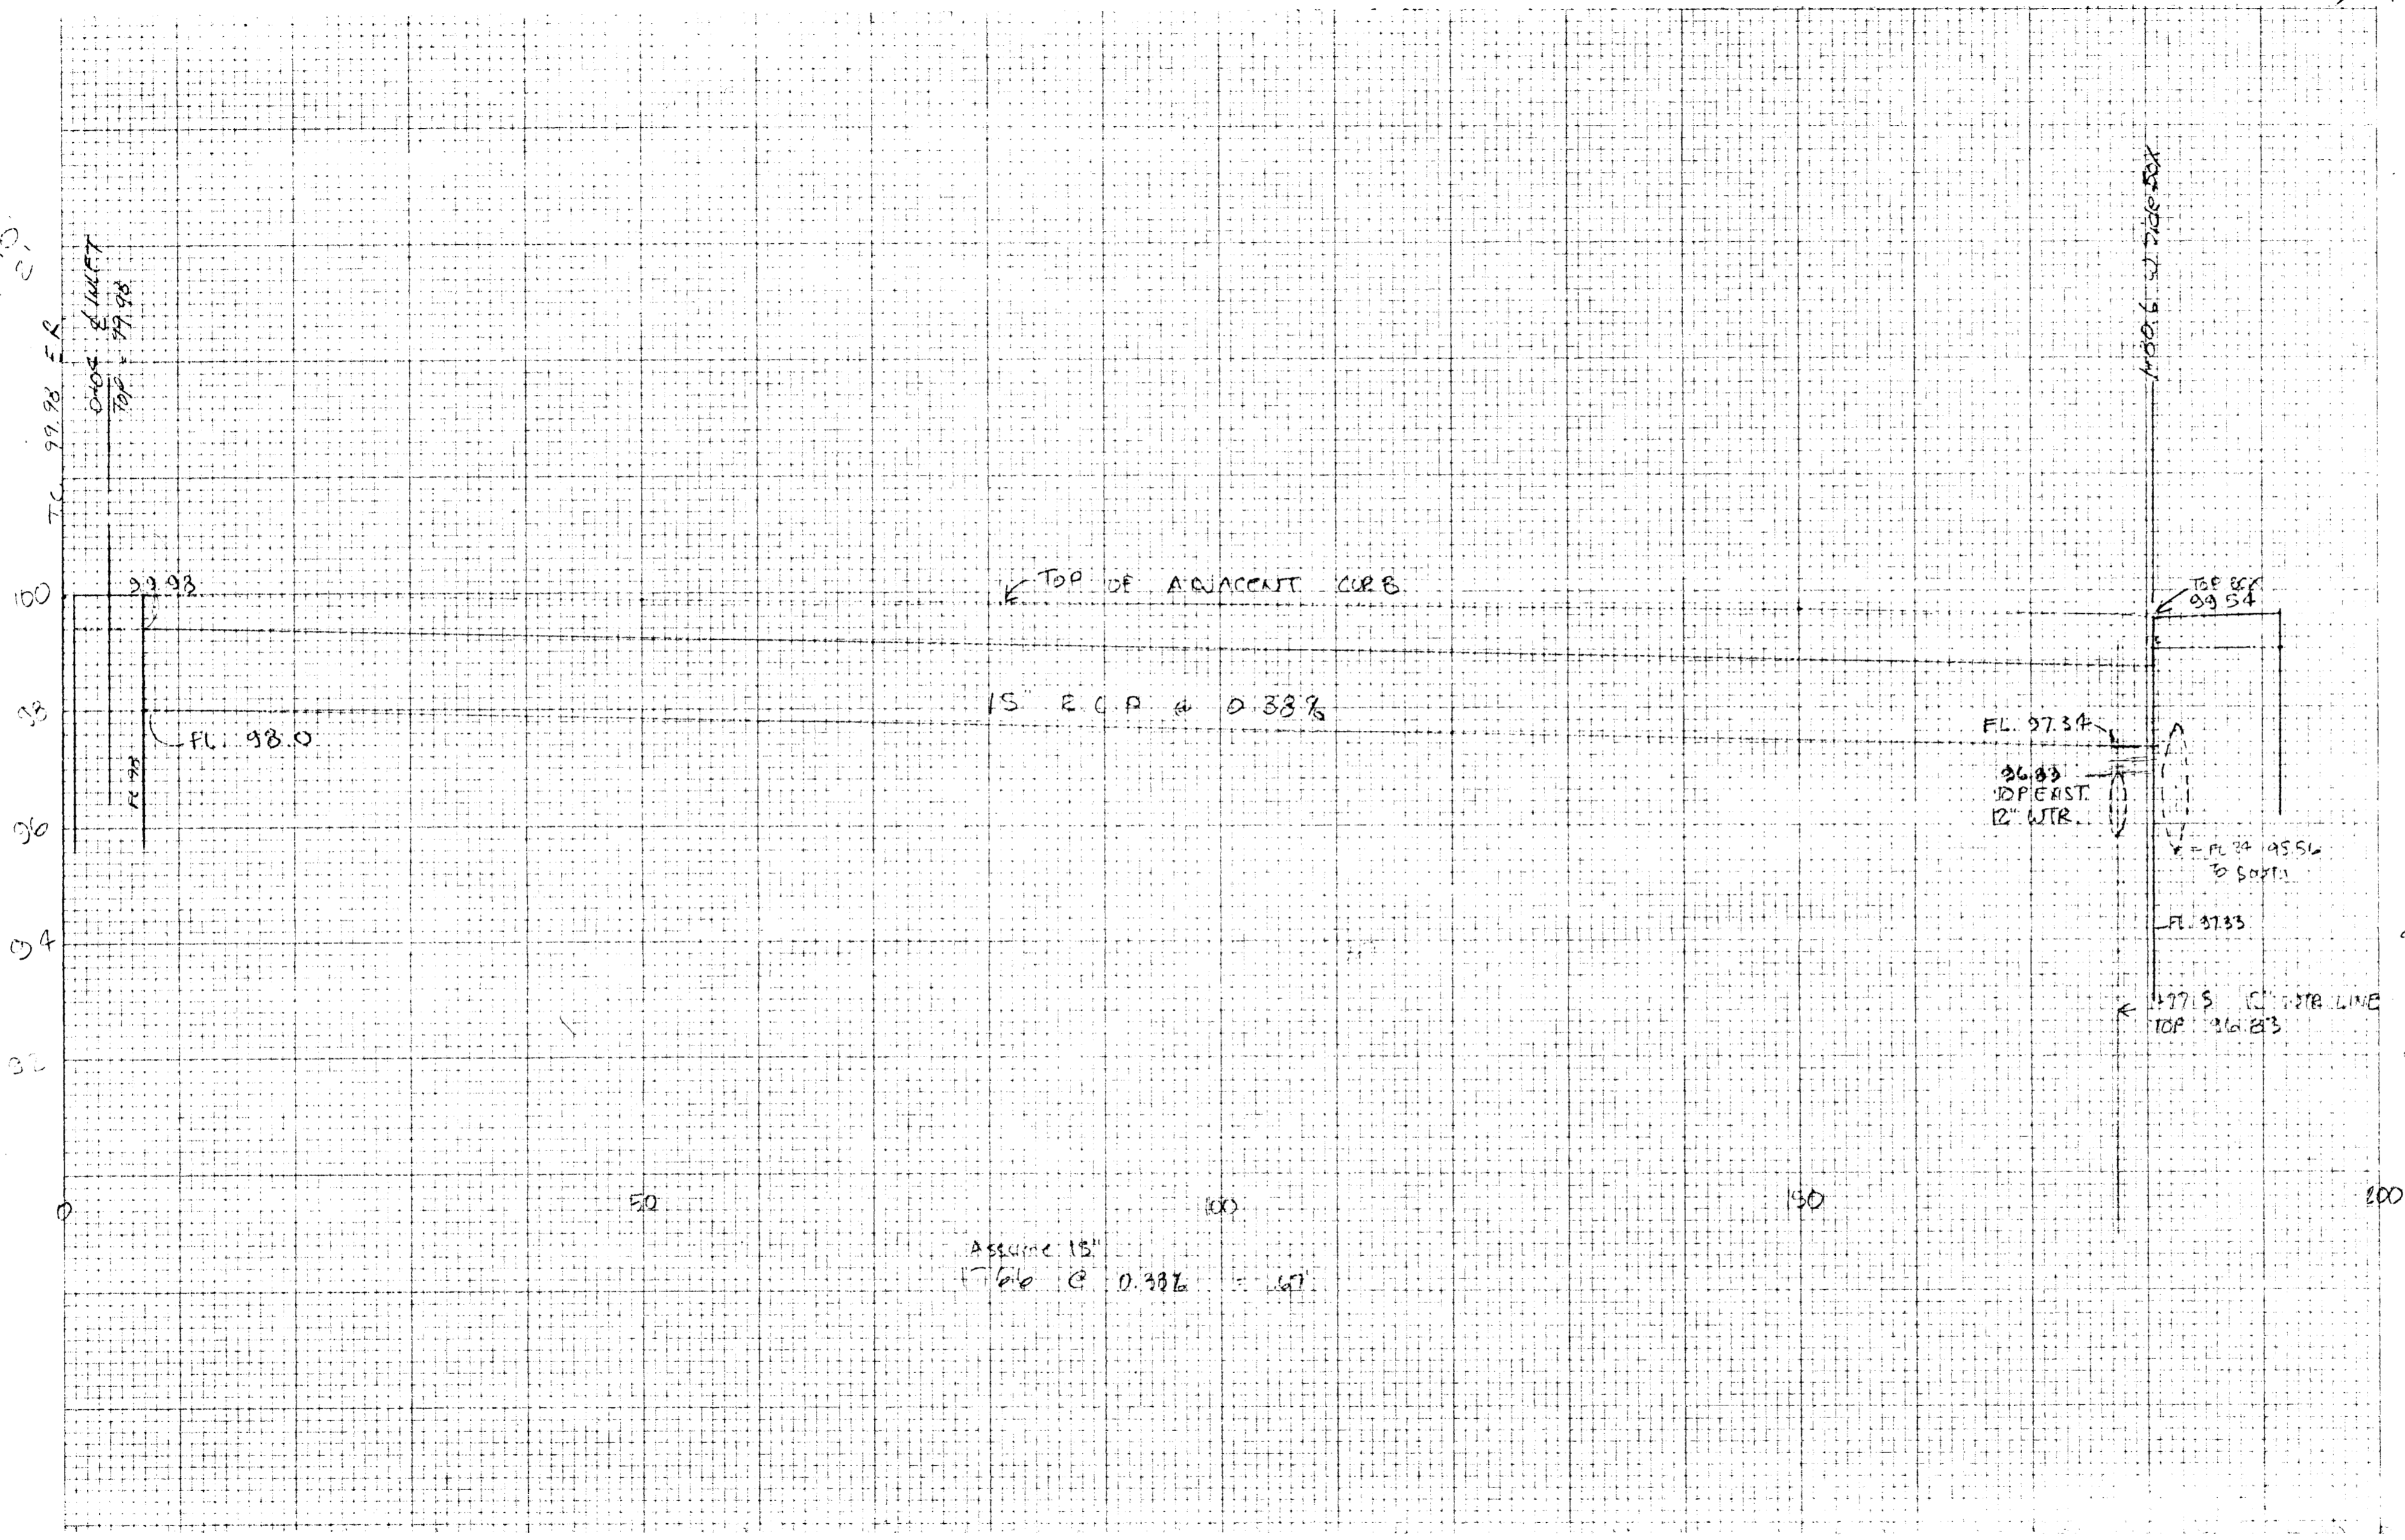

1' CURB

100

78

76

94

92

80