

NW Cor. SE 1/4
Sec. 20-28-12

30' 0" 15'

2662.33'

E Derby
Piping

Proposed
50' Cont.

CRISB

R.R.

CRISB

E. City Service Pipeline

Proposed
50' Cont.

APPROX
CURRENT
LOCATION

Scale:
1"=100'

AVE

BROADWAY

54 TH ST. SO.

54 TH ST. SO.

PALISADE

CAMPUS

MCLEAN

10' Derby
Cont.


E Relocated
Derby Pipe Line

55TH

STREET

SOUTH

SW Cor. SE 1/4
Sec. 20-28-12

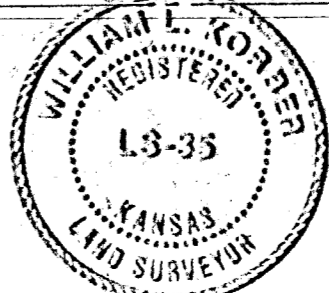

Baukhorn Co. 2-3-78
320 Laura
Wichita, Ks.