PRELIMINARY PLAT

ORCHARD VIEW ADDITION

SEDGWICK COUNTY, KANSAS

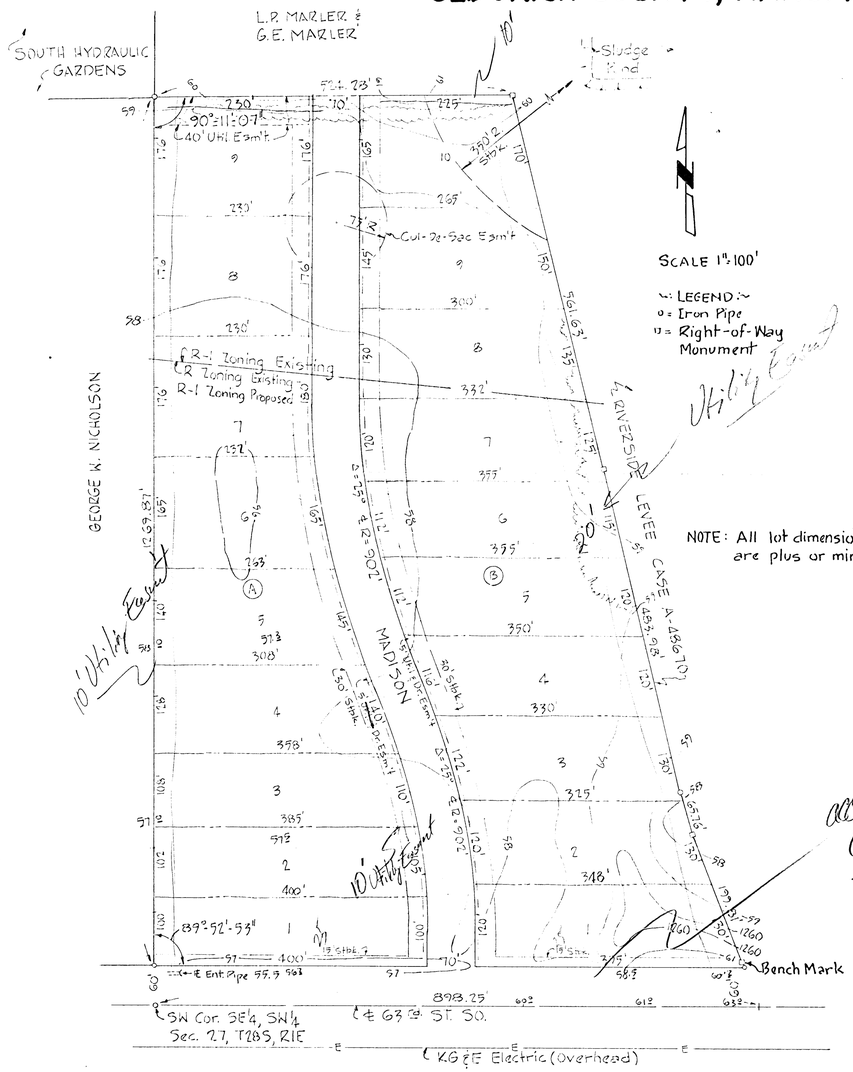

SCALE 1" = 100'

LEGEND:
o = Iron Pipe
⊠ = Right-of-Way Monument

NOTE: All lot dimensions are plus or minus.

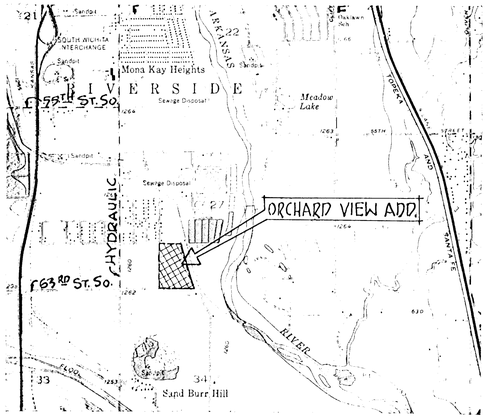

VICINITY MAP

OWNER: Gerald Blood
SUBDIVIDER: 6346 S. Broadway
Wichita, Kansas 67216
Pho. 522-0737

DESCRIPTION: All that part of the Southeast Quarter (SE¼) Southwest Quarter (SW¼), Section 27, T28S, R1E of the Sixth P.M. lying West of the West line of the Riverside Levee, Condemnation Case A-48670, Sedgwick County, Kansas.

BENCH MARK: Top Right-of-Way Monument Southeast Corner Plat Eley. 1261.05

PREPARED BY: Delamater Freund & Assoc. P.A.
412 Century Plaza
Wichita, Kansas 67202
Pho. 263-6121

DATED: April, 1980

249-Q-B-201