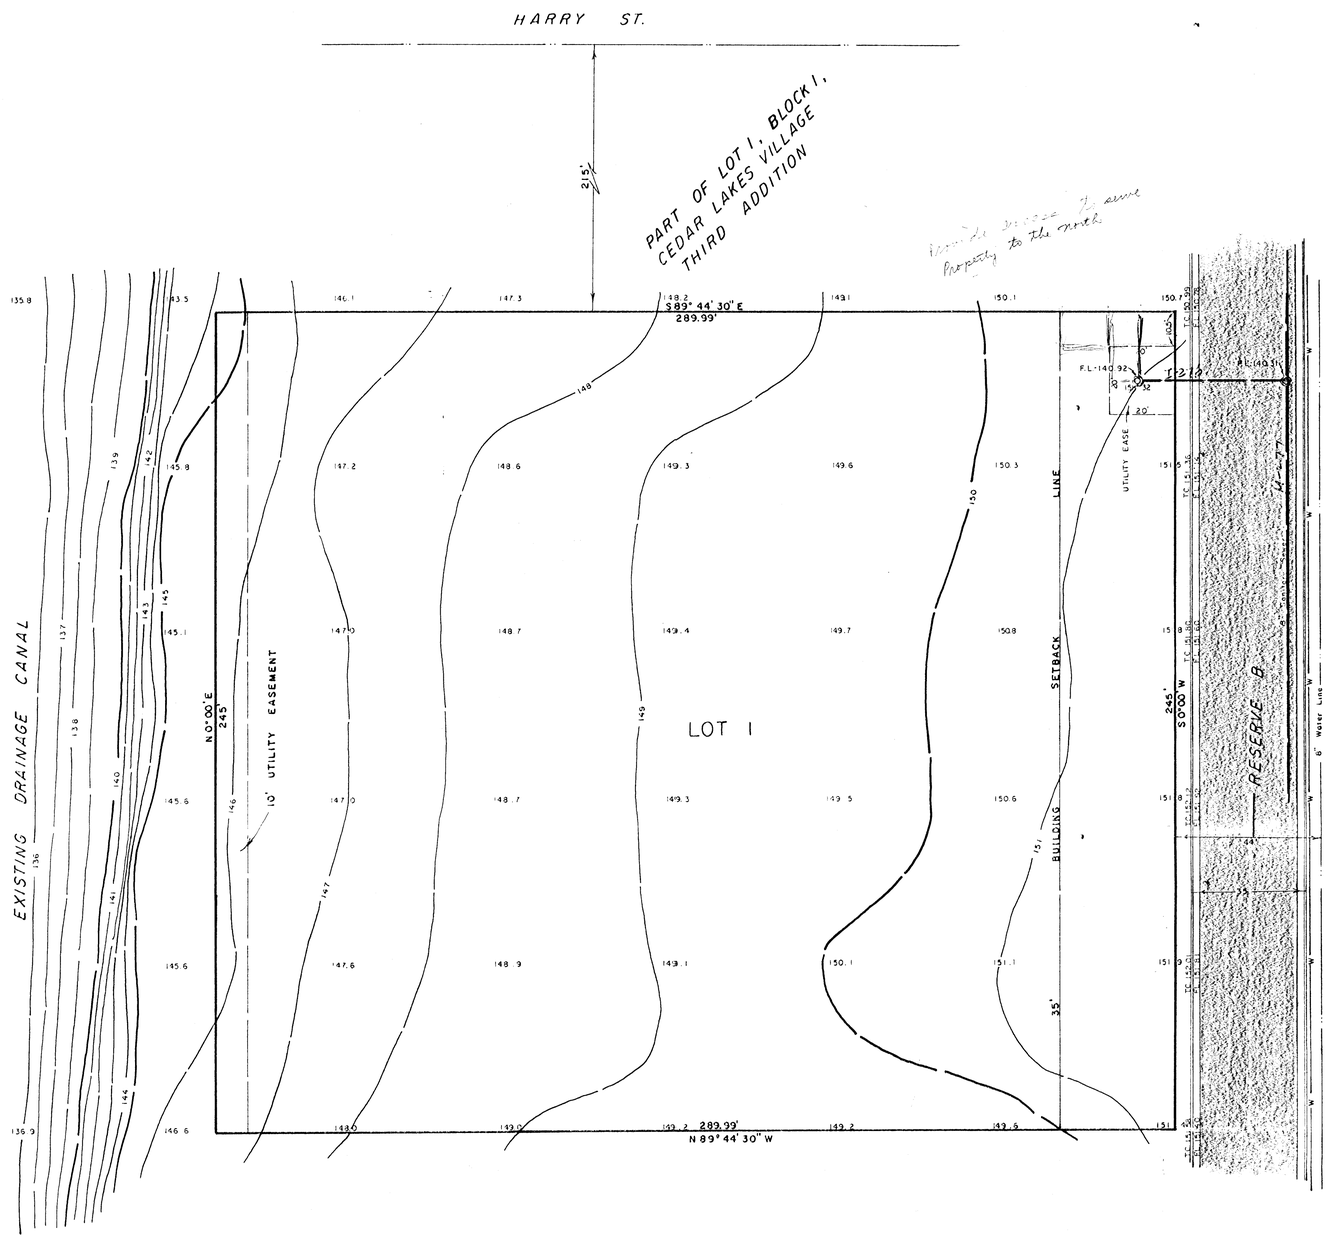

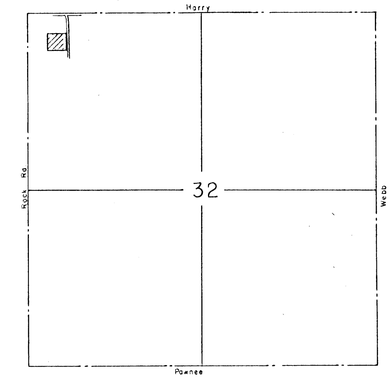

VICINITY MAP
1" = 1000'

LOT 2, BLOCK 1, CEDAR LAKES VILLAGE THIRD ADDITION

N

1" = 20'

SKETCH PLAT

HADIJSKI ADDITION

FOR: ALEKSANDAR HADIJSKI
2040 S. ROCK RD.
WICHITA, KS 67207

LOWELL D. HIGH, L.S.
1542 SO. ST. FRANCIS
WICHITA, KS 67211

B.M. ELEV. 151.32 - S. RIM OF MH AT NE COR. OF CAPTIONED PROPERTY.