


UNPLATTED

POND A

DILLING-KOLAR TRIBUTARY BASELINE

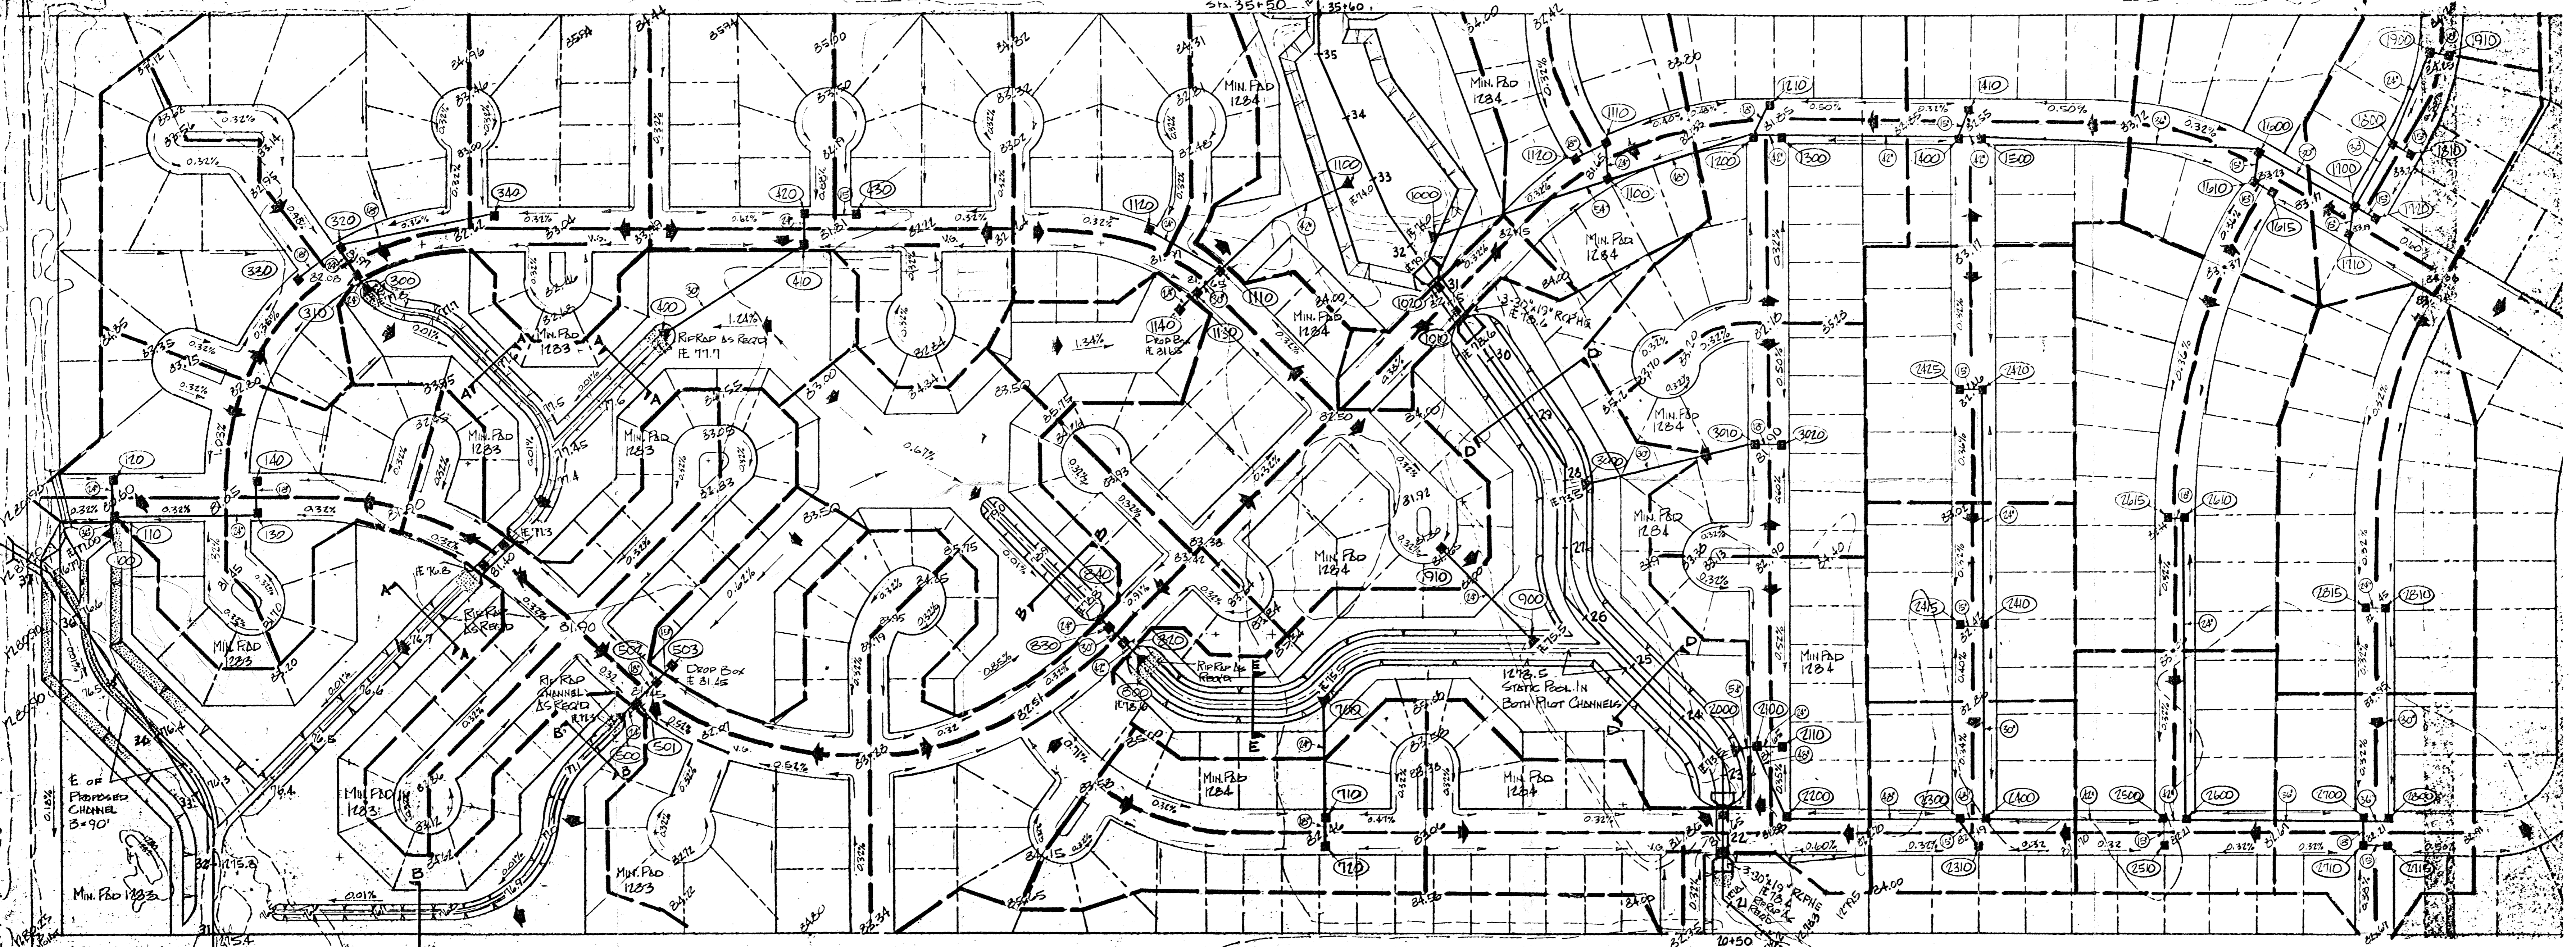

LEGEND:

- BASIN BOUNDARY
- 2-YEAR FLOW
- 100-YEAR FLOW
- OPEN CHANNEL
- RIP RAP
- STORM SEWER
- INLET COMPUTER CODE
- STANDARD INLET (4x6)
- STANDARD OUTFALL
- VALLEY CUTTER

NORTH SCALE 1"=100'

EXISTING ELEVATIONS IN SEA LEVEL DATUM
PROPOSED ELEVATIONS IN FEET +1200

LAWRENCE E. WELLS
ARCHITECT
254 LAUREL SUITE 202
(316) 282-2292

490
5-23-80
SHEET 1 of 3

Cottonwood Grove Addn

COTTONWOOD GROVE

DRAINAGE PLAN

RECEIVED SEP 25 1980