


drainage plan 2/1/64.


SKETCH PLAT FRIENDS MANOR ADDITION

200 LOTS 22 THROUGH 24 IN HIRAM
UNIVERSITY PLACE ADDITION TO SUBDIVISION
WITH PART OF HIRAM AVE & UNIVERSITY AVE

OWNERS: FRIENDS UNIVERSITY
PHILIP S. WHITEMAN
ORVILLE J. PIERCE

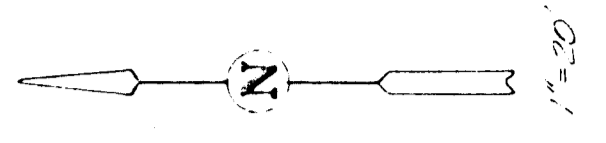

Bench mark:
5/25 rod in concrete post
25 feet west of "centerline"
of "strip" of "east" north of
55.00' line of "Main"
Elevation = 1081.4 City Datum

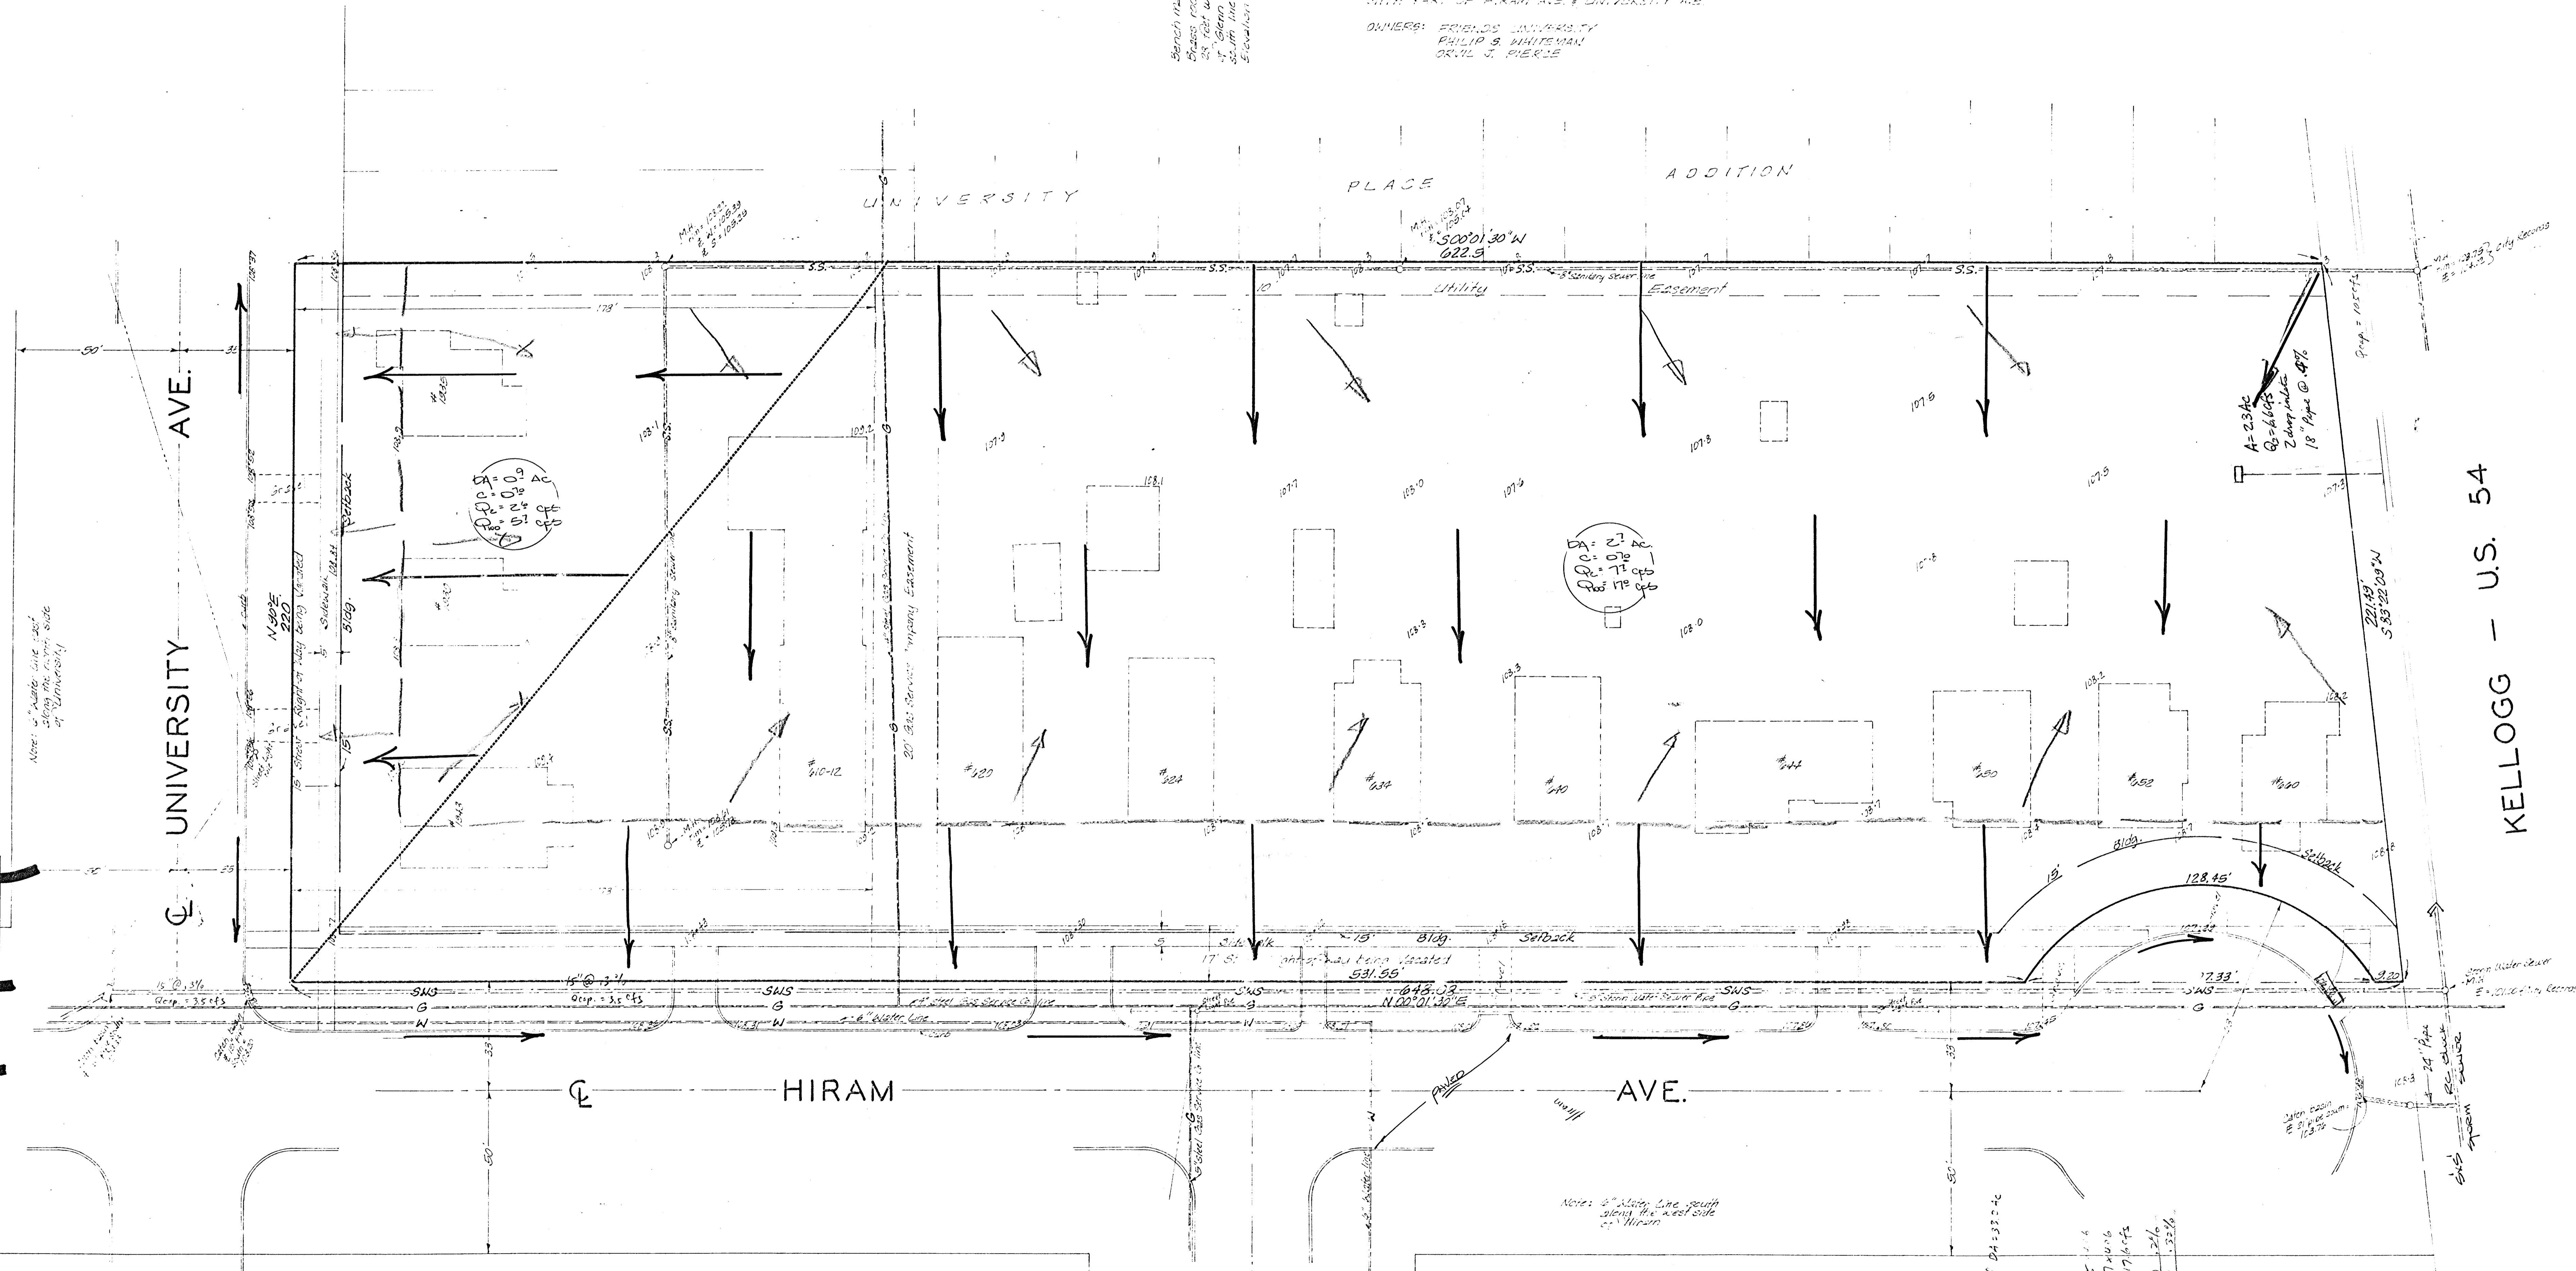

Note: 2" Water Line West along the north side of University

UNIVERSITY AVE.

HIRAM AVE.

KELLOGG - U.S. 54

Note: 2" Water Line South along the west side of Hiram

30' x 15' 1/2
39' x 7' 1/2
17' 1/2
30' x 21' 1/2
37' x 15' 1/2