

JAMES PLACE

WICHITA KANSAS



BRITAIN
ZONE - R-1
UNPLATTED

LEGEND

Front yard building set-back is 20feet.
Reserve A and B are reserved for drainage,
open space areas, ponds, and landscaping.
Direction of surface drainage ———

PRELIMINARY PLAT OF JAMES PLACE

A MANUFACTURED HOUSING SUBDIVISION

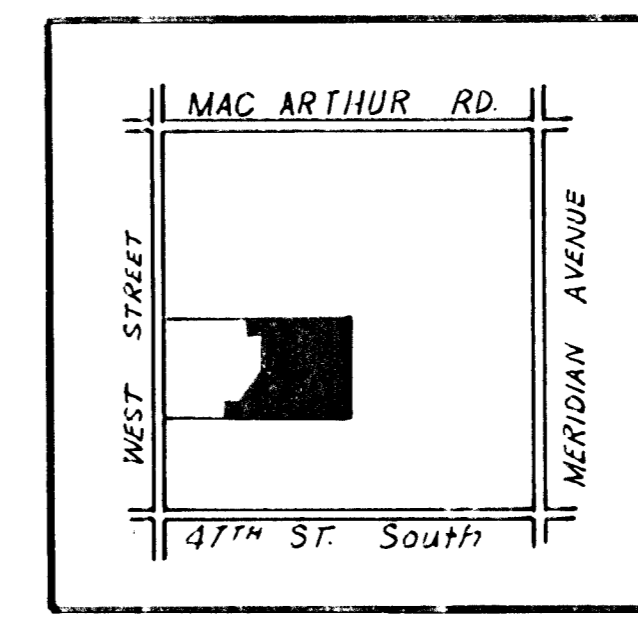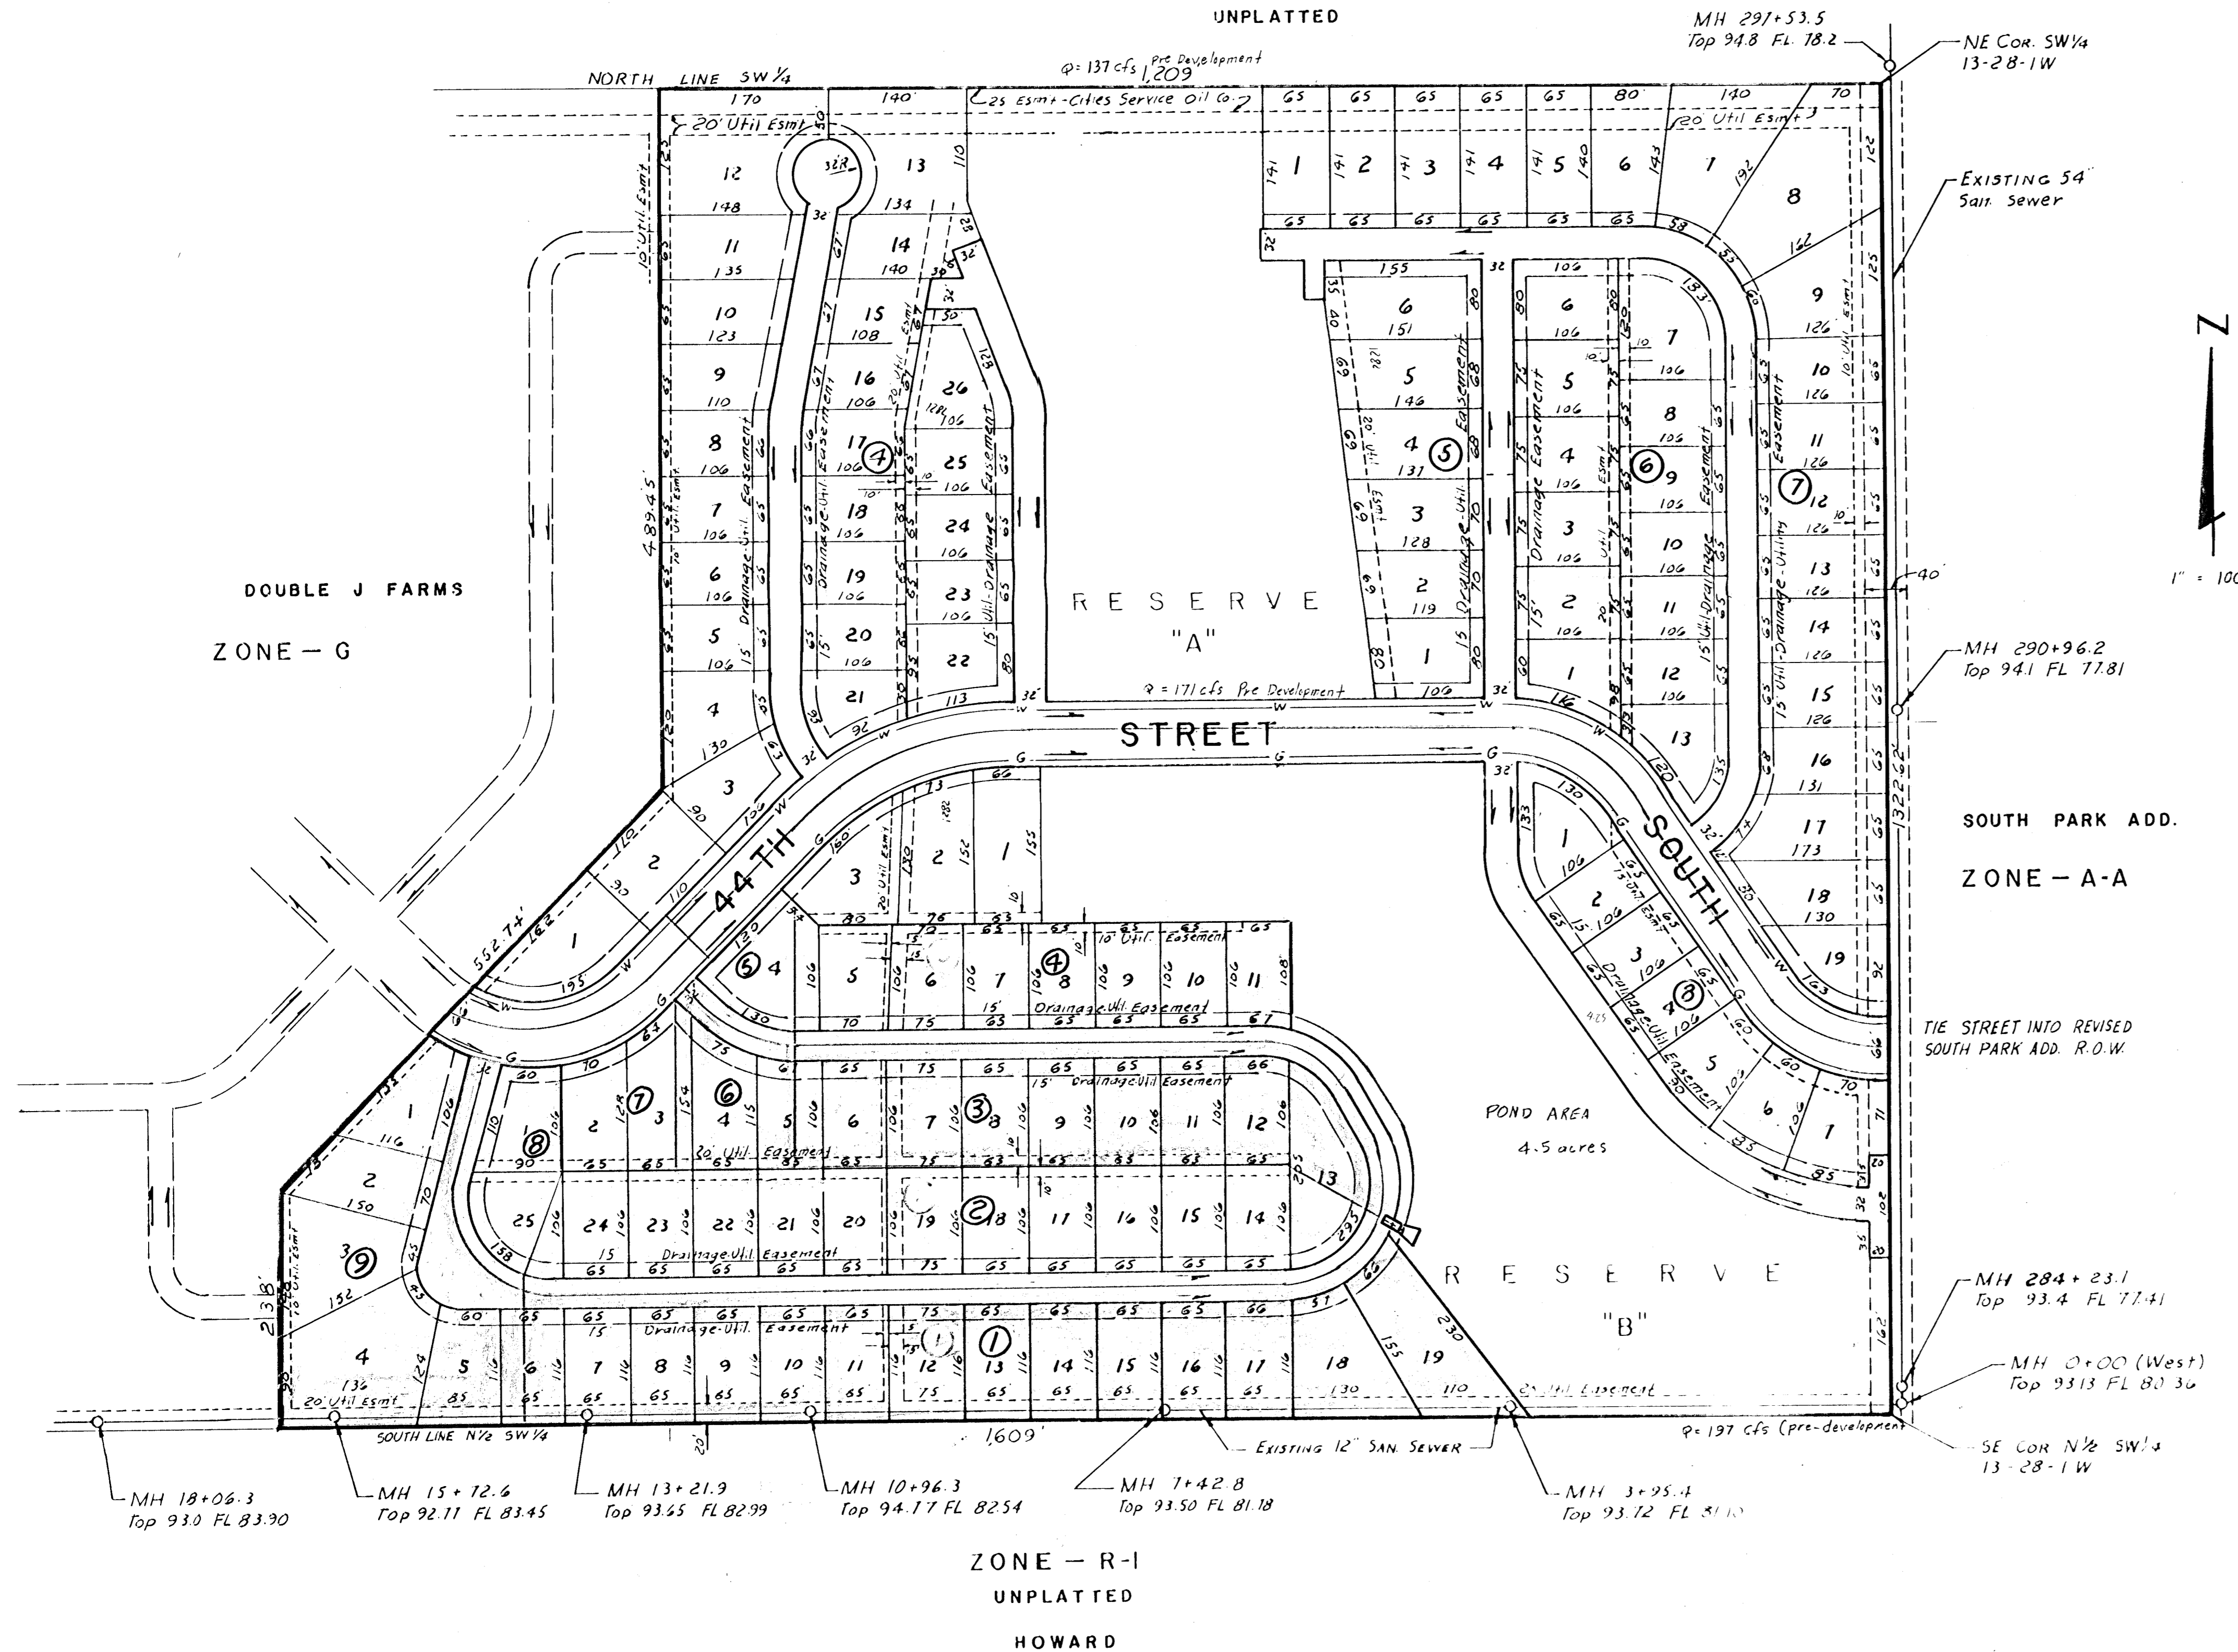

LOCATION MAP

DOUBLE J FARMS
4444 SOUTH WEST ST.
SUITE 94
WICHITA, KS 67217
316-529-4444

DEVELOPER

MACON COMPANY
ENGINEERS - SURVEYORS
1710 N. MAIN, HEWTON, KS 67114
316-234-2793
FAX 316-283-6048
1540 N. BROADWAY, WICHITA, KS 67214
SUITE 2008
316-269-2772

Scale 1" = 100'	Rev.
Date 6-15-89	Proj. No. 10020W

ZONE - R-1
UNPLATTED
HOWARD