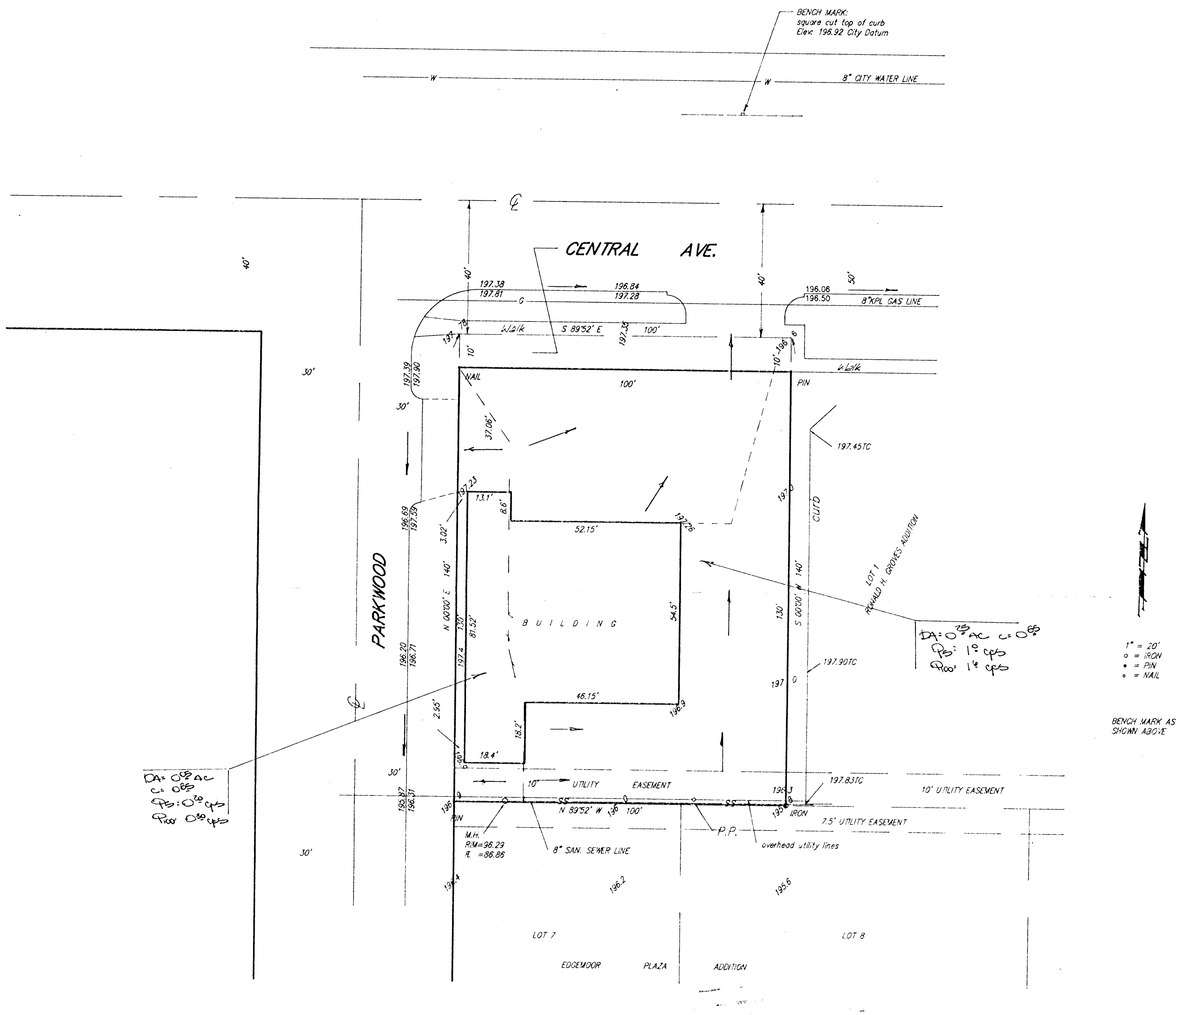

SKETCH PLAT

JIM-B ADDITION

WICHITA, SEDGWICK COUNTY, KANSAS

LEGAL DESCRIPTION: LOT 6, BLOCK A, EDGEMOOR PLAZA, AN ADDITION TO WICHITA, SEDGWICK COUNTY, KANSAS.

OWNERS : JAMES AND JULIA M. BAYOUTH

DRAINAGE PLAN

BAUGHMAN COMPANY P. A.
SURVEYING & ENGINEERING
316/262-7271 • 315 ELLIS • WICHITA, KANSAS 67211