


H 297
 H 247
 C 265
 C 264

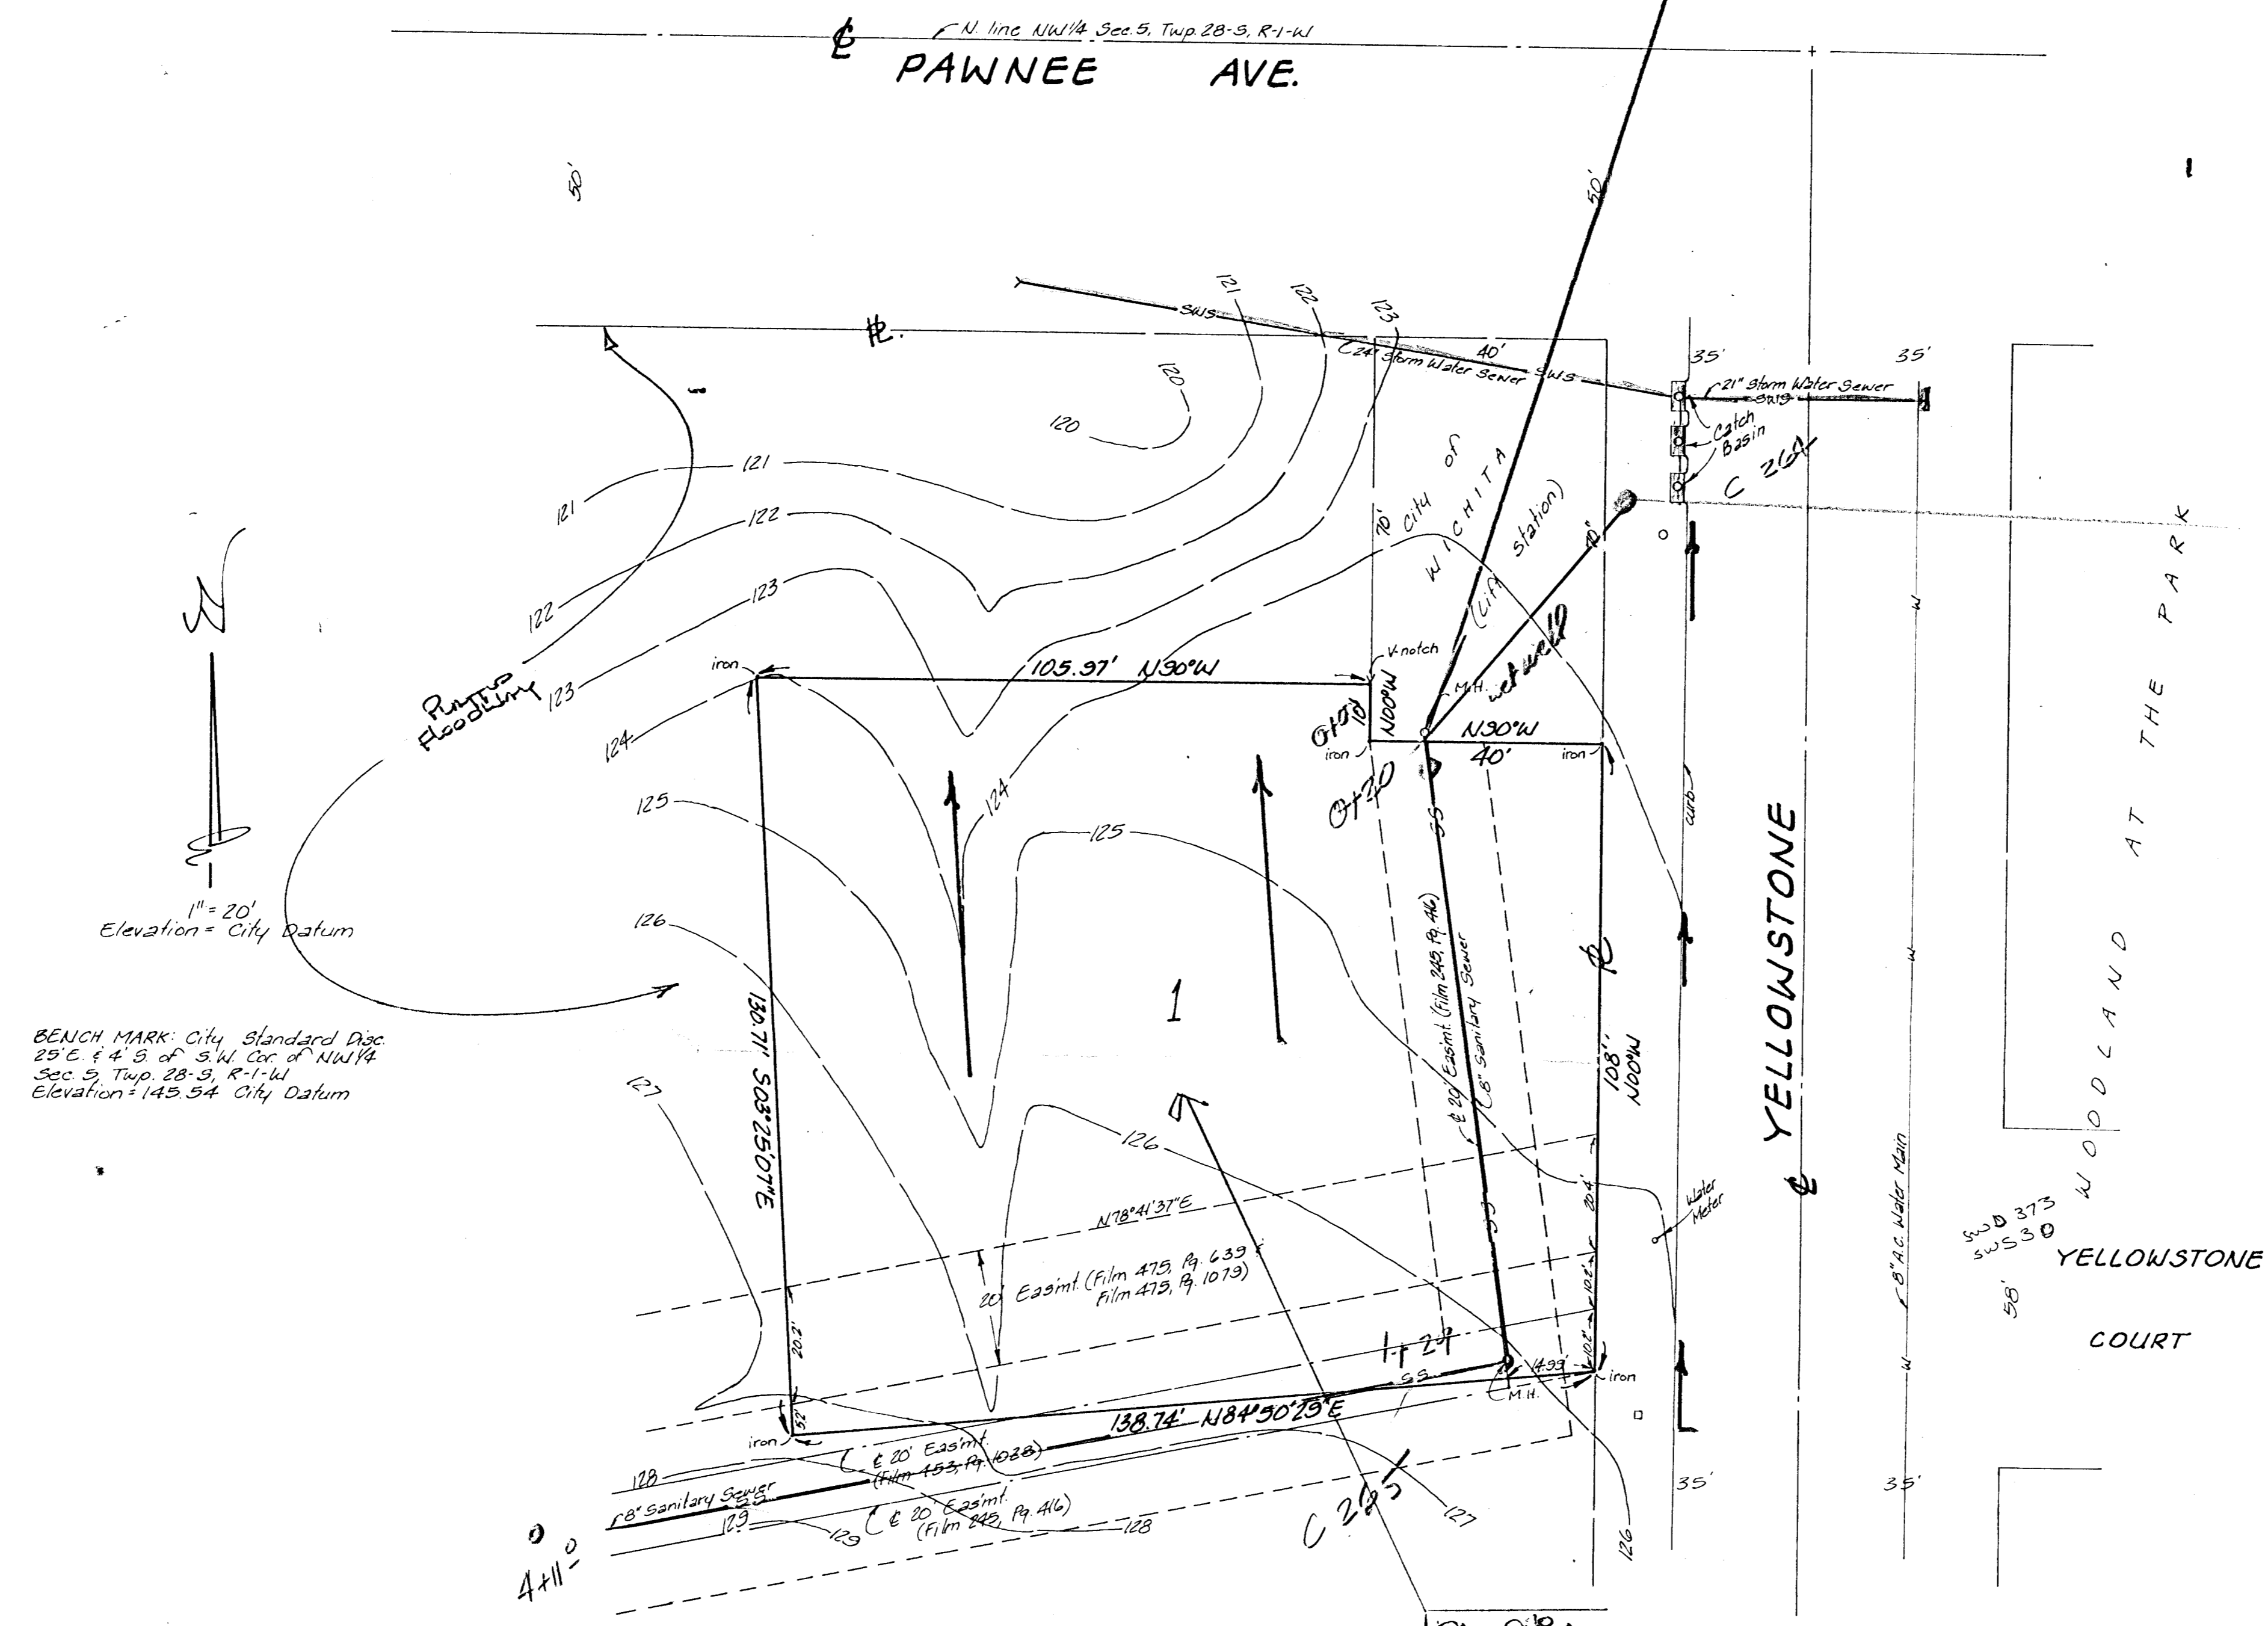

1" = 20'
 Elevation = City Datum

BENCH MARK: City Standard Peg
 25' E 44' S of S.W. Cor. of NW 1/4
 Sec. 5, Twp. 28-S, R-1-W
 Elevation = 143.54 City Datum

SKETCH PLAT

THE PARK 3RD ADDITION

REPLAT OF PART OF LOT 1, BLOCK 1, THE PARK
 AN ADDITION TO WICHITA, SEDGWICK COUNTY, KANSAS

OWNER: A. J. SOERRIES REAL ESTATE, INC.

CA = 0' 8" AC
 C = 0' 2"
 P = 1' 4"
 P = 2' 6"

DRAINAGE PLAN

BAUGHMAN COMPANY, P.A.
 SURVEYING & ENGINEERING
 316-262-7271 • 315 ELLIS • WICHITA, KANSAS 67211

28 July 1988