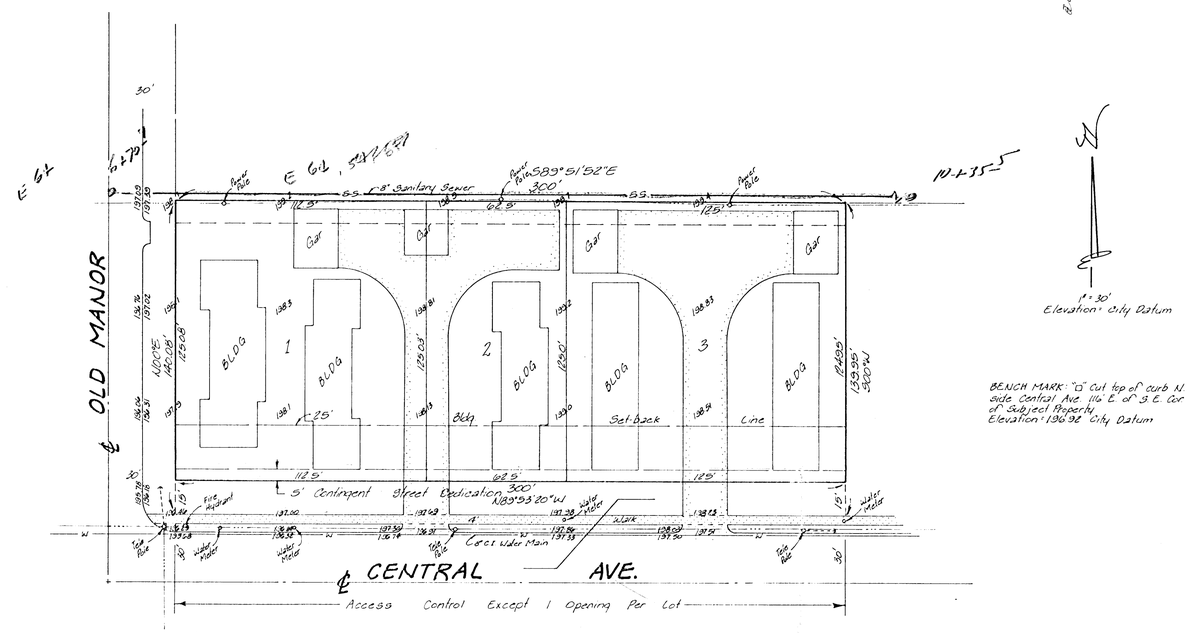

1" = 30'
Elevation: City Datum

BENCH MARK: "O" Cut top of curb N. side Central Ave 116' E of S.E. Cor of Subject Property
Elevation: 1369.92' City Datum

SKETCH PLAT

REBECCA ADDITION

REPLAT OF LOTS 27, 28, 29, 30, 31, 32, 33, 34, 35, 36, 37 & 38, BLOCK 12, EAST HIGHLANDS, AND A PORTION OF STREET R-O-W

OWNER: DEAN L. BUSSART (PROPOSED LOTS 1 AND 3)
REBECCA B. BUSSART

C. D. SMITH (PROPOSED LOT 2)
H. E. SMITH

BAUGHMAN COMPANY, P.A.
SURVEYING & ENGINEERING
316/262-7271 • 315 ELLIS • WICHITA, KANSAS 67211

25 Aug. 1988