


# DRAINAGE PLAN

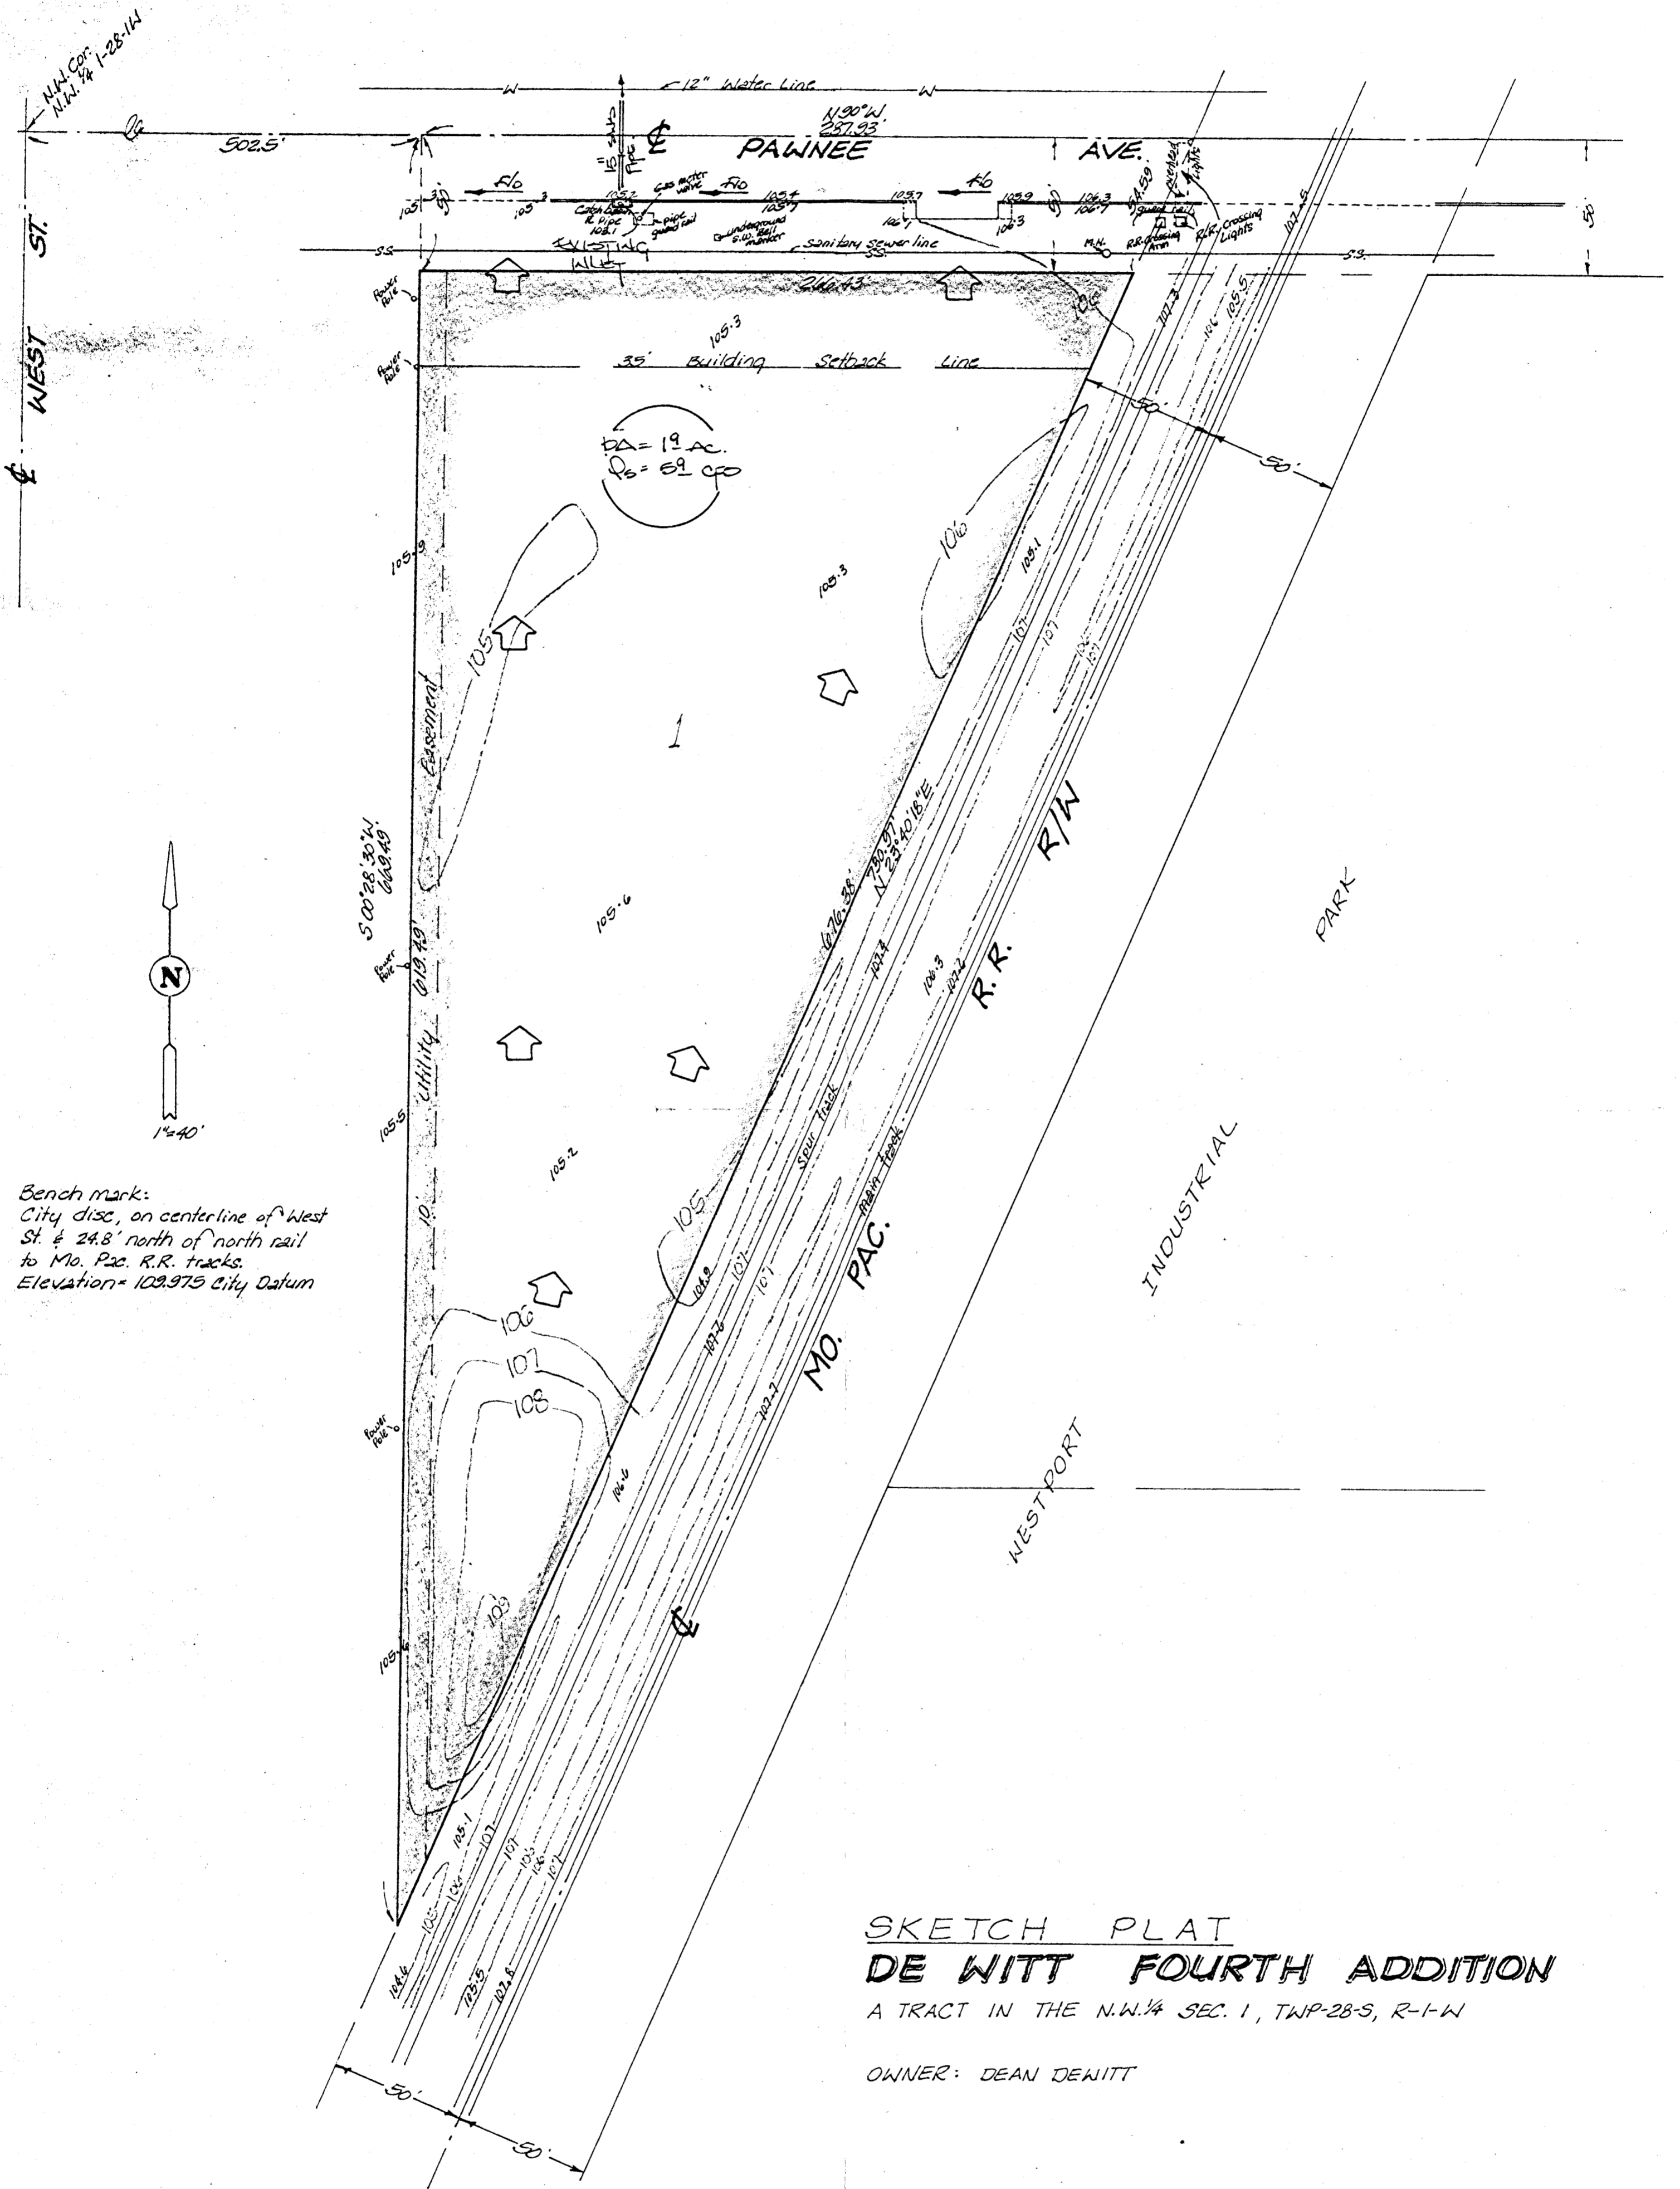

Bench mark:  
 City disc, on centerline of West  
 St. 24.8' north of north rail  
 to Mo. Pac. R.R. tracks.  
 Elevation = 109.975 City Datum

## SKETCH PLAT DE WITT FOURTH ADDITION

A TRACT IN THE N.W. 1/4 SEC. 1, TWP-28-S, R-1-W

OWNER: DEAN DEWITT

**BAUGHMAN COMPANY, P.A.**  
 SURVEYING & ENGINEERING  
 316/262-7271 • 330 LAURA • WICHITA, KANSAS 67211