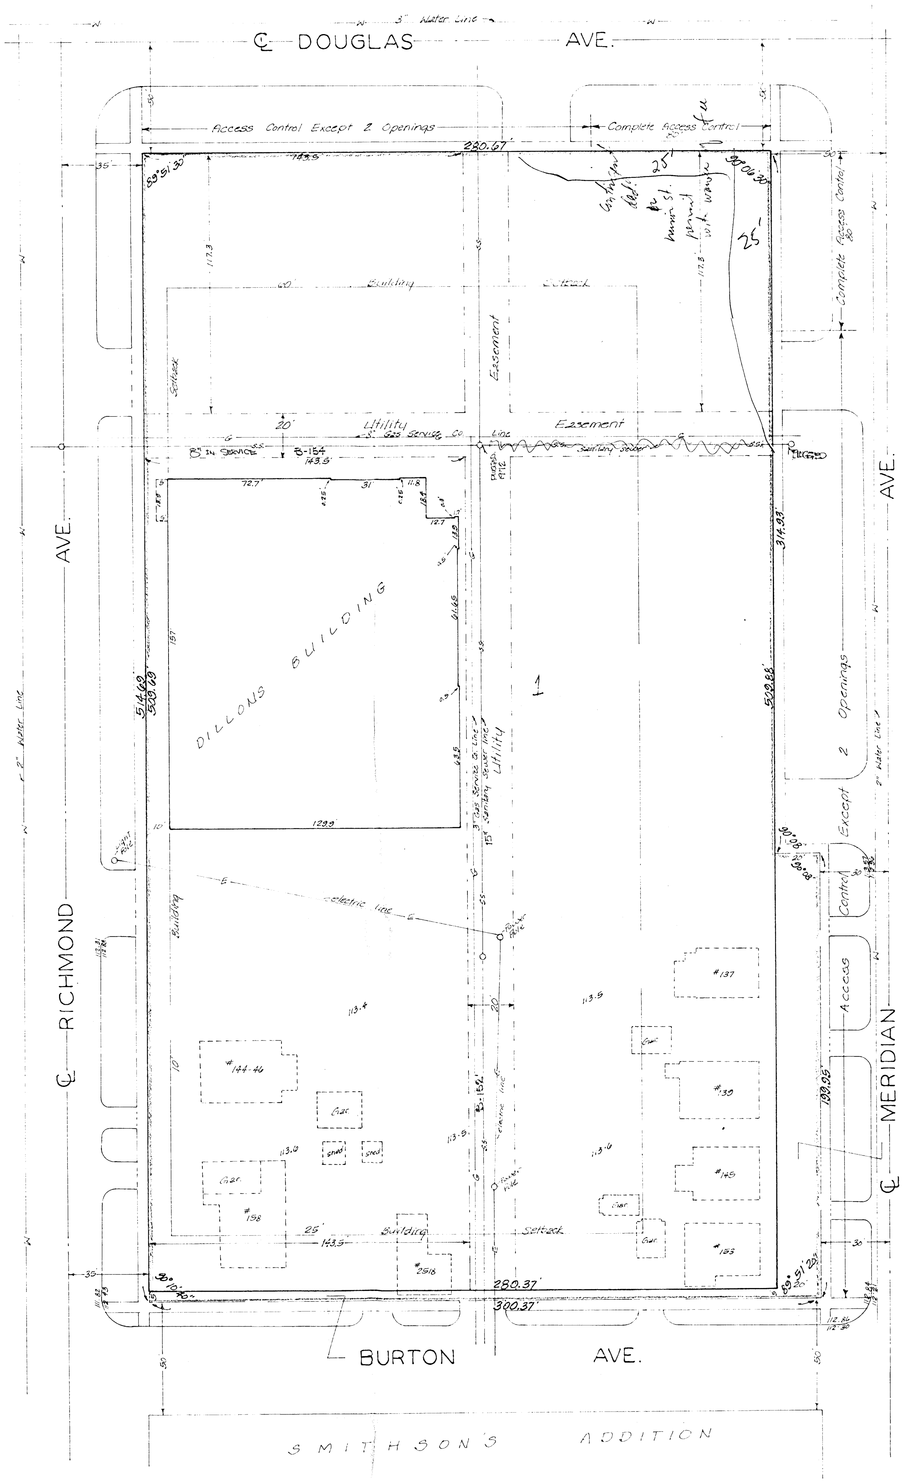


Bench mark:
Brass rod in concrete post 24.5 feet east & 23.1 feet north of centerlines of 2nd St & Meridian
Elevation = 116.21 City Datum

Lot Grading Plan:
Lot shall be graded to drain to the streets when redeveloped via approved driveways-flumes-inlets.

SKETCH PLAT
# DILLON 6TH ADDITION

B-152-84
7-30-79

BALIGHMAN COMPANY PA 7-30-79