



N.W. COR. SW 1/4, SEC. 18
T26S, R1W, 6TH PM.

POINT OF BEGINNING

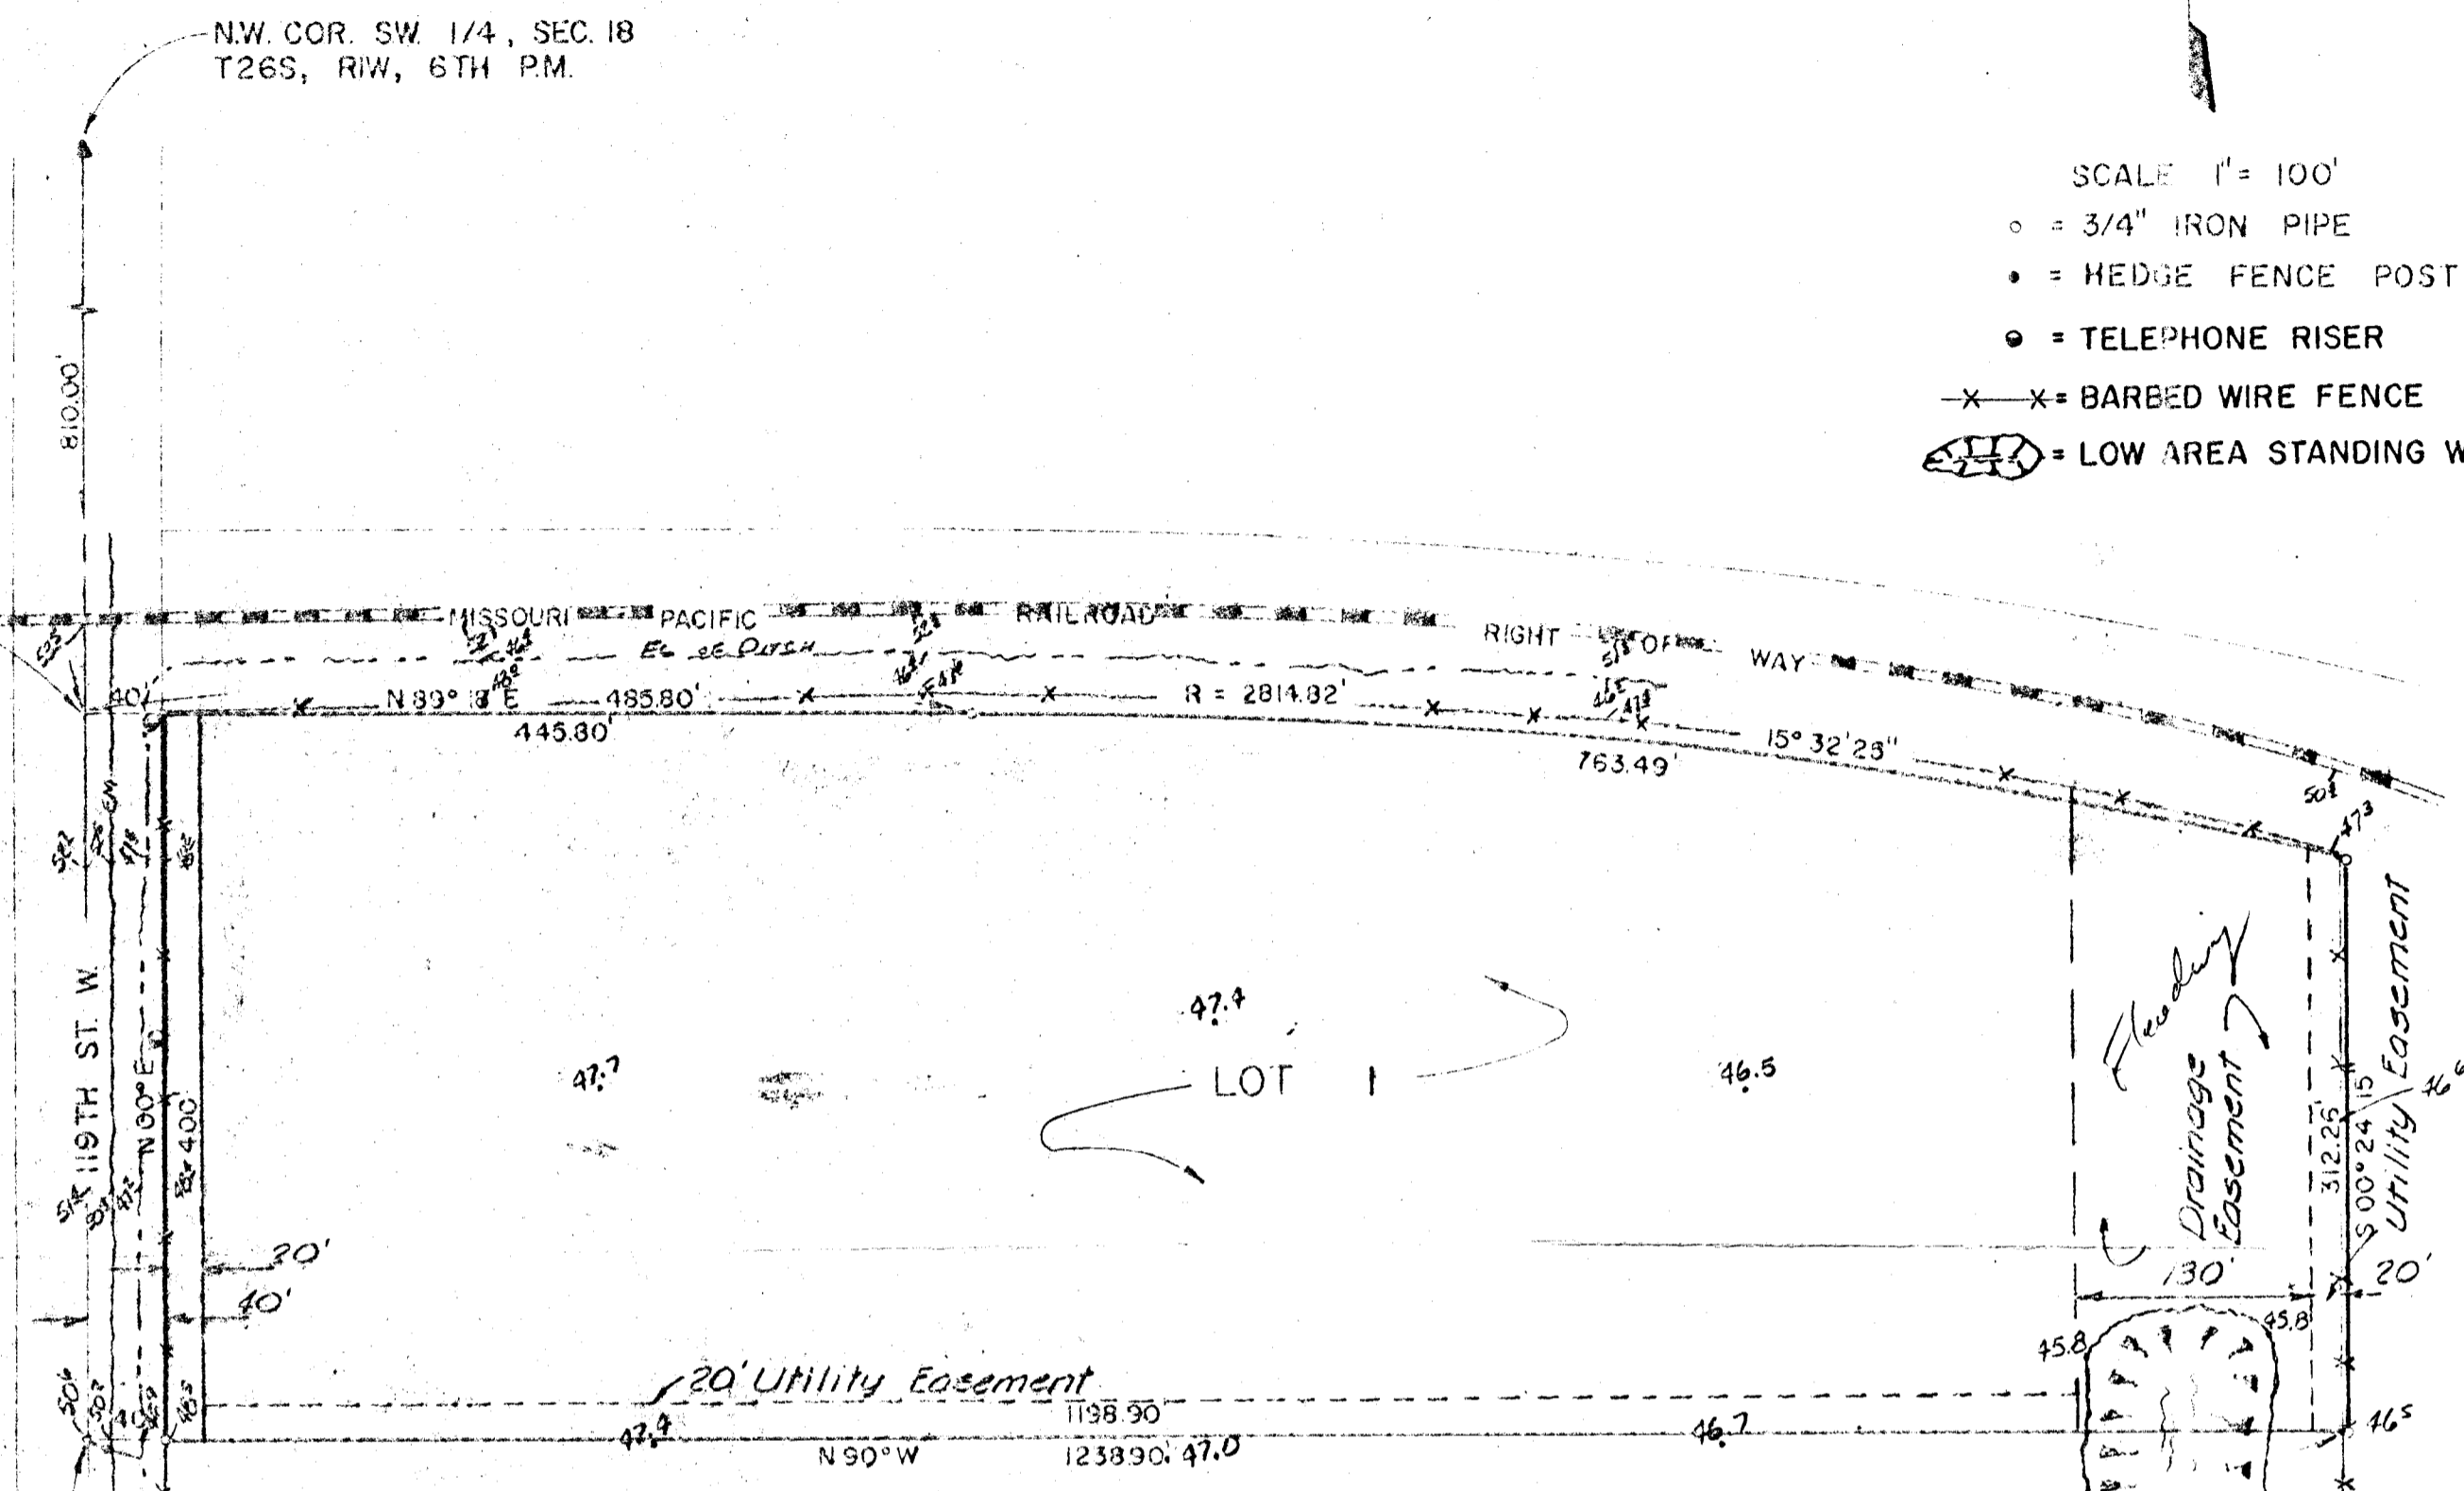

- SCALE 1" = 100'
- = 3/4" IRON PIPE
 - = HEDGE FENCE POST
 - = TELEPHONE RISER
 - X-X- = BARBED WIRE FENCE
 - = LOW AREA STANDING WATER

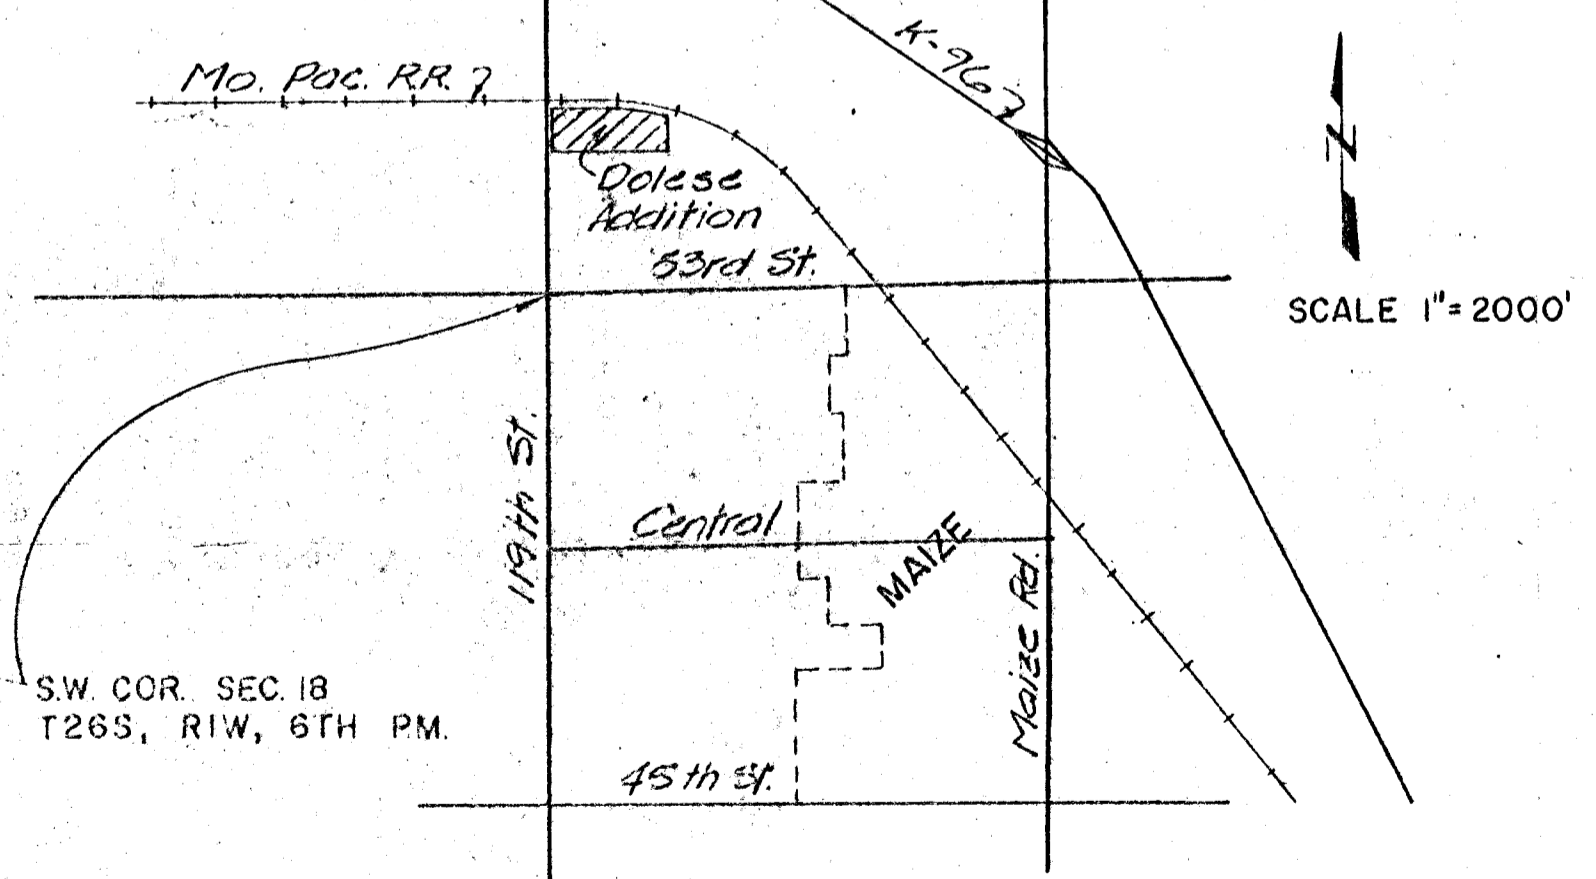

VICINITY MAP

DOLESE BROS. CO. WICHITA, KANSAS	
PRELIMINARY PLAT DOLESE ADDITION SEDGWICK COUNTY, KANSAS	
CAMPBELL & CASTLE ENGINEERS WICHITA, KANSAS	DSG DR LJK CH RMH 1983 APP
DATE NOVEMBER 1983	DWG FILE NO. 8310-C-10,091 SHEET NO. 1 OF 1