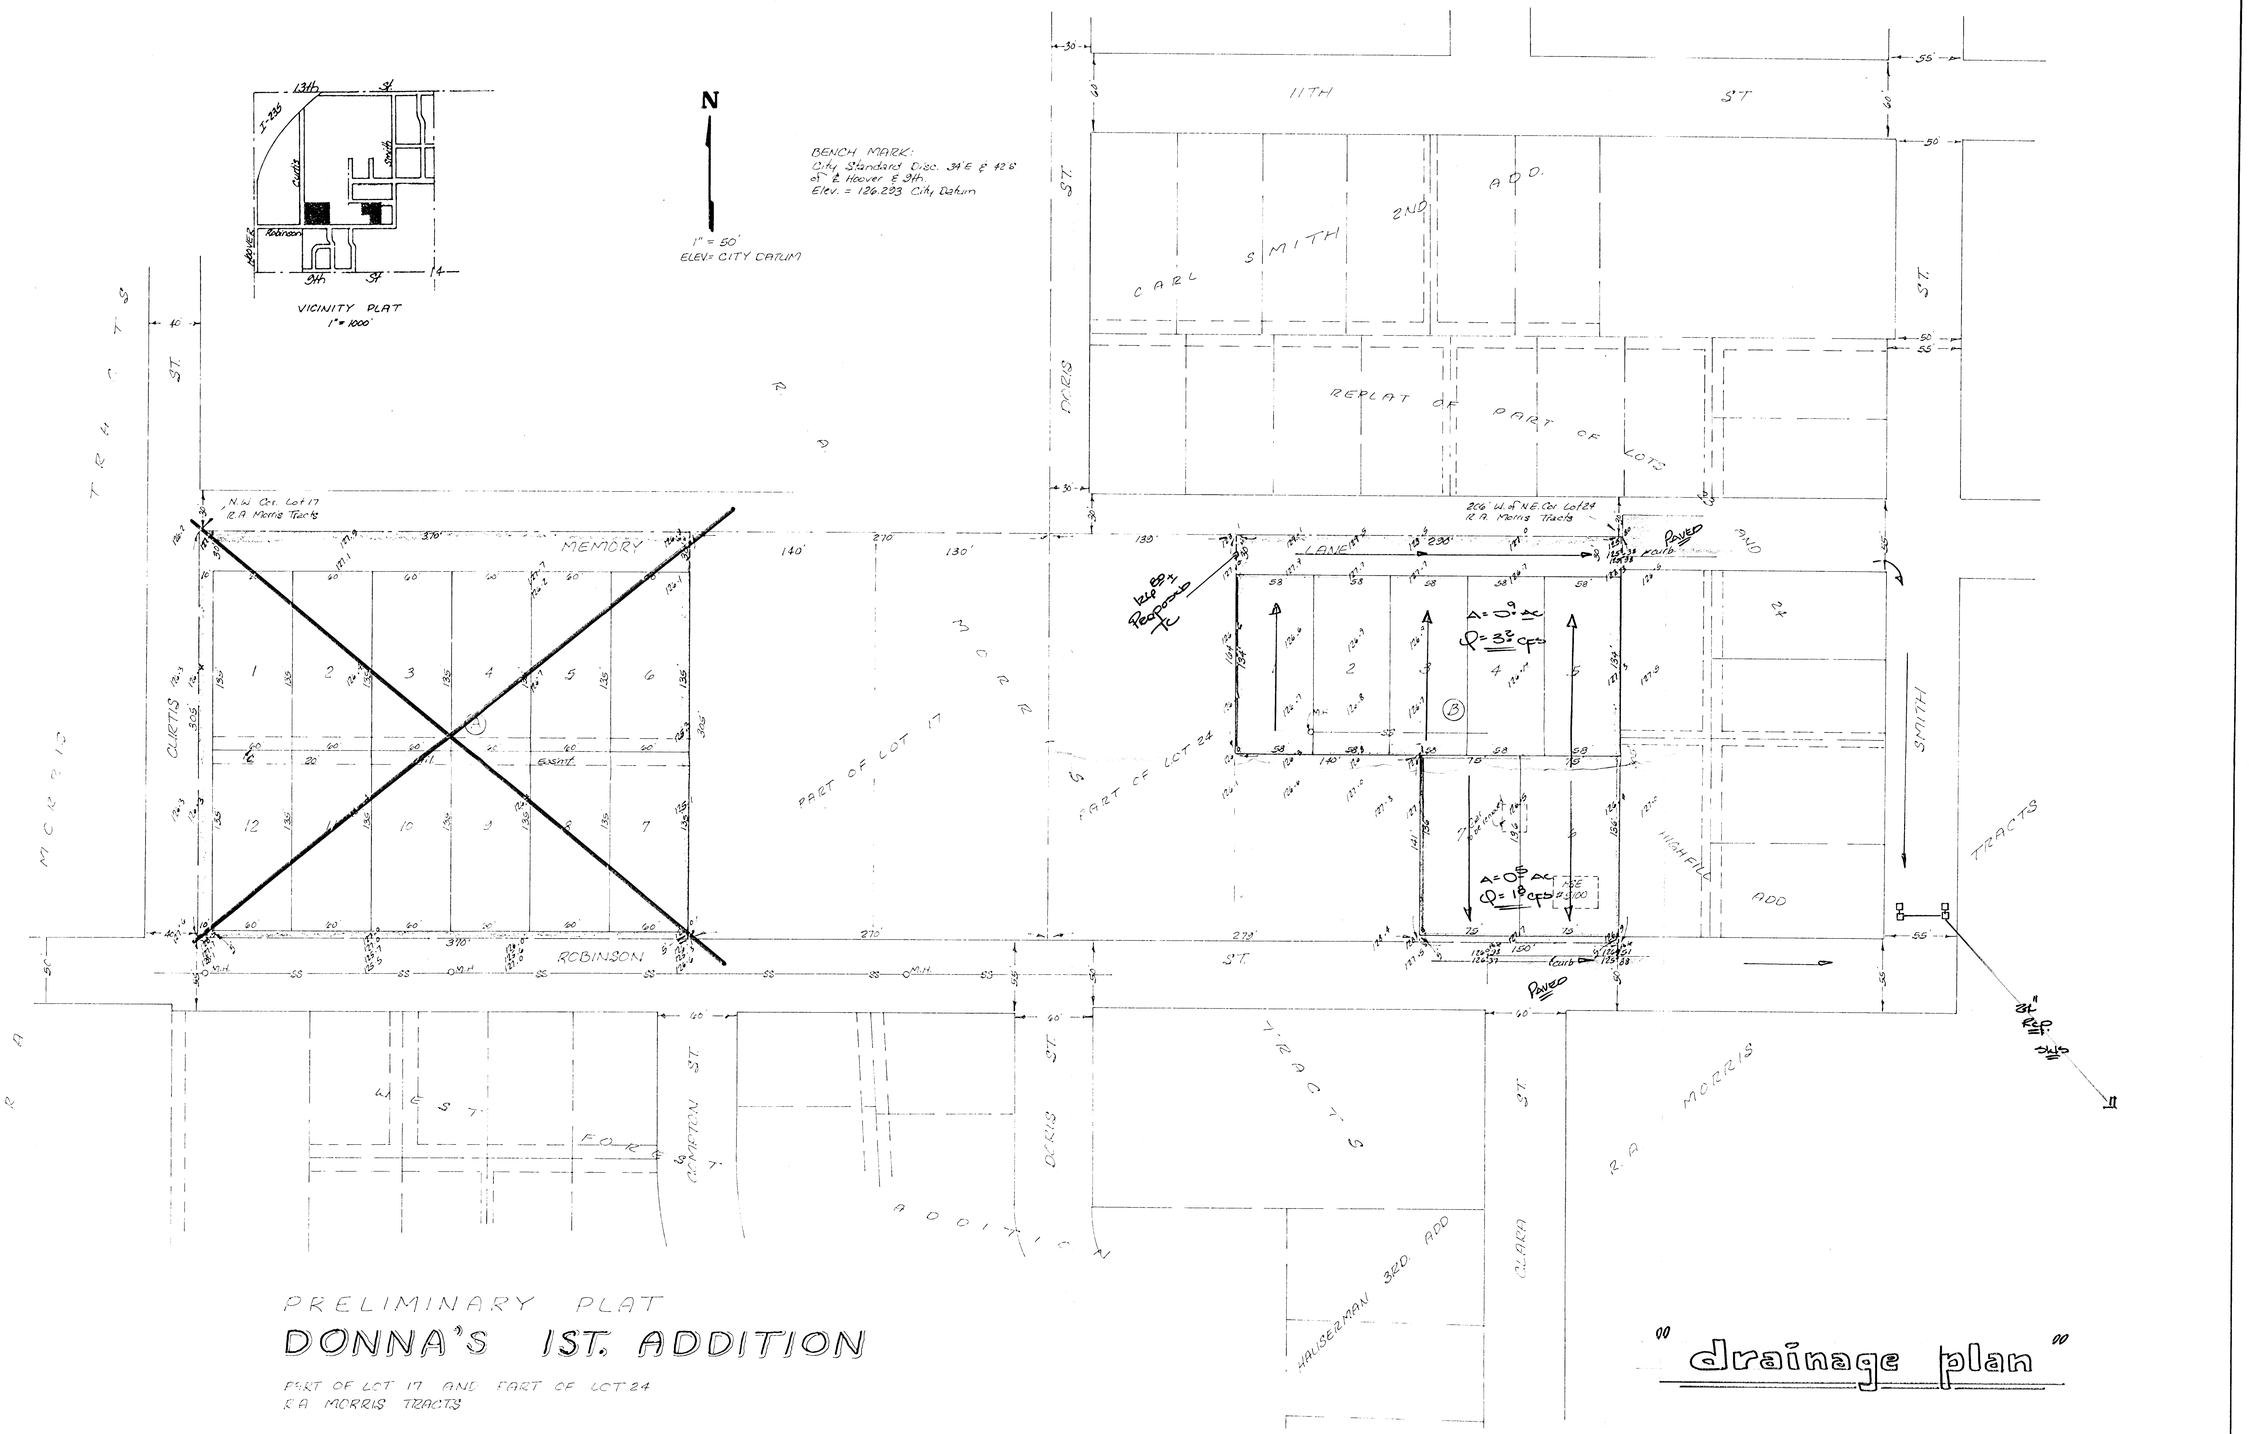
VICINITY PLAT
1" = 1000'
13th
St
I-235
Curtis
Smith
Hoover
Robinson
9th
St
14
N
1" = 50'
ELEV= CITY DATUM
BENCH MARK:
City Standard Disc. 34'E & 42'6
of ℄ Hoover & 9th.
Elev. = 126.223 City Datum
11TH
ST
CARL SMITH 2ND ADD.
REPLAT OF PART OF LOTS
MORRIS ST
N.W. Cor. Lot 17
R.A. Morris Tracts
MEMORY
140'
130'
270'
CURTIS
EASMT.
ROBINSON
PART OF LOT 17
PART OF LOT 24
MORRIS
26' W. of N.E. Cor. Lot 24
R.A. Morris Tracts
LANE
Paved
Curb
HIGHFIELD ADD
SMITH
TRACTS
R.A. MORRIS
CRAMPTON ST
DORIS ST
CLARA ST
HAUSERMAN 3RD ADD
PRELIMINARY PLAT
DONNA'S 1ST. ADDITION
PART OF LOT 17 AND PART OF LOT 24
R.A. MORRIS TRACTS
FORD M. DUKE
"drainage plan"
BAUGHMAN COMPANY, P.A.
SURVEYING & ENGINEERING
316/262-7271 • 330 LAURA • WICHITA, KANSAS 67211