NOTES

TEMPORARY TRAFFIC LANES AS SHOWN BELOW ARE TO BE CONSTRUCTED IN THE EVENT THAT THE CENTER IS DEVELOPED PRIOR TO THE IMPROVEMENTS TO RIDGE ROAD NORTH OF 21 ST. STREET NORTH.

SOLID LINES BETWEEN PAVEMENT EDGES ON 21 ST. STREET NORTH AND RIDGE ROAD DEPICT TRAFFIC LANES FOR READABILITY ONLY.

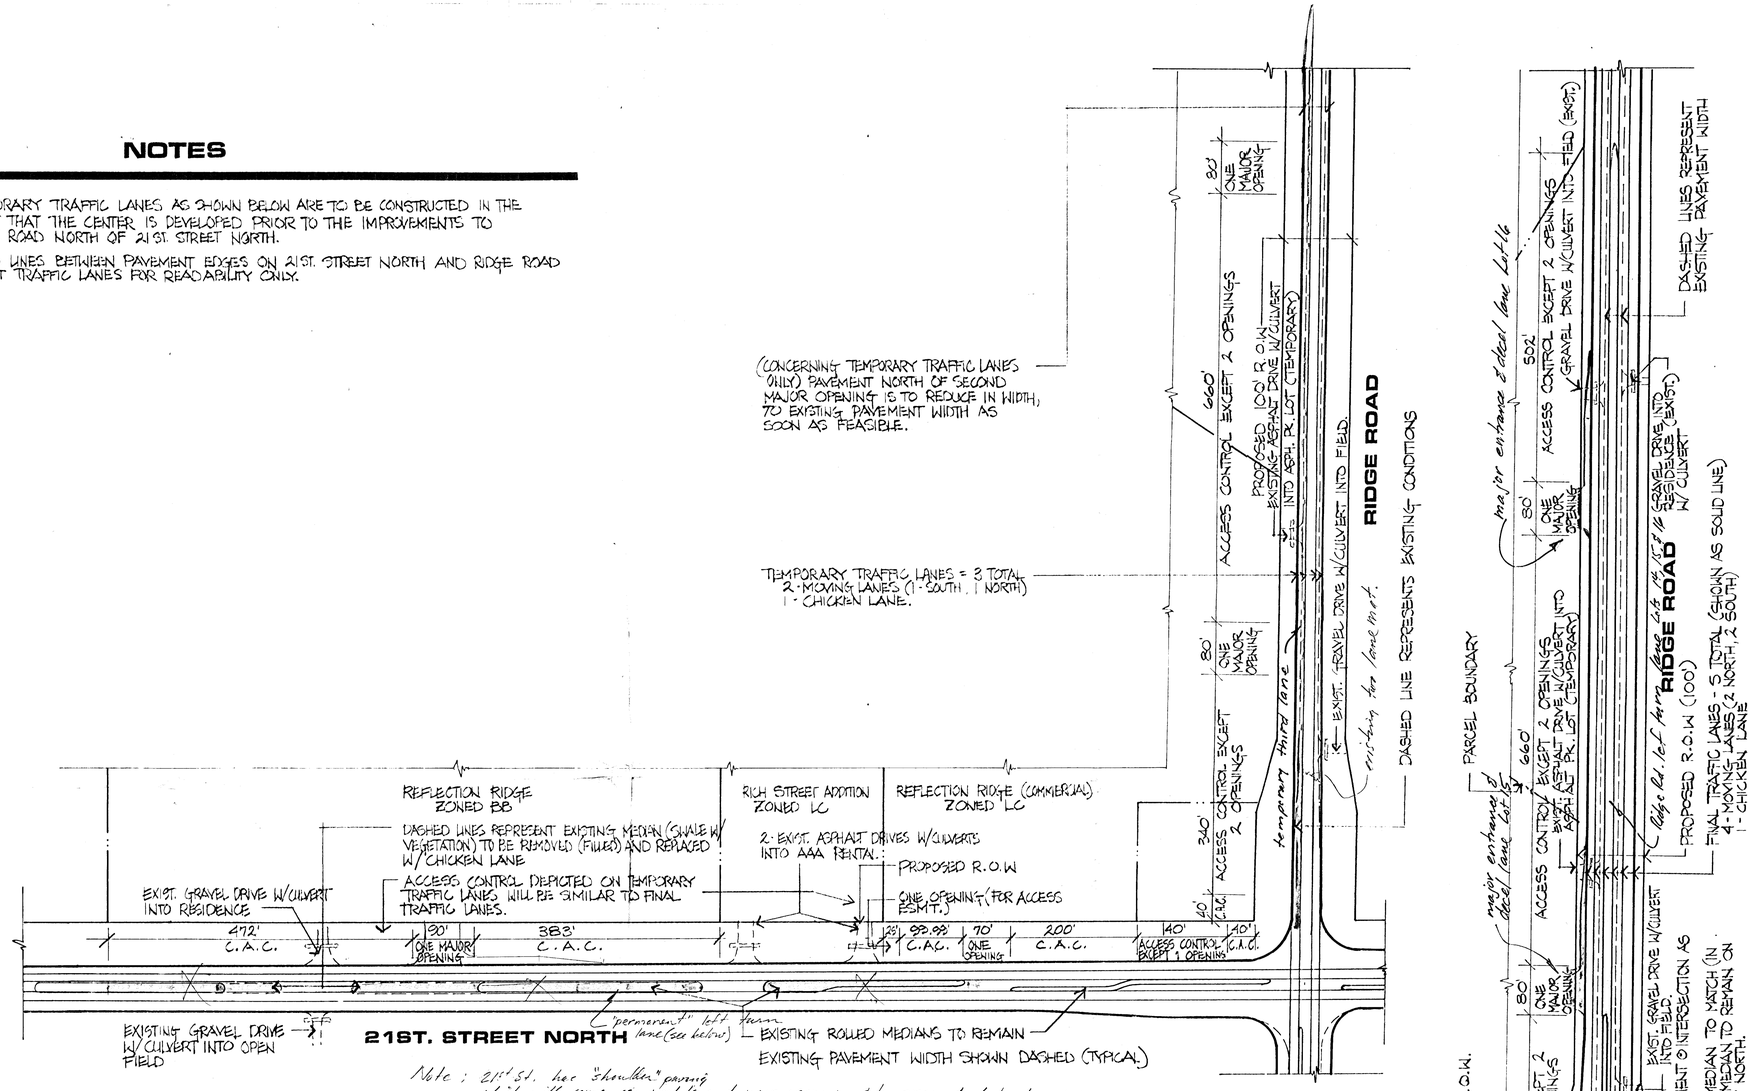

PLAN VIEW · TEMPORARY TRAFFIC LANES (PROPOSED)

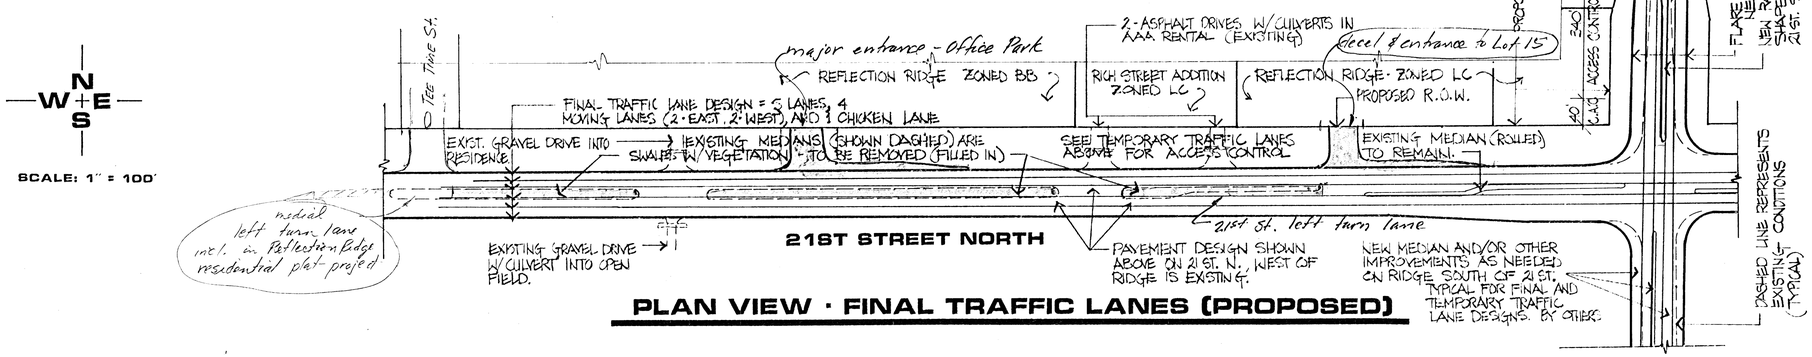

PLAN VIEW · FINAL TRAFFIC LANES (PROPOSED)

REFLECTION RIDGE COMMERCIAL TRAFFIC STUDY

OWNER: REFLECTION RIDGE INC. P.O. BOX 771069
WICHITA, KS. 67277 316-721-2153

BILL G. YUNG DESIGN
4912 E. 29TH STREET NORTH, WICHITA, KS 67220
316-683-5567

date	JULY 10, 1987
rev.	JULY 14, 1987
sheet title	COMMERCIAL TRAFFIC STUDES
project	REFLECTION RIDGE
sheet 1 of 1	