

SILVER SPUR Mobile Home Park

Section


CAREY

DB 1506 P 494

DEDICATED 6-17-70

LANE

548

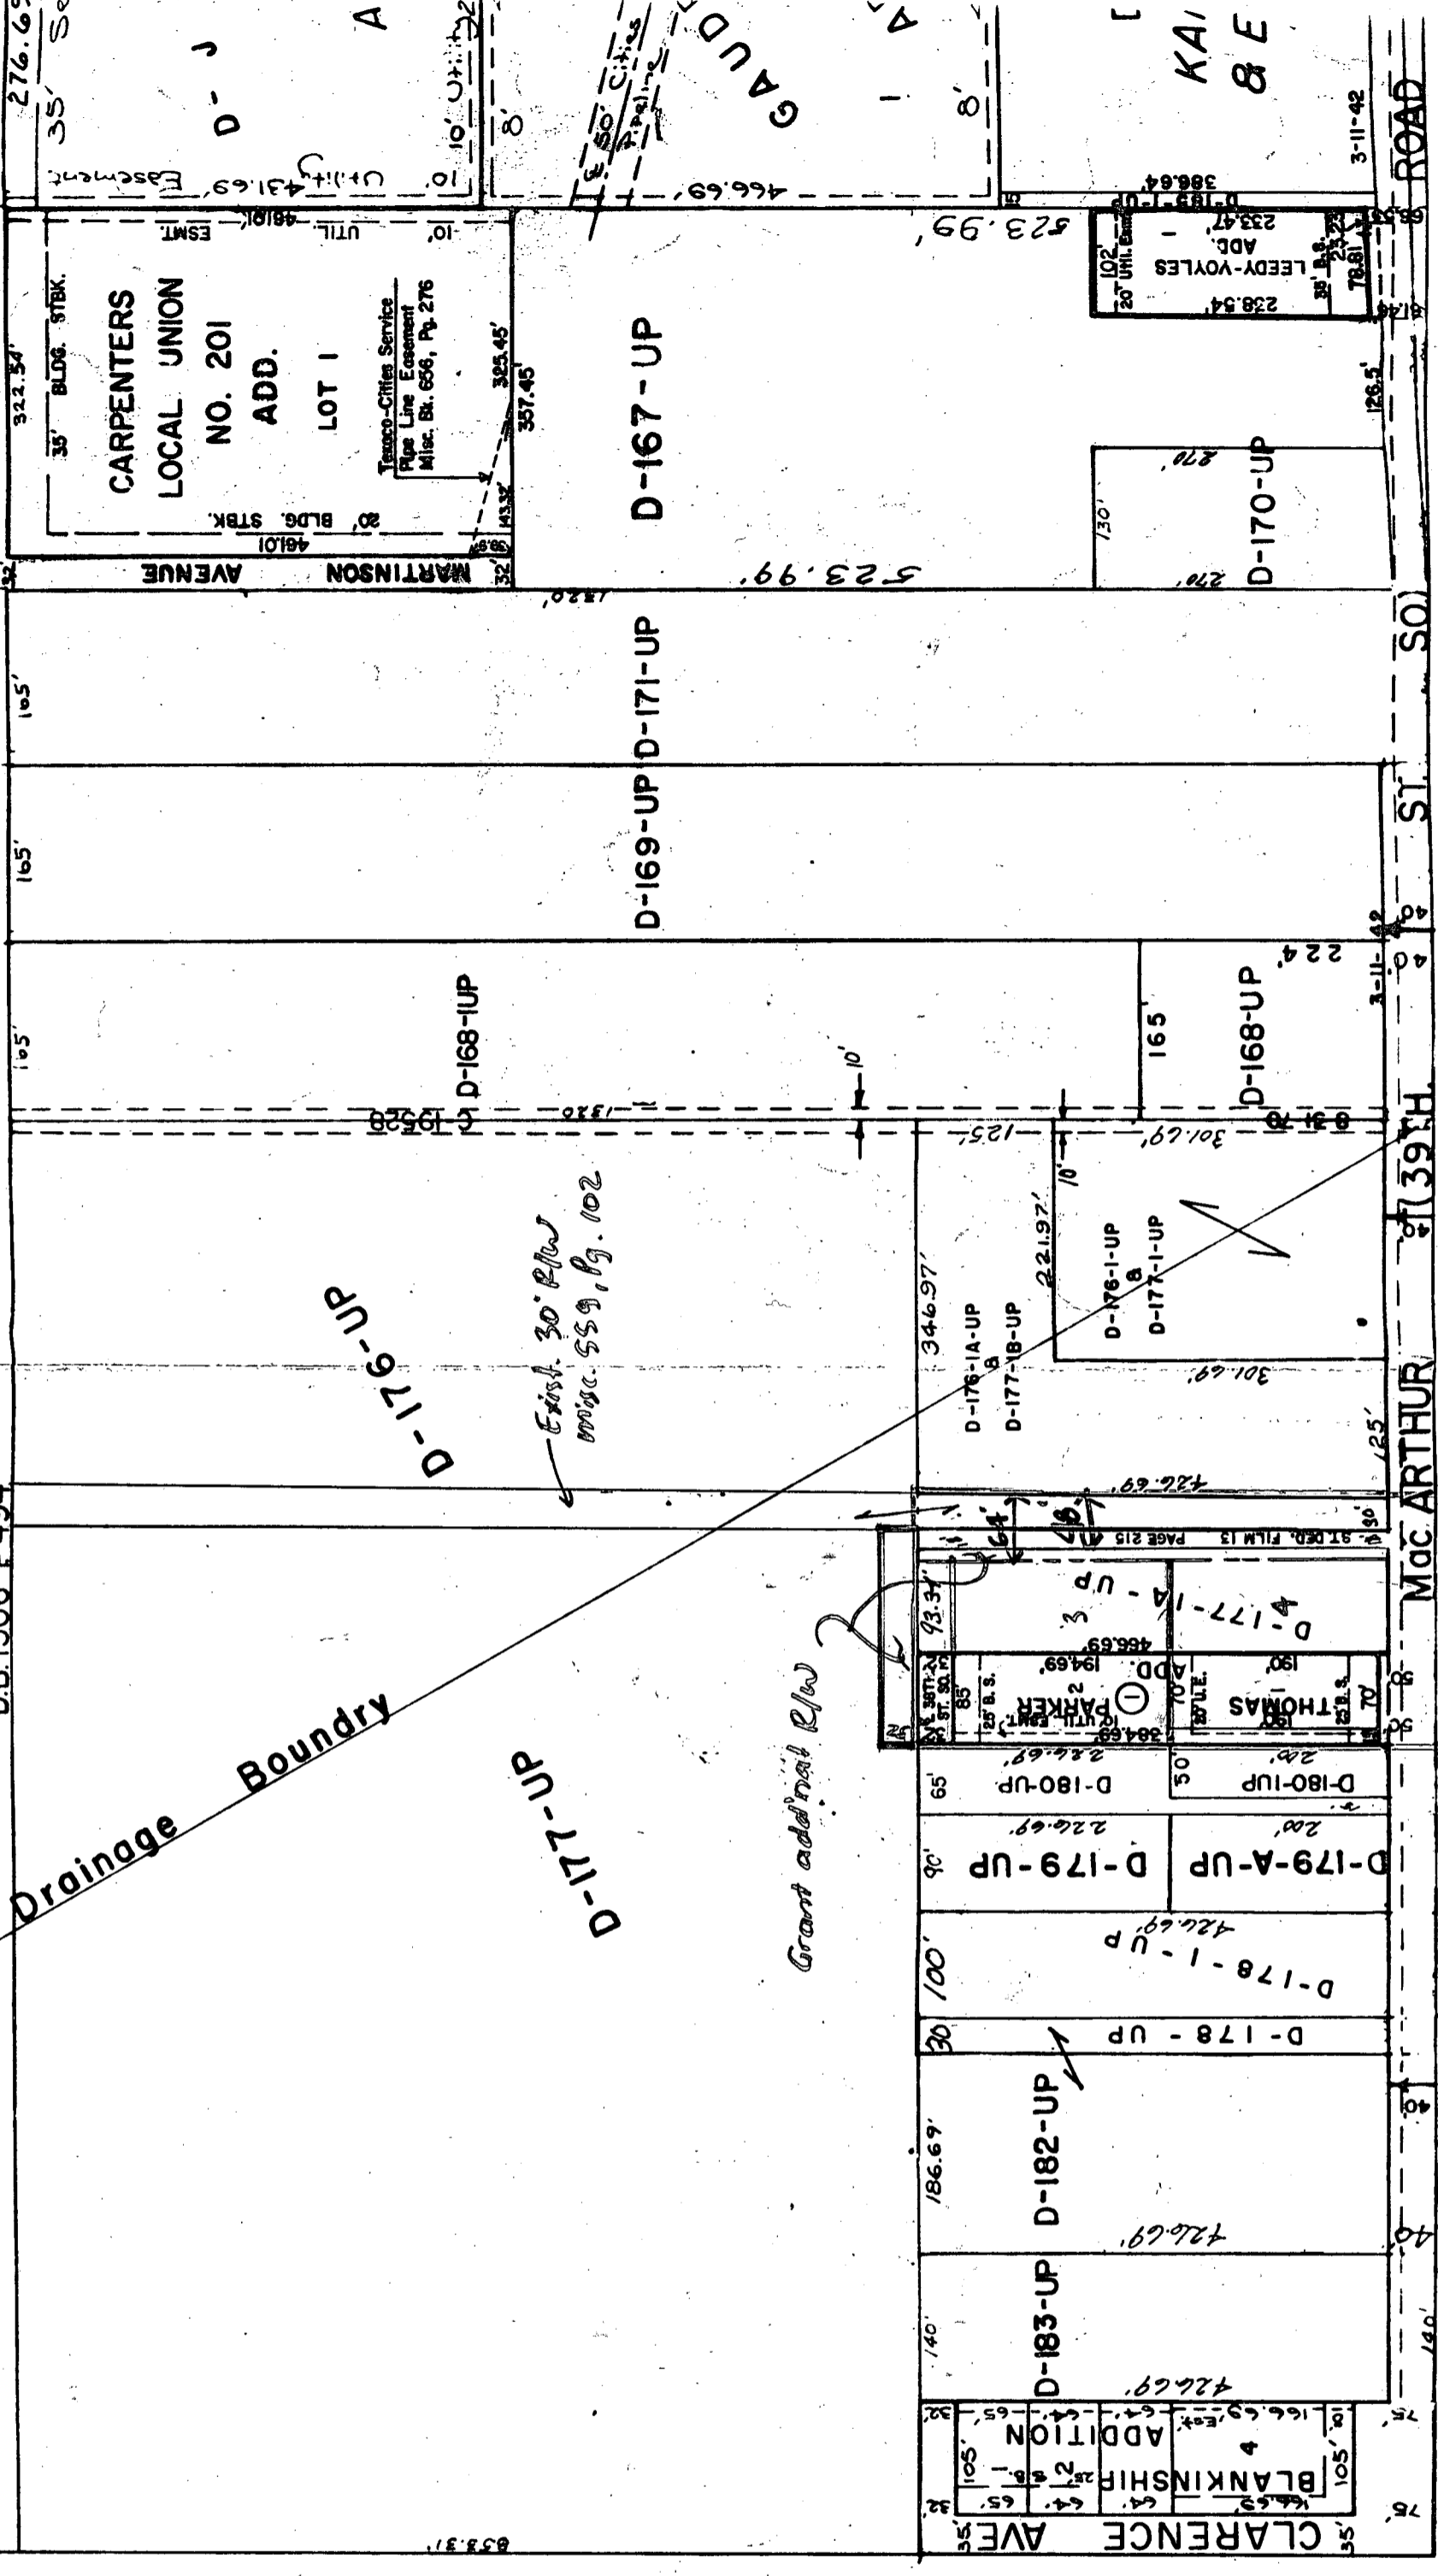

THIS SHEET PREPARED UNDER SUPERVISION
DON WRIGHT . SEDGWICK COUNTY

Proposed Boundary of Parker Add'n.

MAC ARTHUR ST 39TH SO. ROAD

3-11-42

126.5'

224'

301.69'

125'

140'

140'

