


Scale: 1" = 50'

UNPLATTED

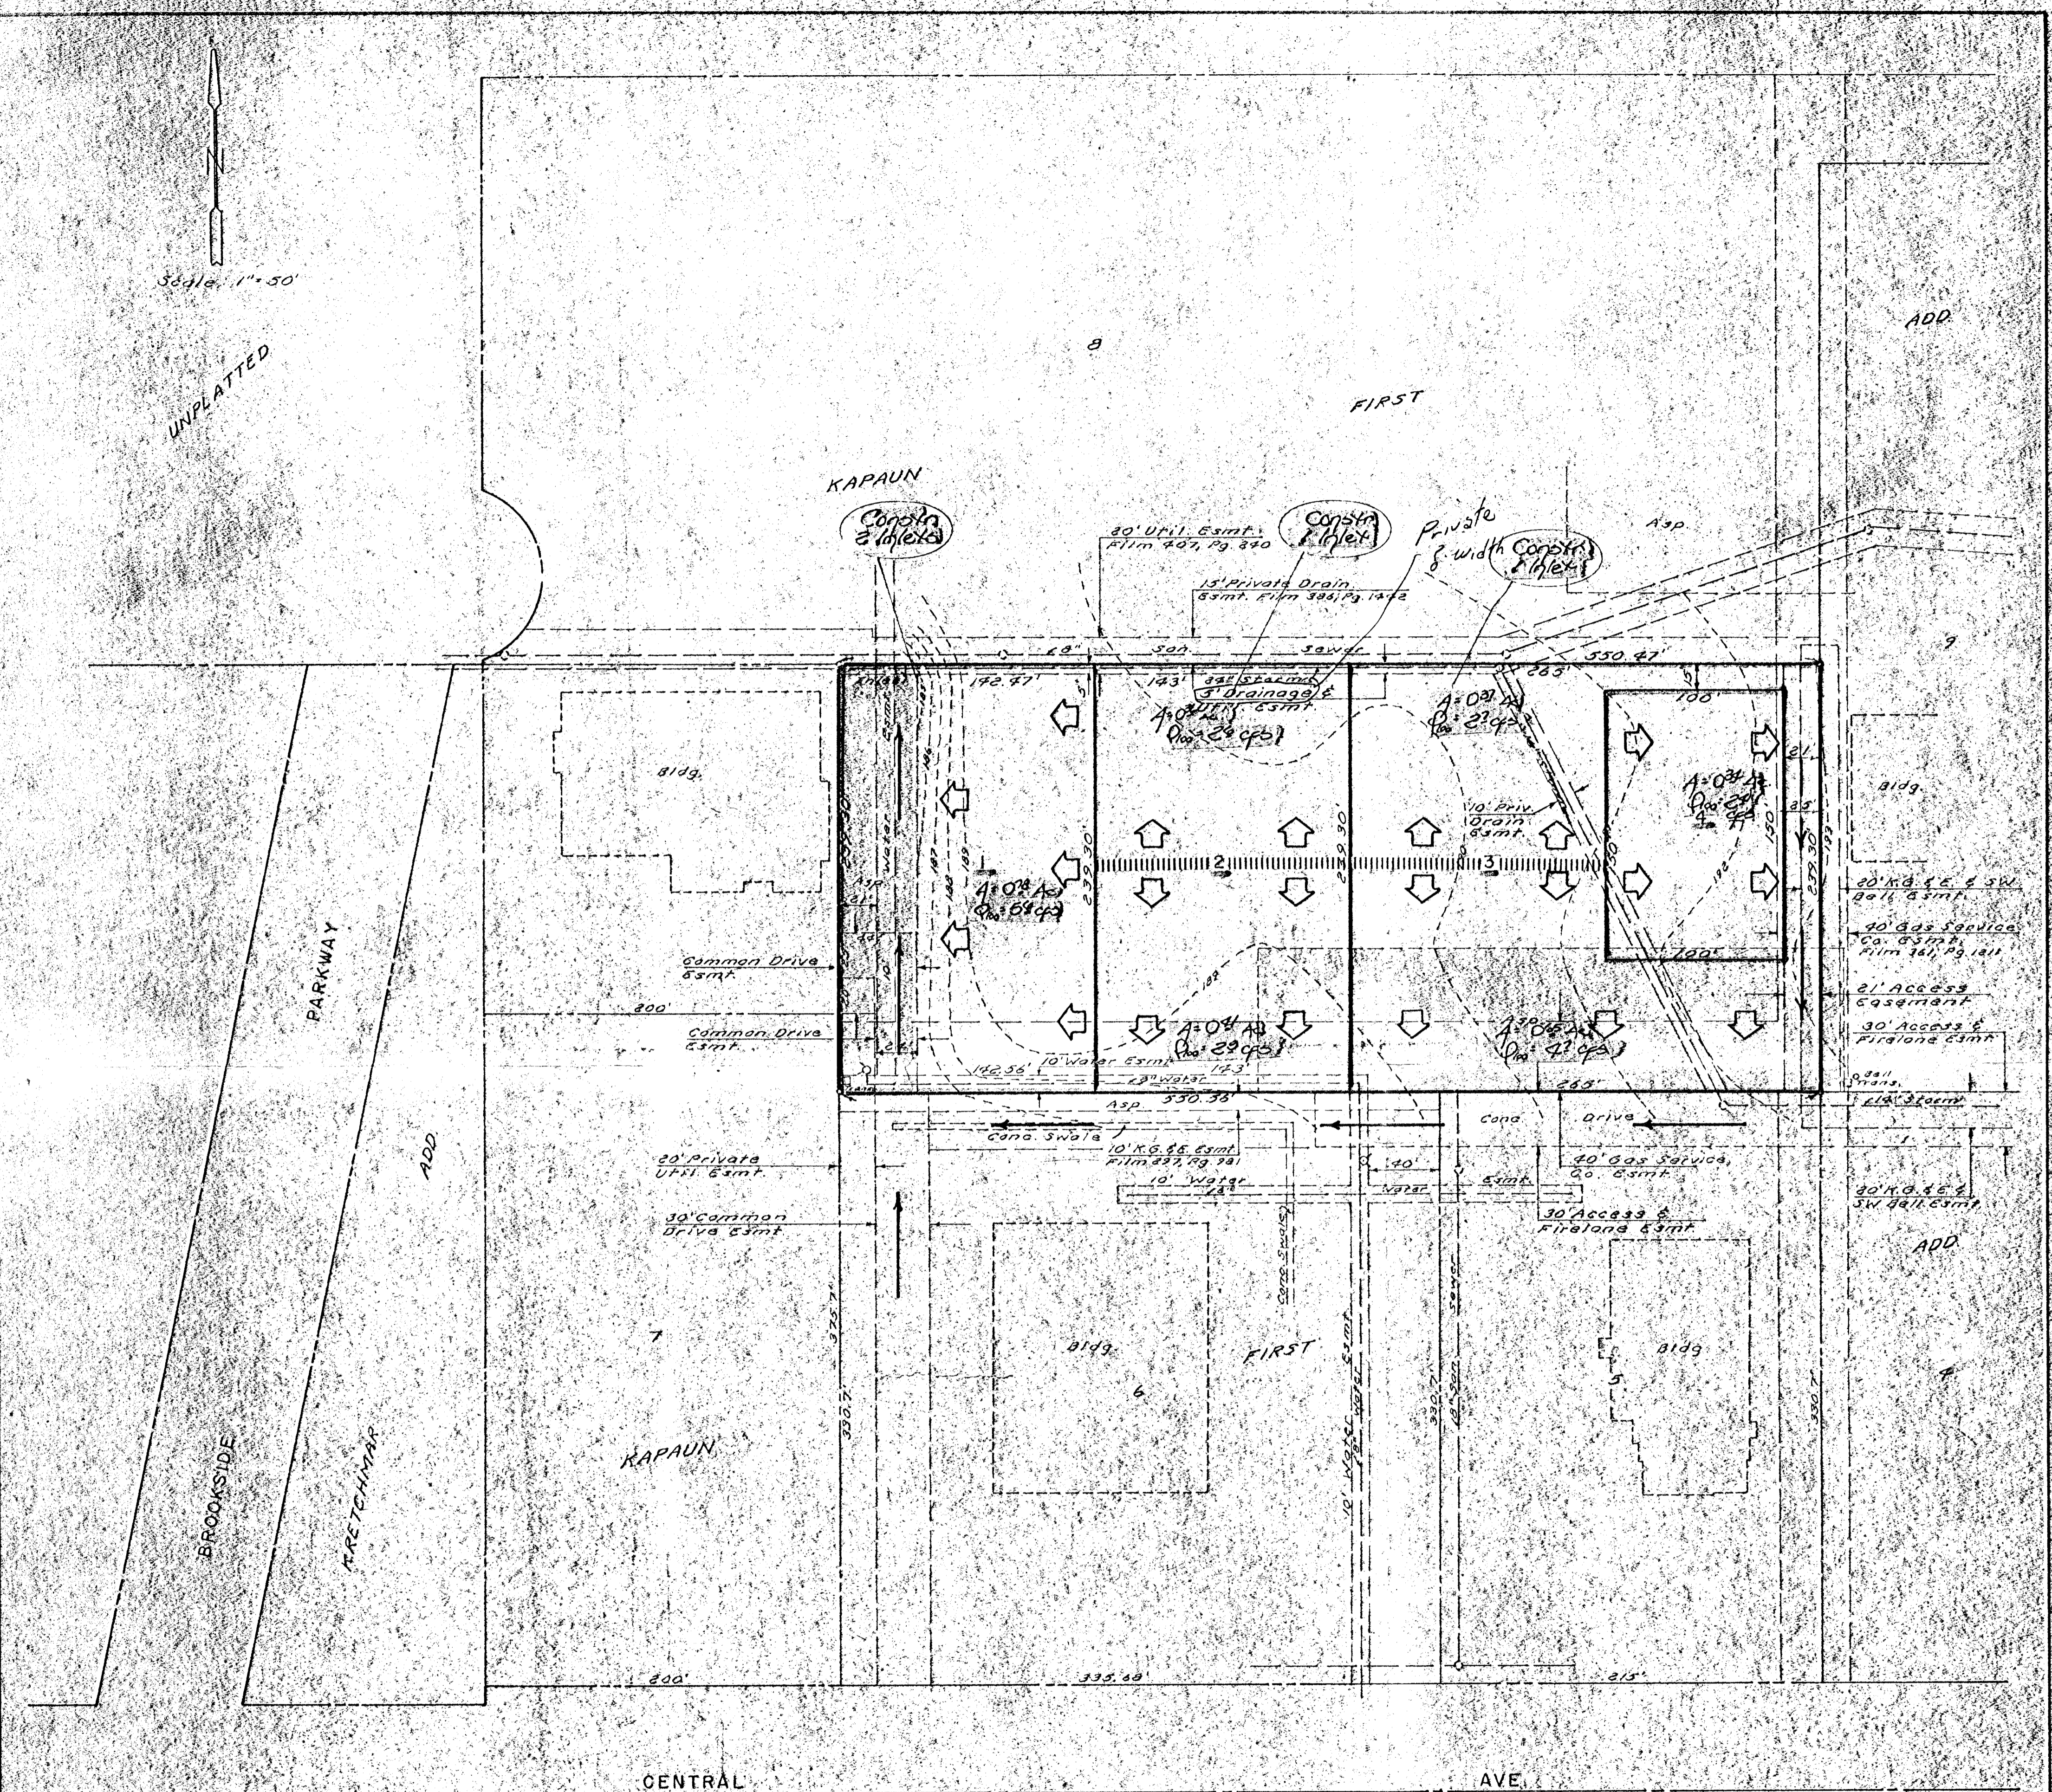

SKETCH PLAT

KAPAUN FOURTH ADDITION

A REPLAT OF PART OF LOT 6, KAPAUN FIRST ADDITION

—drainage plan—

AM. CITY 3130 24th & 56th St
Wichita, Kan 67214
8-17-82

Aug. 2, 1982
BAUGHMAN COMPANY, P.A.
 SURVEYING & ENGINEERING
 316 23rd St. • 330 LAURA • WICHITA, KANSAS 67211