TERRA TECH
LAND SURVEYING INC.
245 West Dewey
Wichita, Kansas 67202-3607
(316) 267-0744 / 267-2348
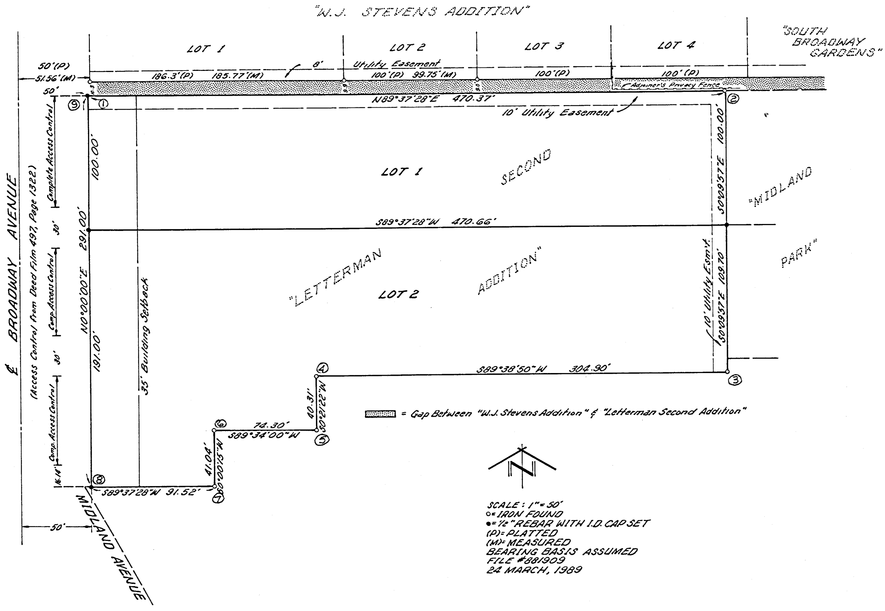
Closure Comps.