



Help pay for paving Tyler & attempt to secure petition

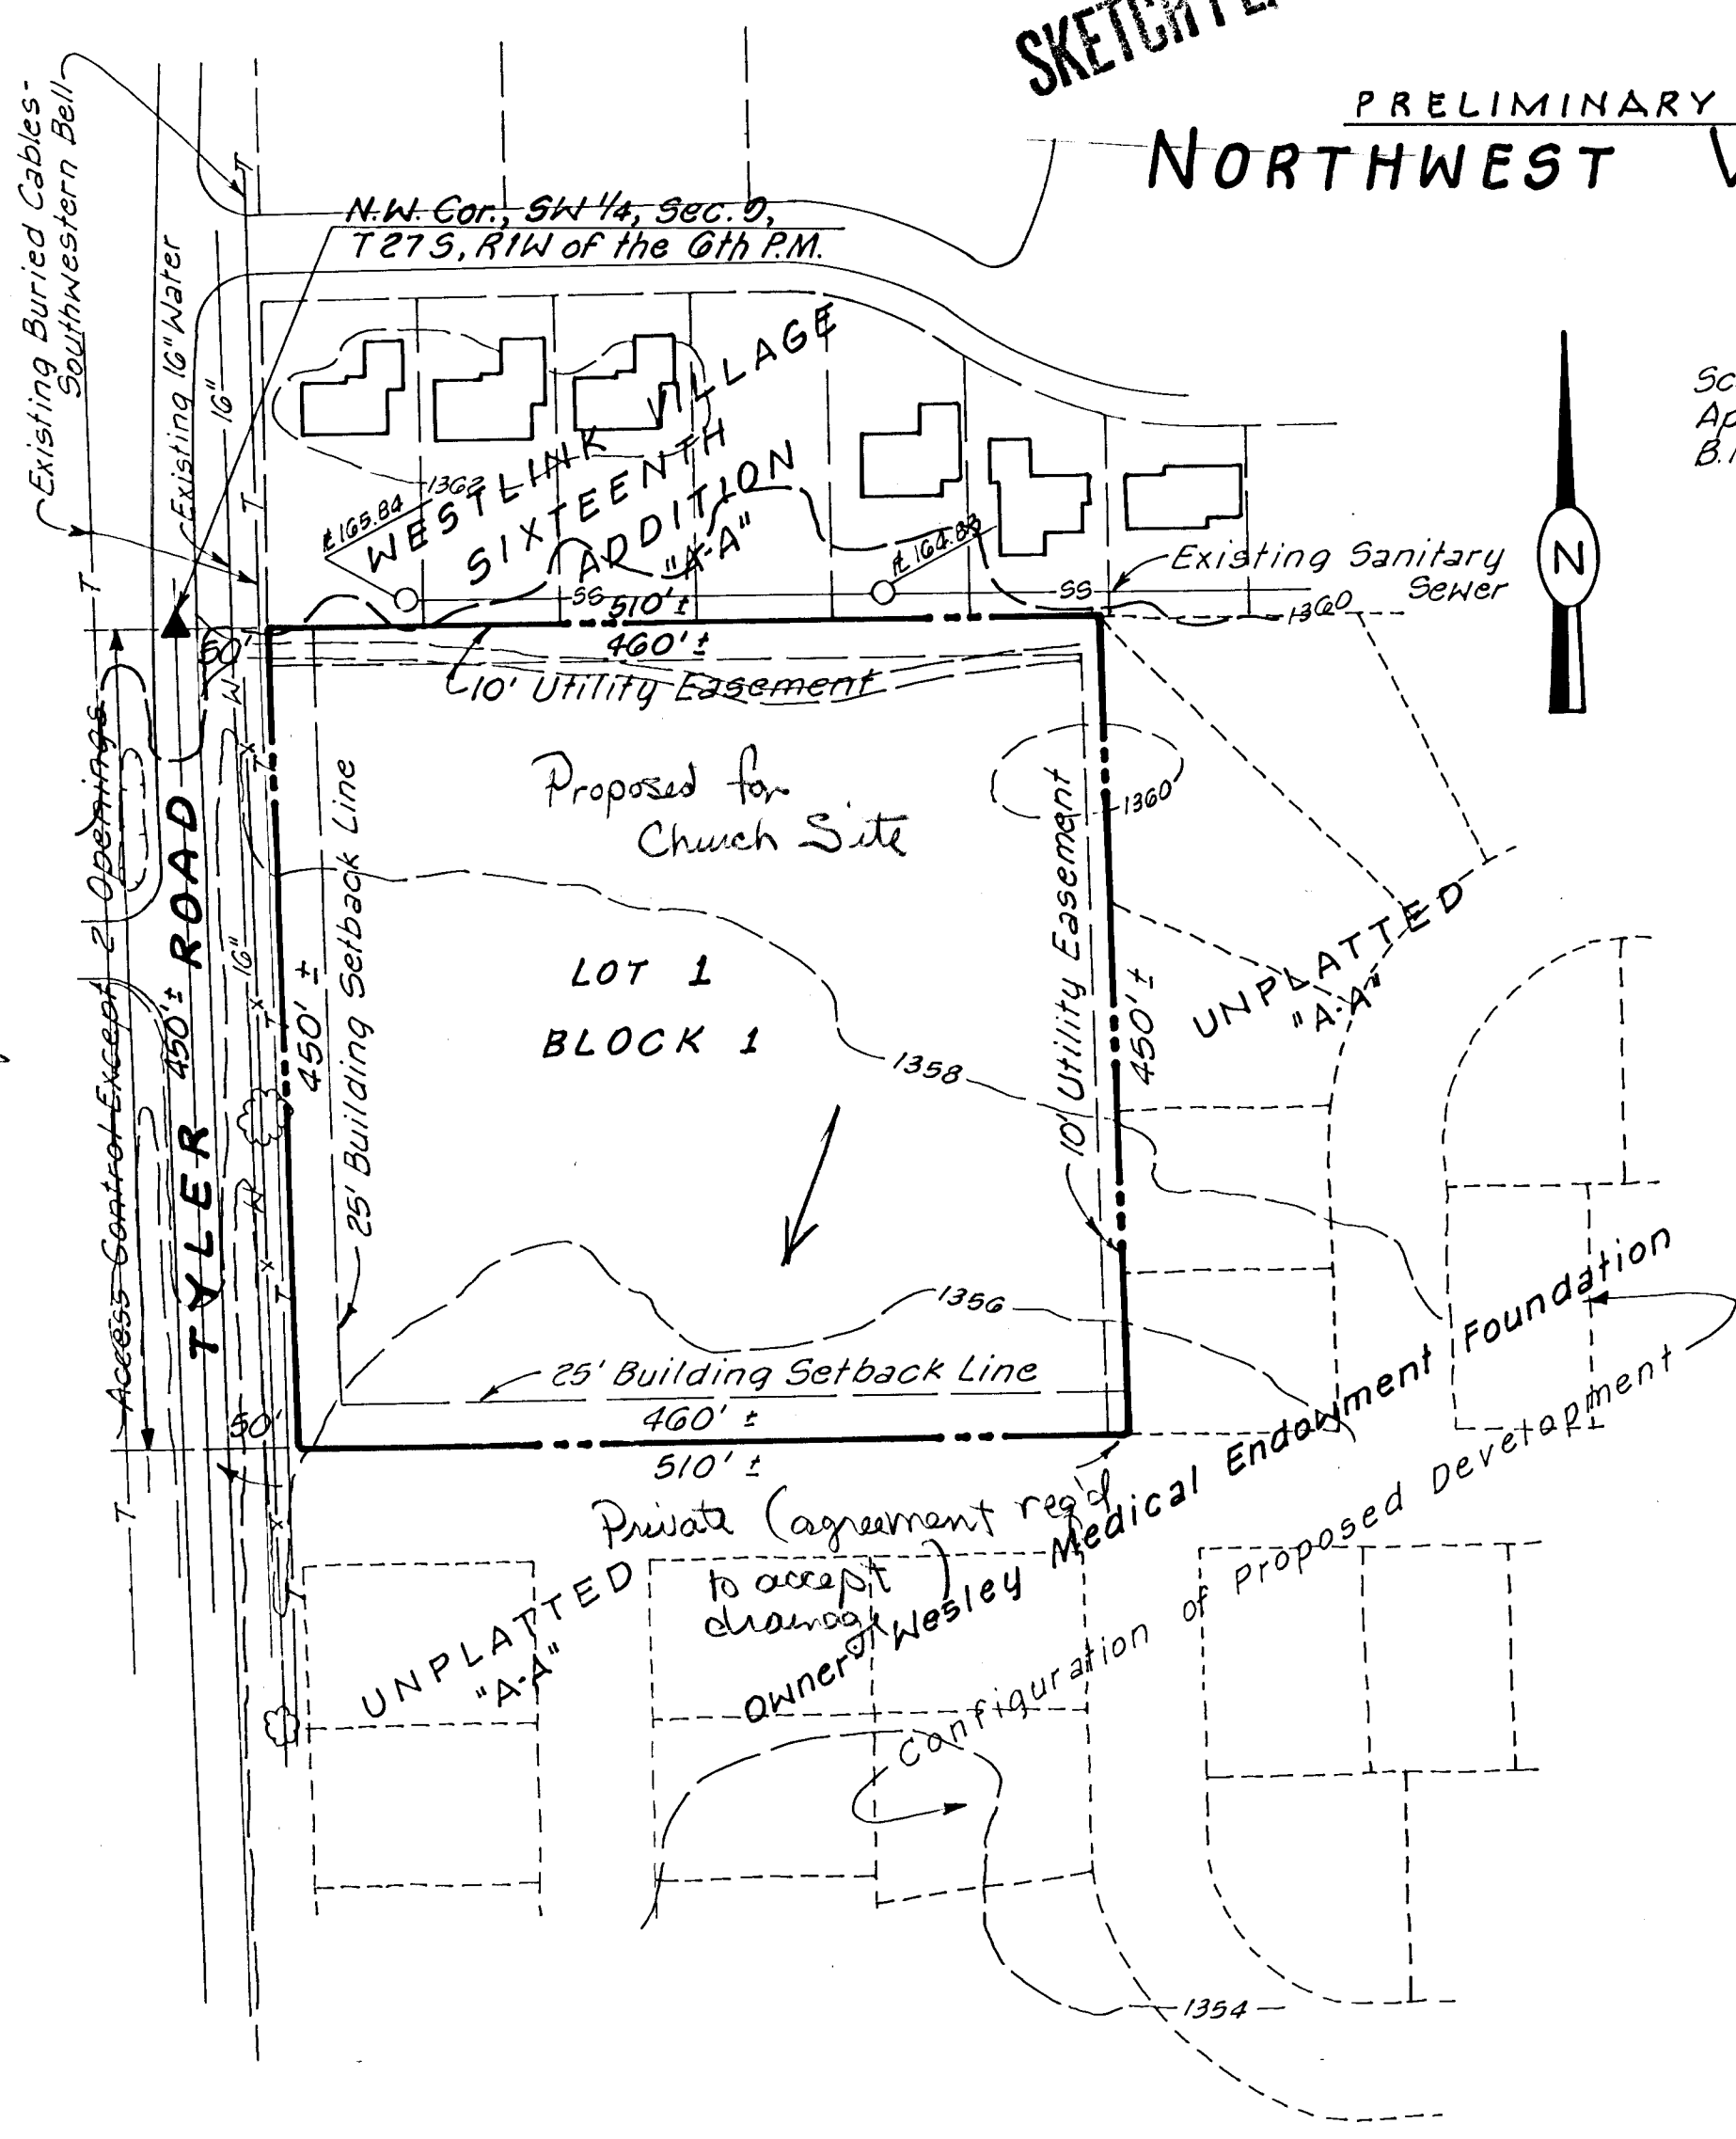

SKETCH PLAT

PRELIMINARY PLAT  
NORTHWEST VILLAGE 3RD ADDITION

Scale: 1"=100'  
April 9, 1981  
B.M. - City Std. Disc @ Tyler & 17th -  
36'E & 31'S. & Both.  
El. 172.48 (City Datum)  
1350.88 (MSL)

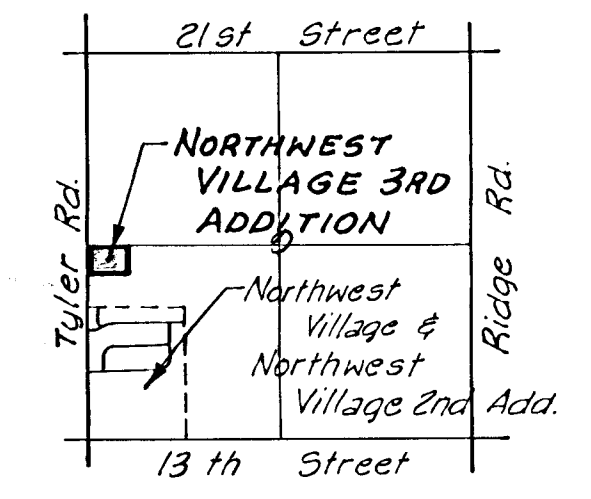

Engineer: Professional Engineering Consultants, P.A.  
1440 E. English  
Wichita, Kansas 67211

Note: All utilities available

Northwest Village  
3rd Addn.