

SCALE: 1" = 100'
 B.M. - City B.M. disc 52' S. & 44' W. of
 intersection of Ridge Rd. & Central (2'
 deep in A.C. drive) Elev. 131.597
 Date of Topo. - Dec. 1968

PRELIMINARY
 Alternate 3: Drainage Plan and Preliminary Cost Estimate for
 Farmington Square, Country Acres 6th, and Meadow
 View Estates.

Pipe	Quantity	Unit Price	Total
60"	200'	@ \$60/ft.	\$12,000
54"	2,360'	@ \$55/ft.	133,840
42"	1,100'	@ \$42/ft.	46,800
48"	350'	@ \$48/ft.	16,800
36"	600'	@ \$36/ft.	21,600
24"	1,300'	@ \$27/ft.	35,100
21"	300'	@ \$27/ft.	8,100
18"	550'	@ \$21/ft.	11,550
15"	990'	@ \$18/ft.	17,820
12"	700'	@ \$15/ft.	10,500
			\$675,100

Inlets, Collectors & Manholes		
24 Combinations @ \$5,000 ea.	=	\$120,000
Junctures		
3 Junctures @ \$3,500 ea.	=	10,500
Impact Basins & Channel Work		
2 Structures		25,000
		\$519,310
102 Miscellaneous		51,930
208 Engineering, Inspection, Etc.		103,860
Preliminary Cost Total		\$675,100

3B \$685,000 ±

* DRAINAGE AREA = 40.9 ACRES
 ** DRAINAGE AREA = 98.4 ACRES (INCLUDES 52.3 ACRES WEST
 OF RIDGE ROAD)


ALTERNATE 3

DRAINAGE PLAN of

FARMINGTON SQUARE

Best layout - still requires a lot
 of fill & drain as shown

Engineer: P.E.C.
 1440 E. English
 Wichita, Kansas

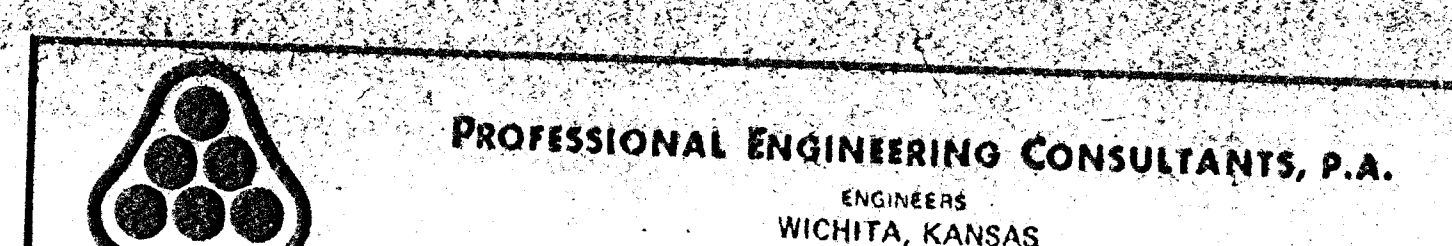

UNPLATTED
 "AA"
 L.C. INVESTMENT INC.