


KEY

- 1. 100' Flow Path
- 2. 100' Flow Path
Scale: 1"=100'

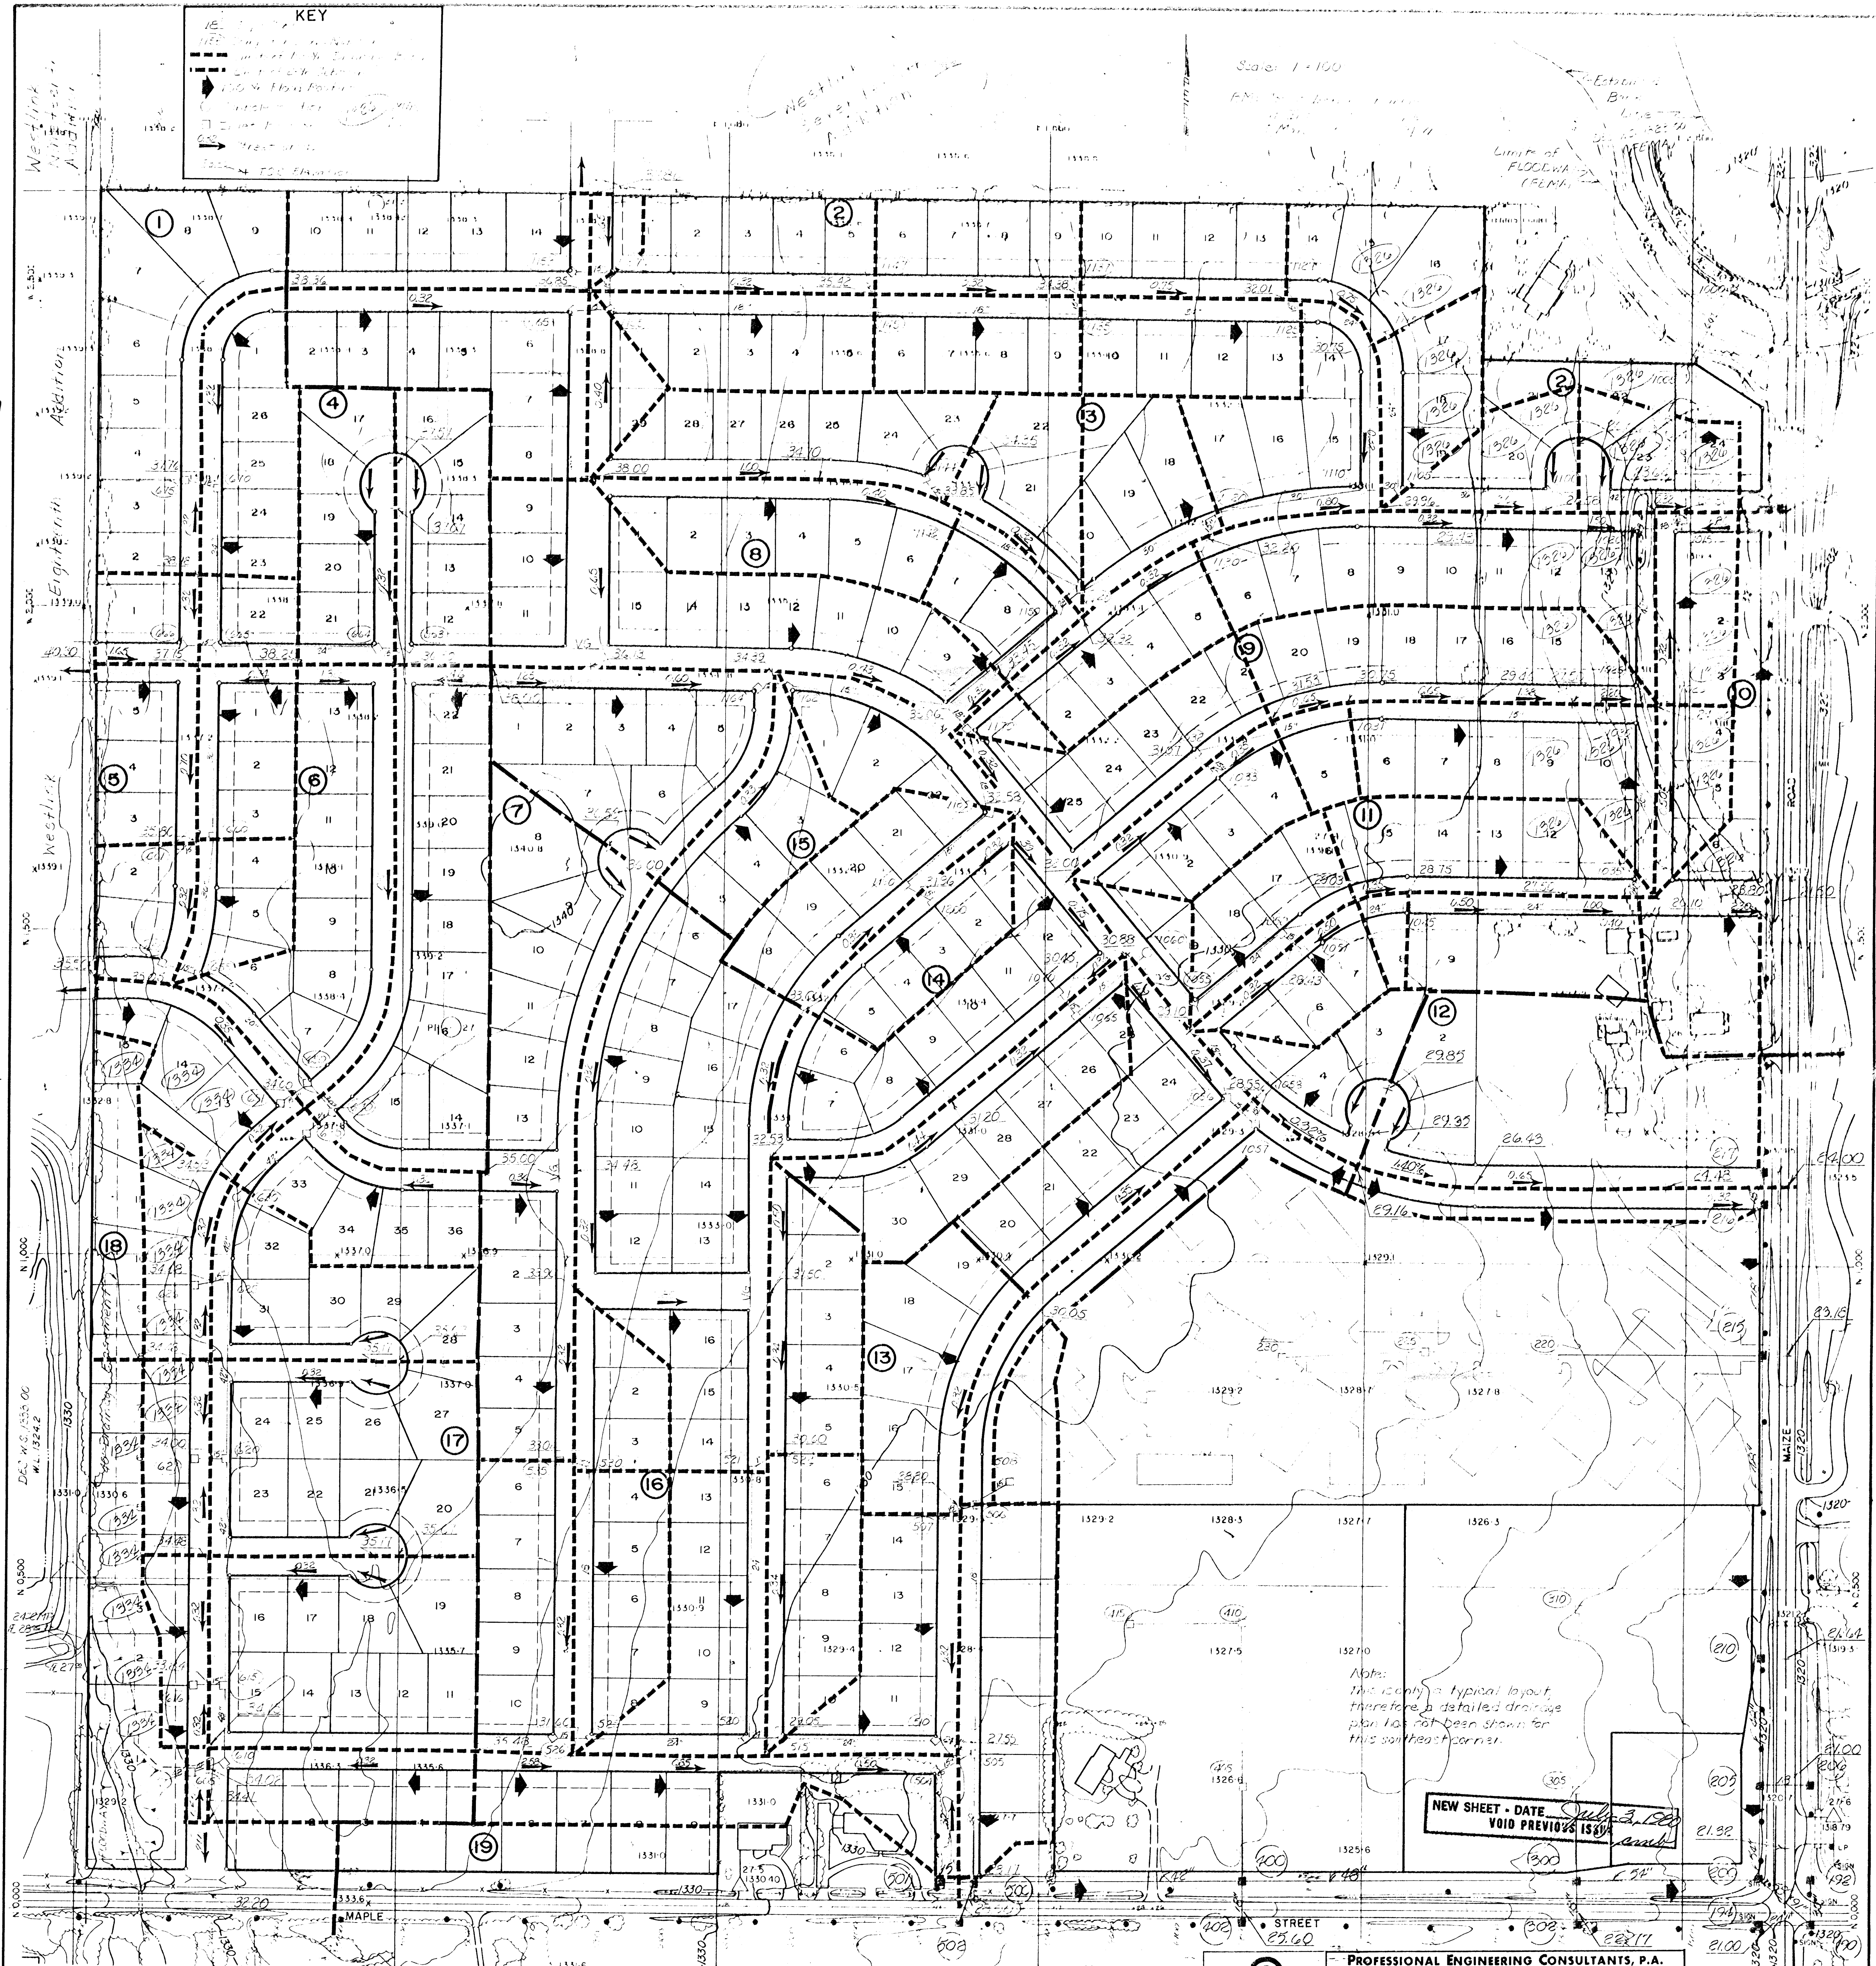


Note:
This is only a typical layout,
therefore a detailed drainage
plan has not been shown for
this southeast corner.

NEW SHEET - DATE July 3, 1980
VOID PREVIOUS 1980

OAK CLIFF DRAINAGE PLAN

- Revised 7-2-80 CMB
 1. Changed SW corner along Maple and Maize
 2. Added Min Pad Elevations
 3. Revised 100' Flow Routing

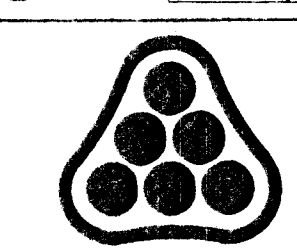

PROFESSIONAL ENGINEERING CONSULTANTS, P.A.
 ENGINEERS
 WICHITA, KANSAS

Designed by CMB/KJH Job No. 79283
 Drawn by KJH Date 5-26-80 Sh. 1 of 1

Note: See Plan & Profile of Maple for Details East of Maize Road

Oak Cliff Estates
 See Map to show this 150' Pad
 Received JUL 7 1980