

Boundary map 208 about 1/4 West of V. 187th St. as of 1/23/35
 DES WS 1333.00
 W.L. 727.77

DRAINAGE CONCEPT

FEBRUARY 20, 1980

OAK CLIFF ESTATES


Drainage Concepts 2/24/80
 See notes dated 3/4/80 pertaining to same
 P.J.

Revised
 See submittal received
 July 7, 80
 SHEET INDEX

PREPARED BY
 MILES AIR PHOTO SURVEY
 PHOTOGRAMMETRIC SERVICES
 OVERSEAS, KANSAS 66209
 (913) 482-3550 FILE NO. M-19-K4

PREPARED FOR
 ALLIED LABORATORIES

TOPOGRAPHIC MAP OF LANDS LOCATED
 IN THE S.E. 1/4 OF SEC. 19
 T.27S. R.2W., SEDGWICK COUNTY, KANSAS

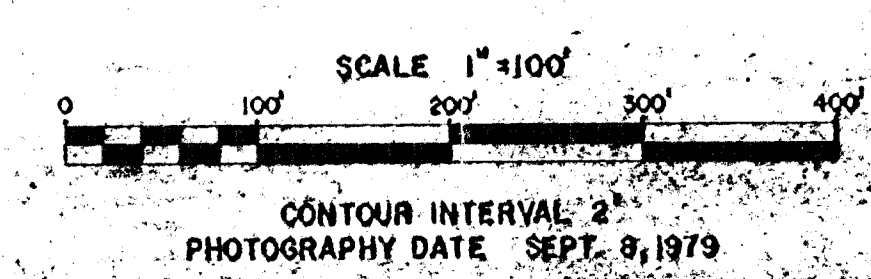

E	
D	
C	
B	
A	

 Oak Cliff Estates
 FEB 22 1980