


prev coll based upon DA of 122 Ac
 Q = 320 cfs
 another fig was 170 Ac DA = 0.6
 Q = 420 cfs L = 25.5"
 L = 400 ft @ 20'

SKETCH PLAT
OAK CLIFF ESTATES

PREPARED BY
 MILES AIR PHOTO SURVEY
 PHOTODIAGRAMMETRIC SERVICES
 DOWNEY, KANSAS 66248
 (913) 482-3550 FILE NO. M-19-K4

PREPARED FOR
 ALLIED LABORATORIES

TOPOGRAPHIC MAP OF LANDS LOCATED
 IN THE S.E. 1/4 OF SEC. 19
 T. 27 S. R. 2 W., SEDGWICK COUNTY, KANSAS

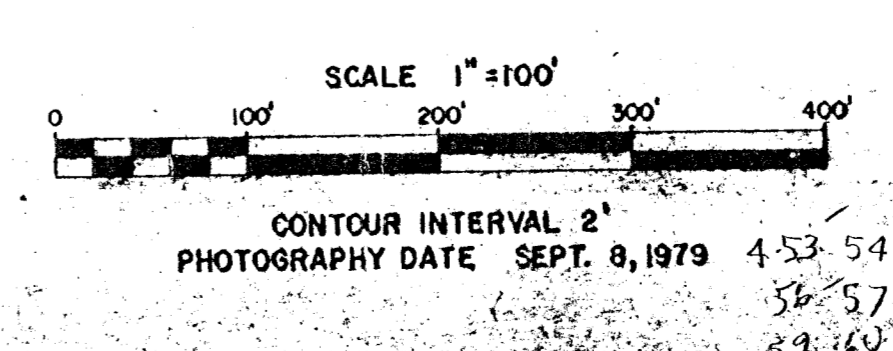

Oak Cliff Estates
 SHEET INDEX
 4 of 7

| | |
|---|--|
| E | |
| D | |

Revised JAN. 7, 1980

1. Rd layout does not agree with existing maps - house address that same has been inserted.
 20' easement @ 600' N @ Margt